



21+00

21+30

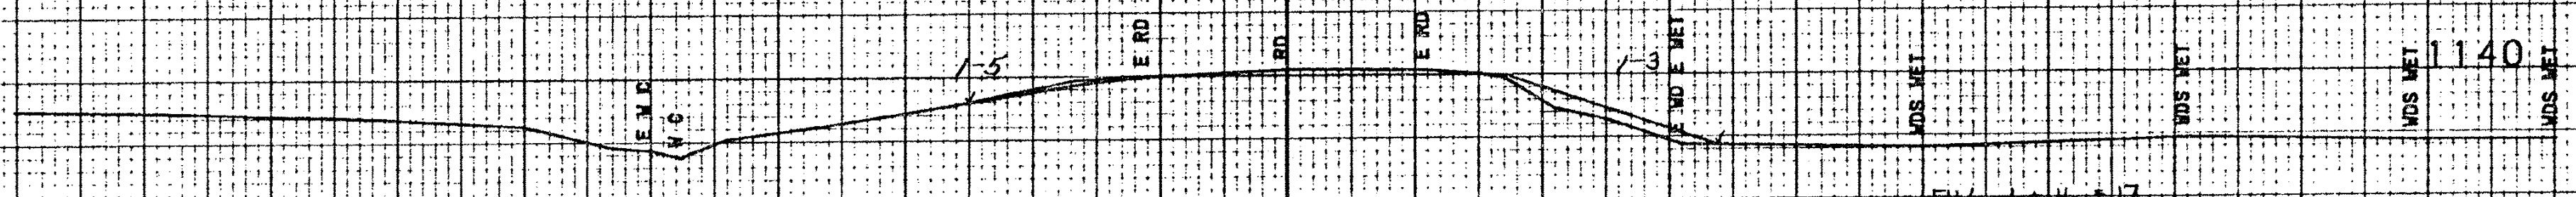


20+50

21+40

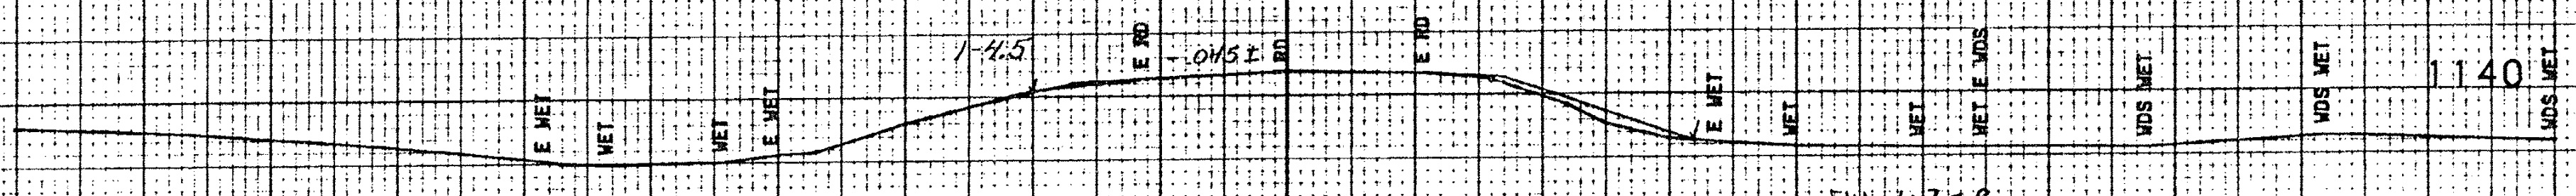

20+00


21+40

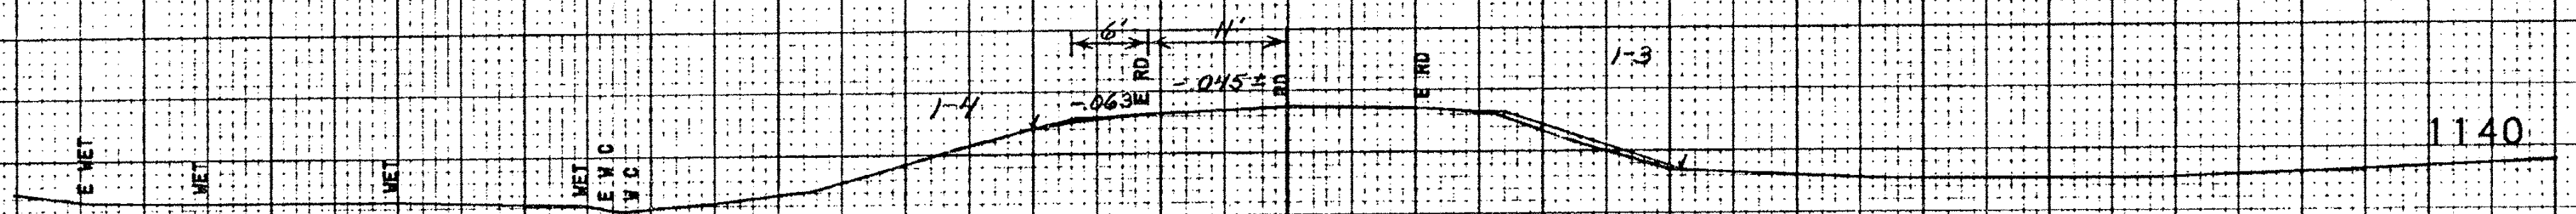

19+50

21+40

VH\*4 19+00 Lt. ~ 19+90 Lt.  
Shoulder Pavement Taper (6' to 0' Width) 1 1/4" Depth  
(1" in 15' Taper)  
Note: Continue 6" Gravel Shoulder to 22+75 Lt.  
Aggregate Shoulders, In Place.

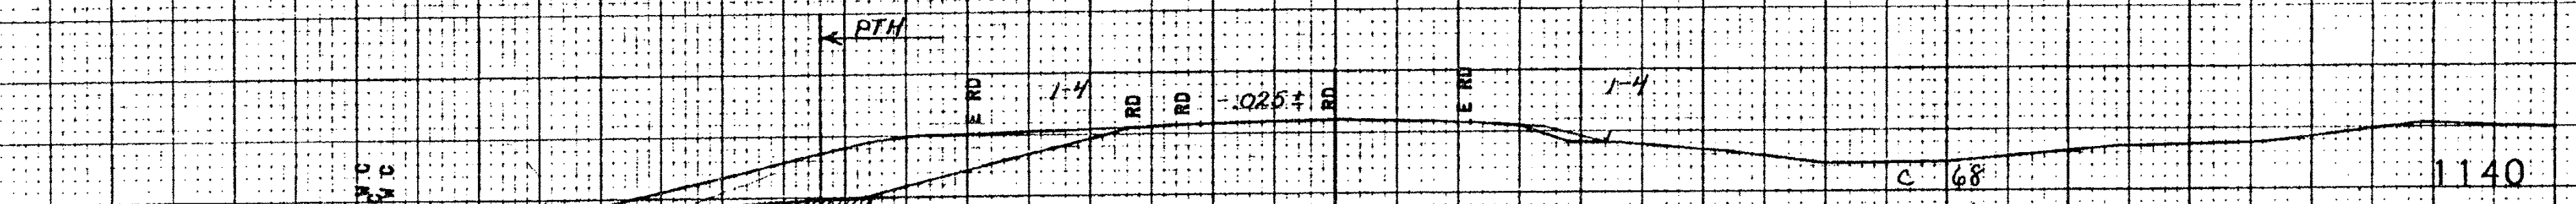

19+00

21+40

FROM STA.	19+00	TO STA.	21+00
PROJECT NAME	BERLIN DODGE RD		
NO.	M6200 (2) S	PLOTTED	10/08/87
SURVEYED BY	REED		09/87 0076
SHEET	77	OF	78 SHEETS

SCALE 1" = 10 FEET