


### Construction Approach Transition Detail

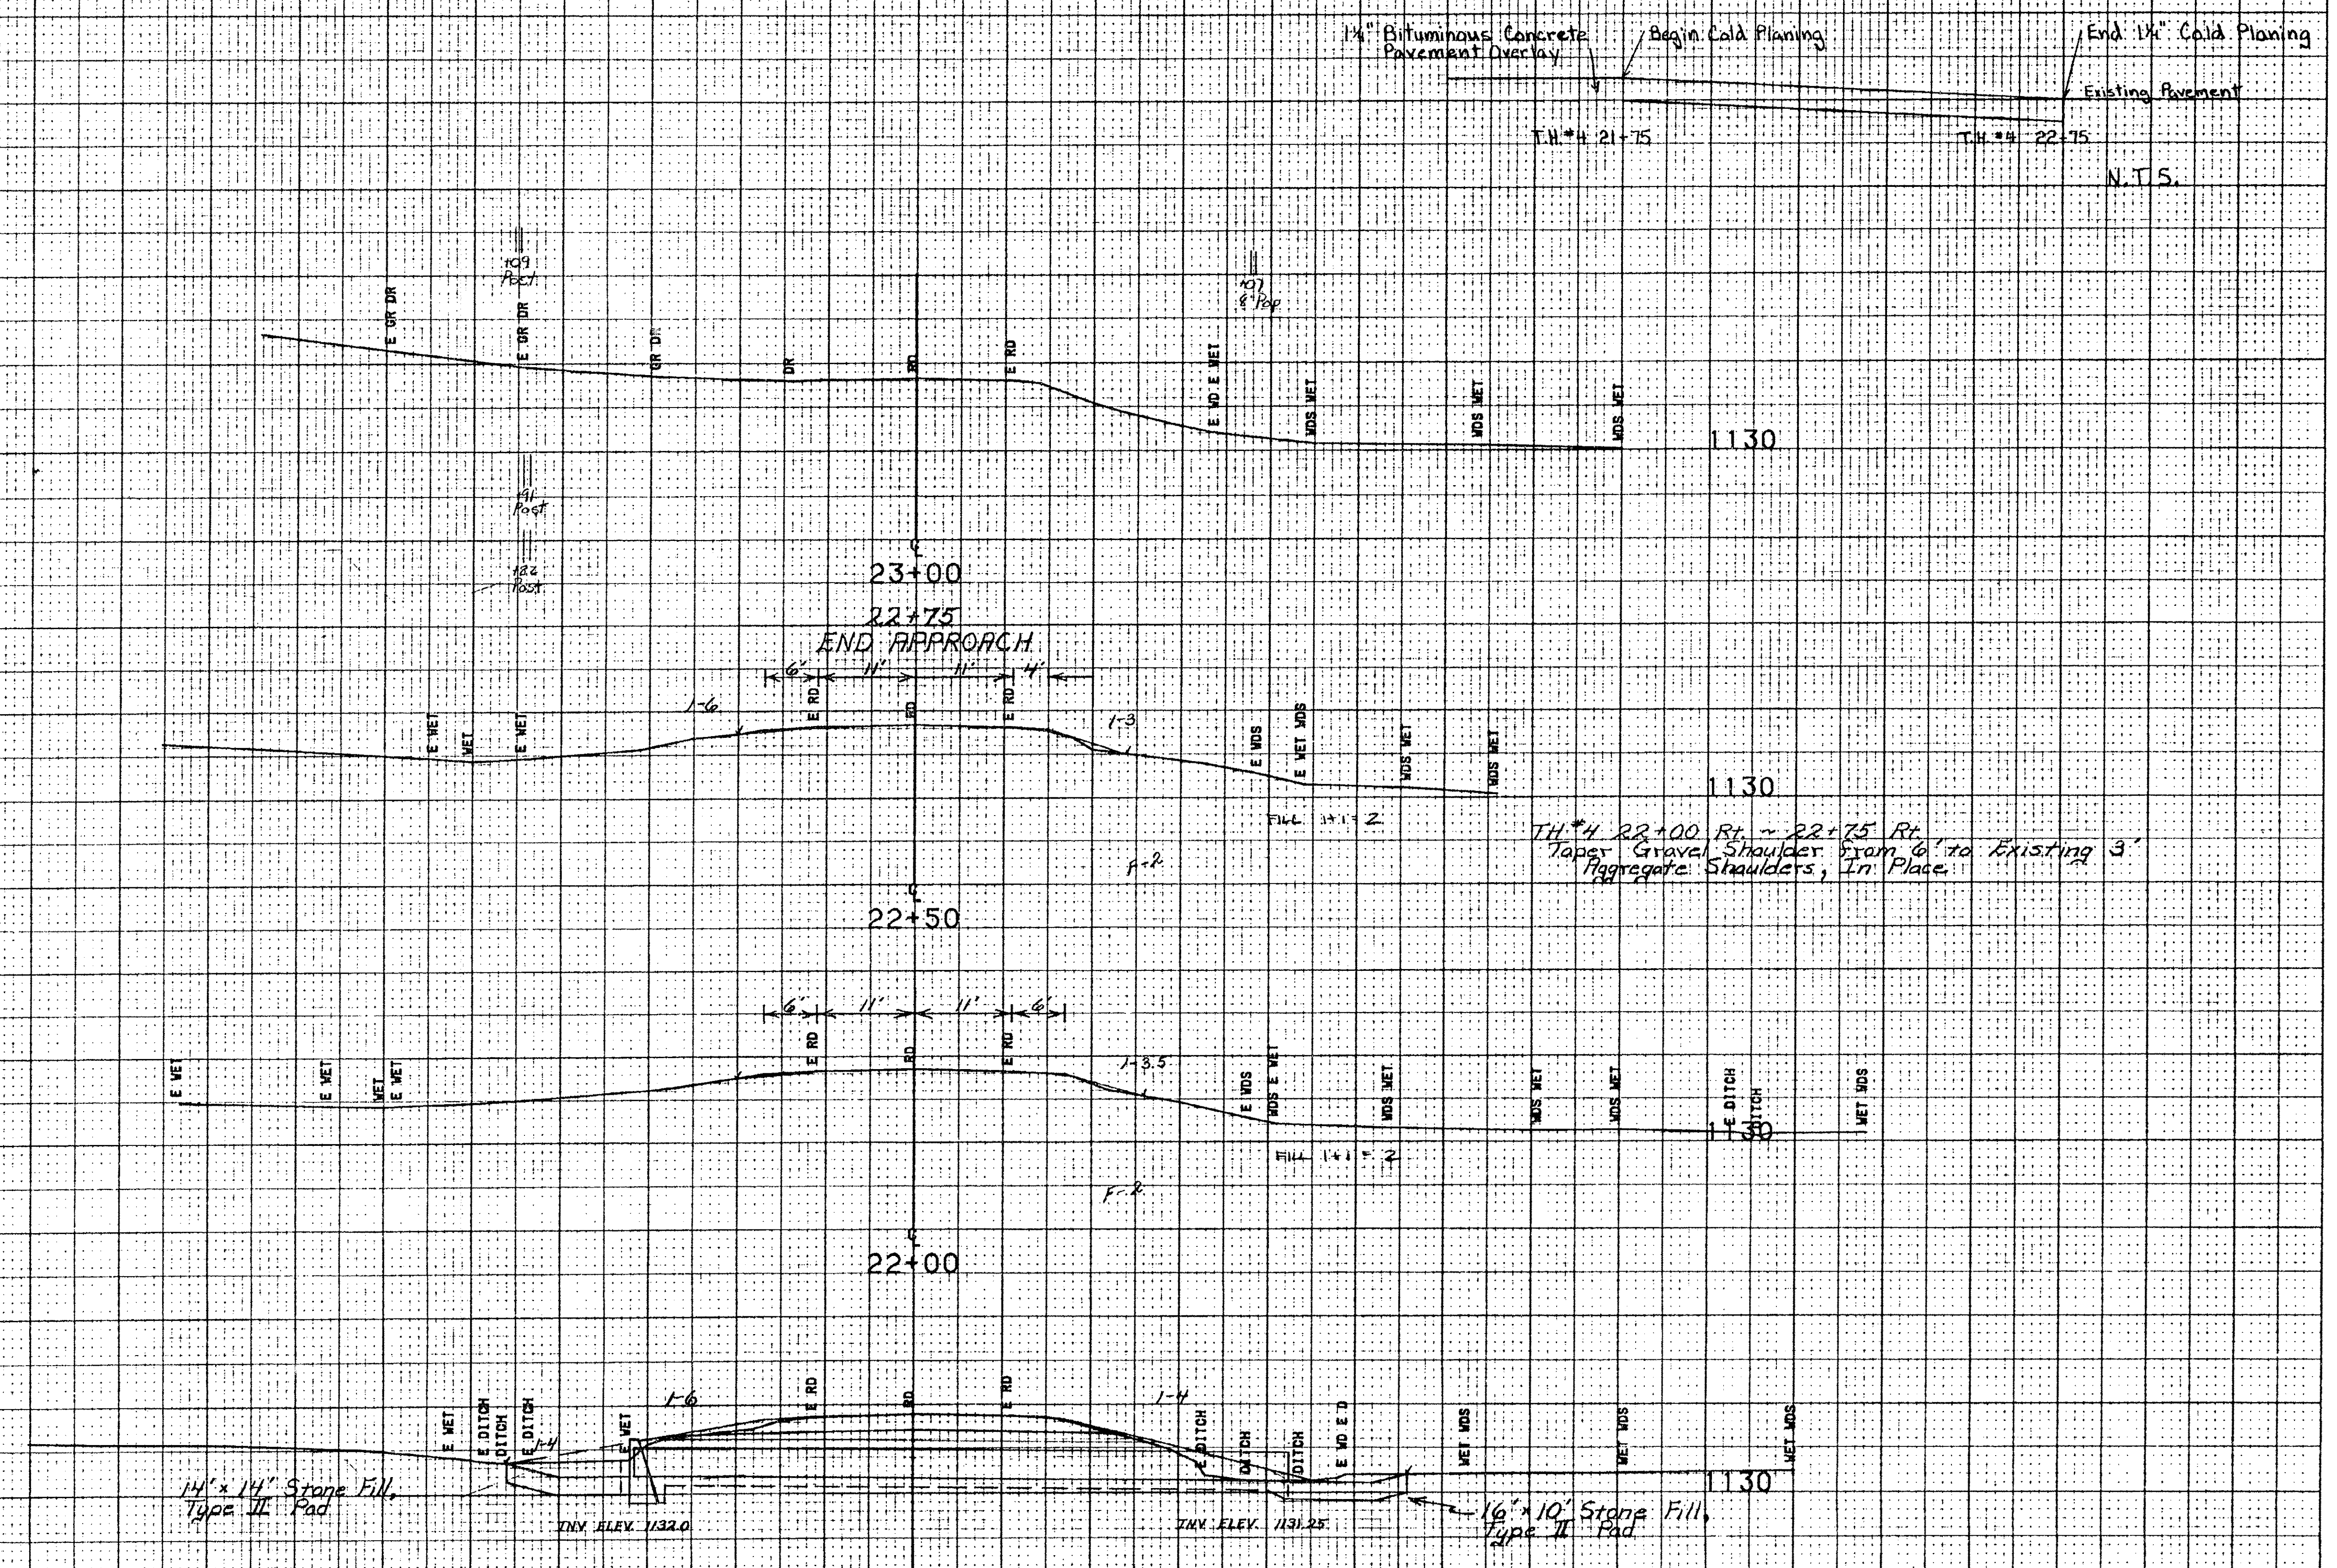

1 1/2" Bituminous Concrete Pavement Overlay  
 Begin Cold Planing  
 End: 1 1/2" Cold Planing  
 Existing Pavement  
 T.H. #4 21+75  
 T.H. #4 22+75  
 N.T.S.

TH #4 22+00 Rt. ~ 22+75 Rt.  
 Taper Gravel Shoulder from 6' to Existing 3'  
 Aggregate: Shoulders, In Place

14" x 14" Stone Fill,  
 Type II Pad

16" x 10" Stone Fill,  
 Type II Pad

Note: See Next Sheet For Construction And  
 Headwall Details.

TH #4 21+47 &  
 Existing 24" HCCGMP ~ Remove  
 New 57" x 38" x 14" PCCSRPA (PT) 109 or CAPP 135 Option 47 Straight Headwall  
 (Beveled) @ Inlet & Stone Fill, Type II Ditches @ Inlet & Outlet

FROM STA.	21+50	TO STA.	23+00
PROJECT NAME	BERLIN DODGE RD		
NO. MEGA	M6200 (2) S		
SURVEYED BY	REED	DATE	09/87 0076
SHEET	72	OF	78 SHEETS

SCALE 1" = 10 FEET