


Scale in Feet

TH#4 21+63±
End Excavation for
New Culvert

TH#4 21+30.5±
Begin Excavation for
New Culvert

Note: Fill shall be select material from
Pipe Excavation area.

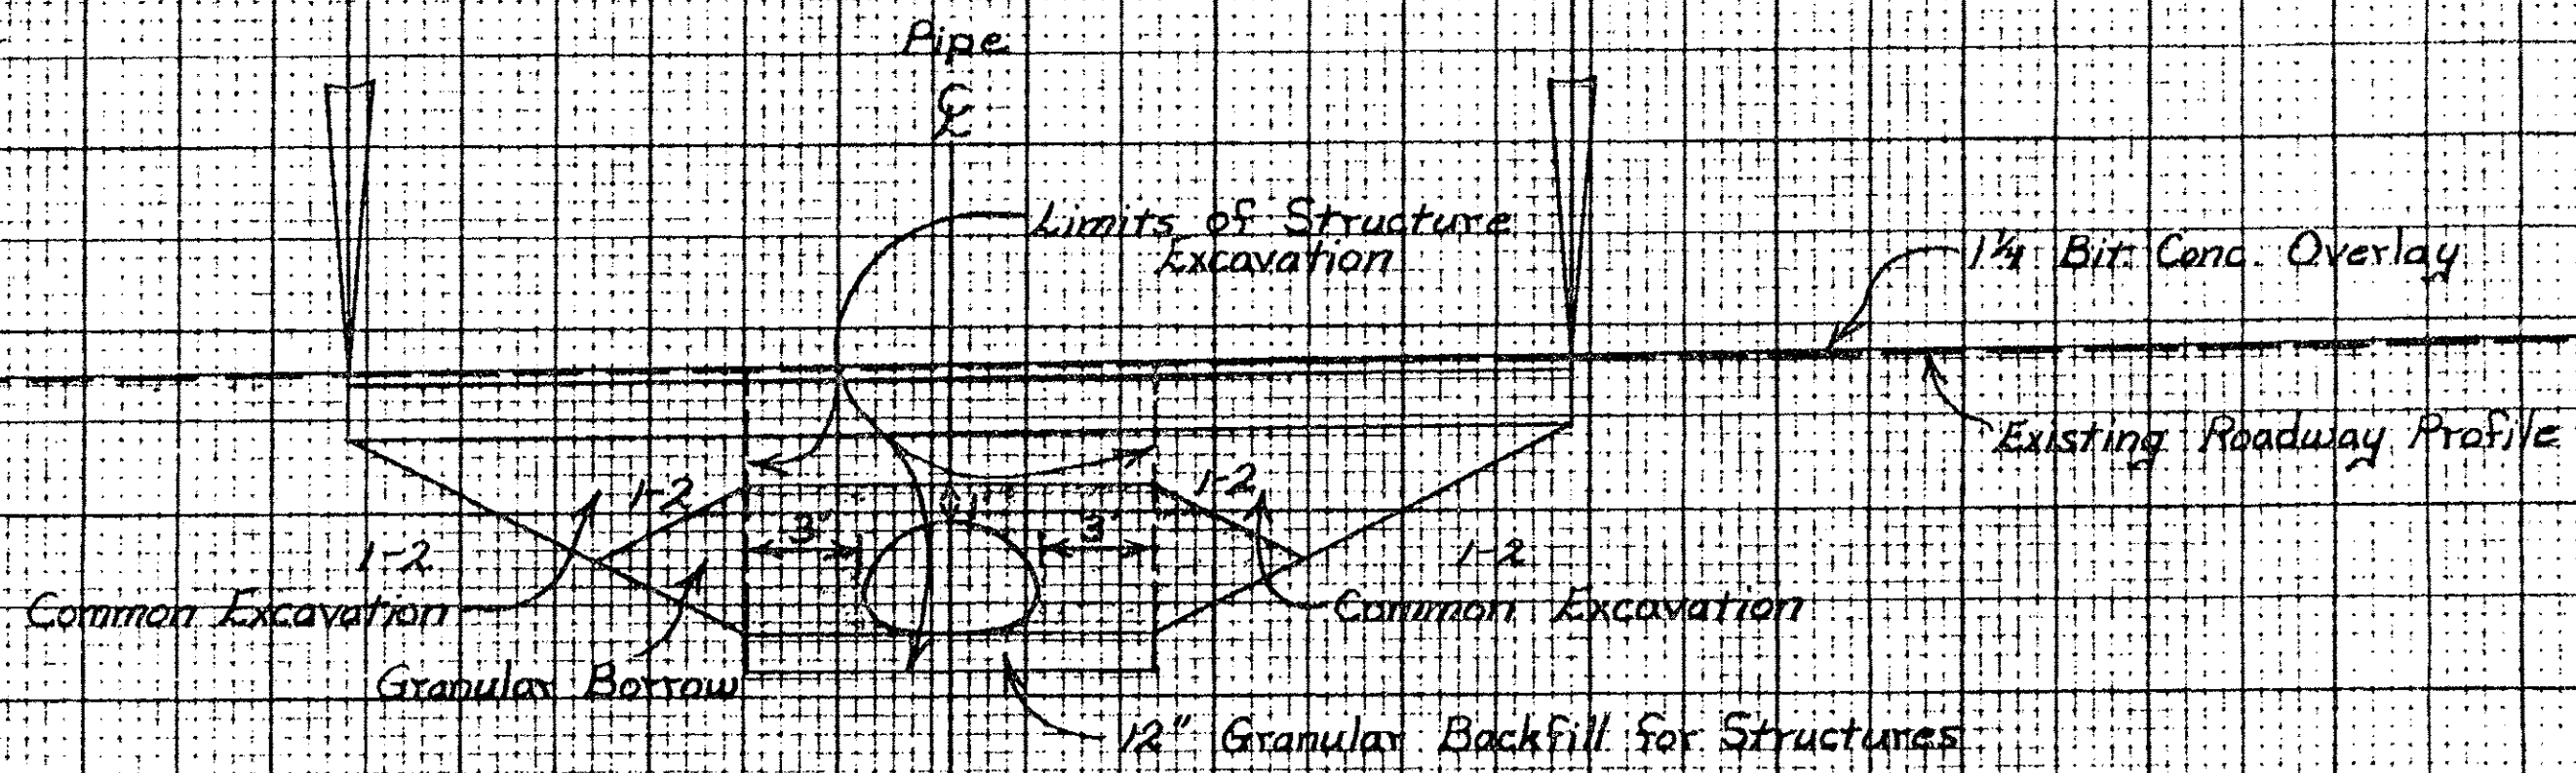


Scale in Feet

TH# 21+47±
New 57\"/>

22

21

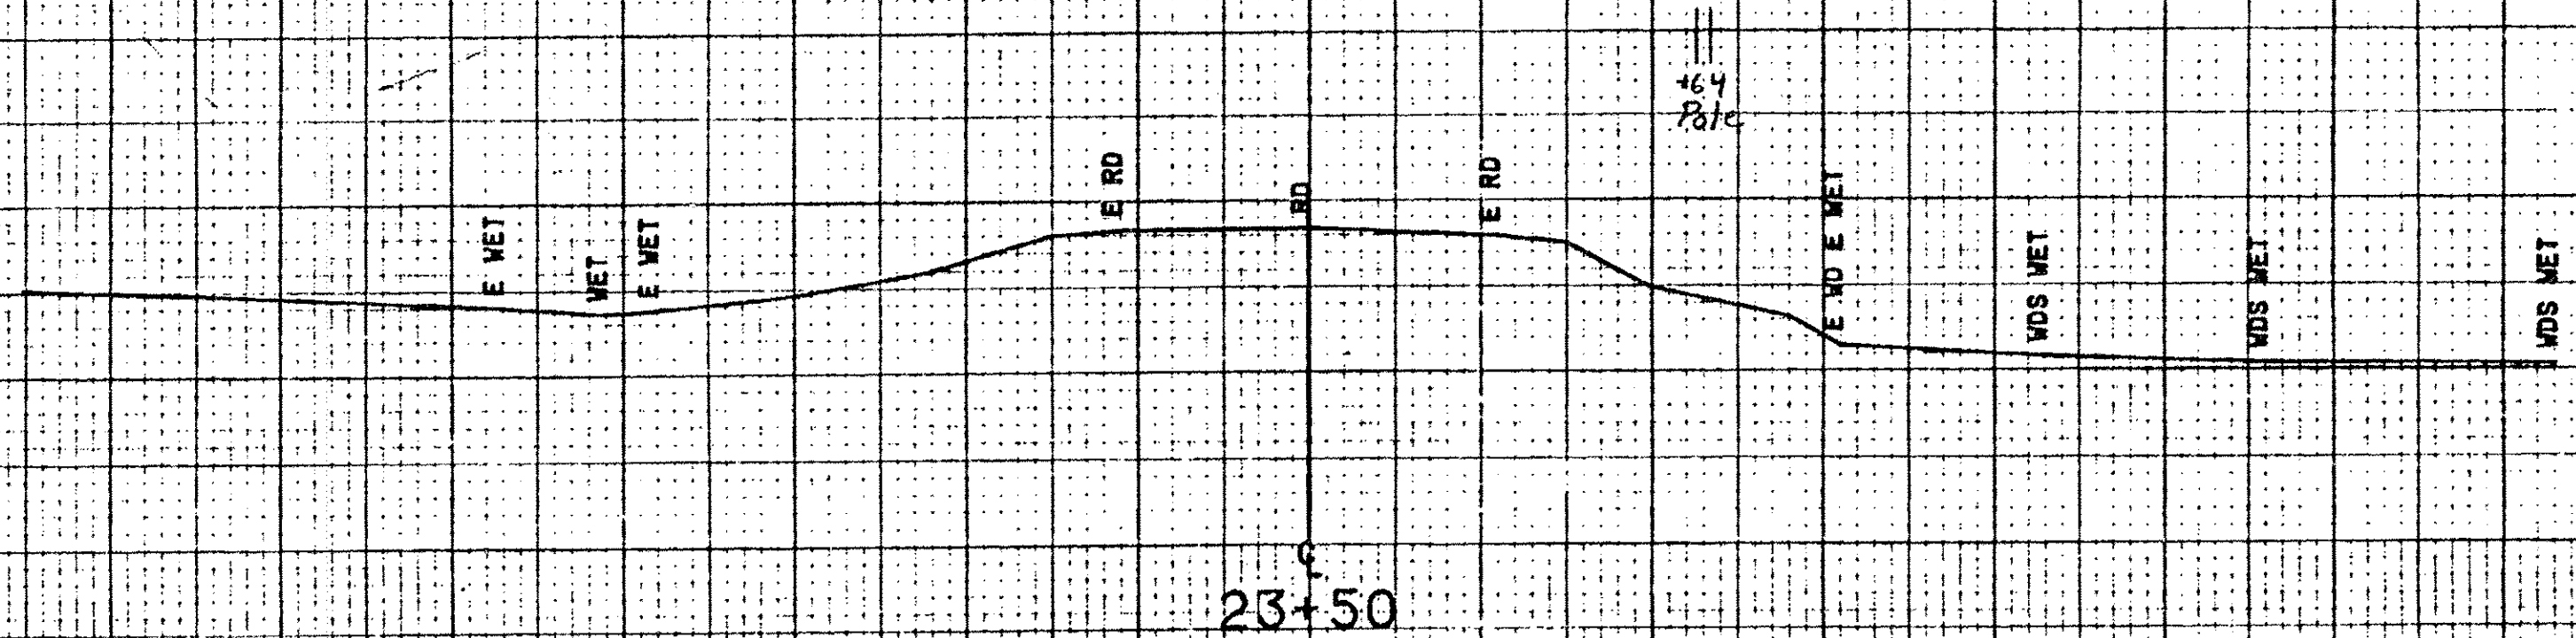

1130

23+50

FROM STA.	23+50	TO STA.	23+50
PROJECT NAME	BERLIN ODDGE RD		
NO.	MS200 (2) S	PLOTTED	10/02/87
SURVEYED BY	REED		09/87 0076
SHEET	73 OF 7	SHEETS	

SCALE 10 FEET

8