


BEGIN MECC M.6200(2) S
 REVISED SECTIONS
 SCOTT HILL ROAD
 78+0 - 81+0

CONN. ASBESTE - ALBERTA
 4/10/78
 R. LEM
 4/12/78

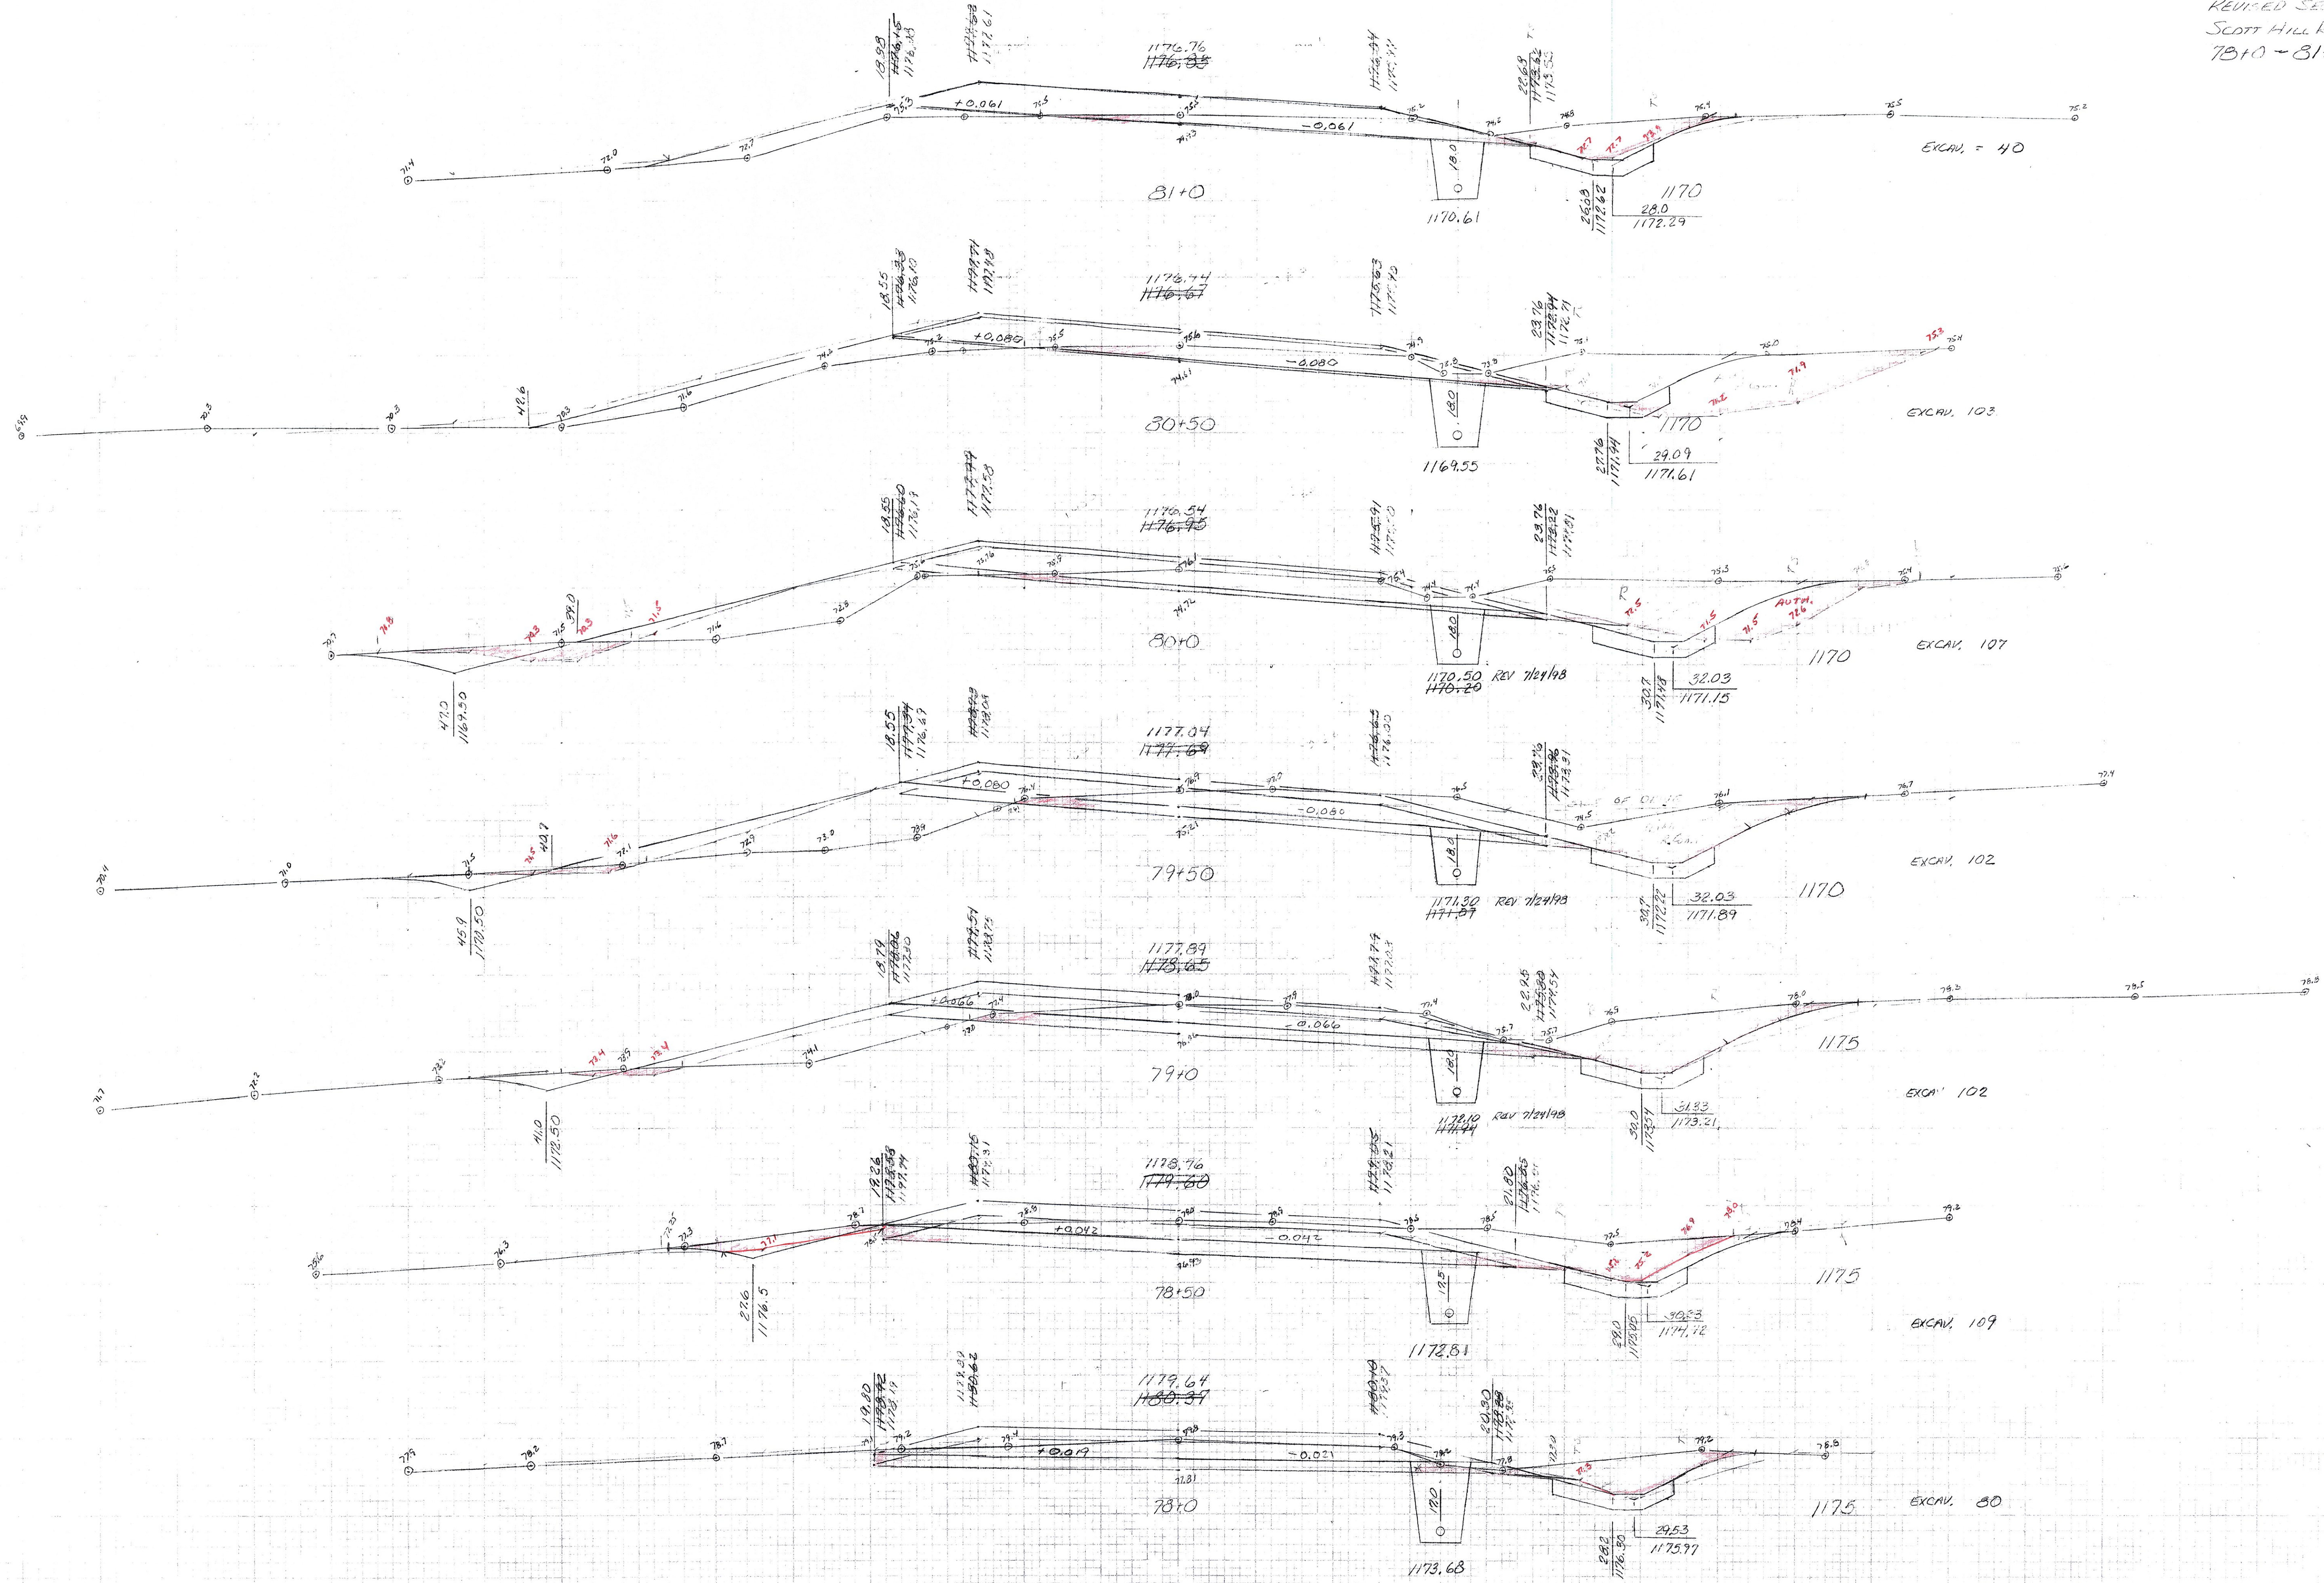

* Standard drain was installed & base filled to subgrade prior to grade change.
 R.Lem