


BERLIN MEGC M6205(2)S  
 REVISED SECTIONS  
 SCOTT HILL ROAD  
 85+0 ~ 87+0

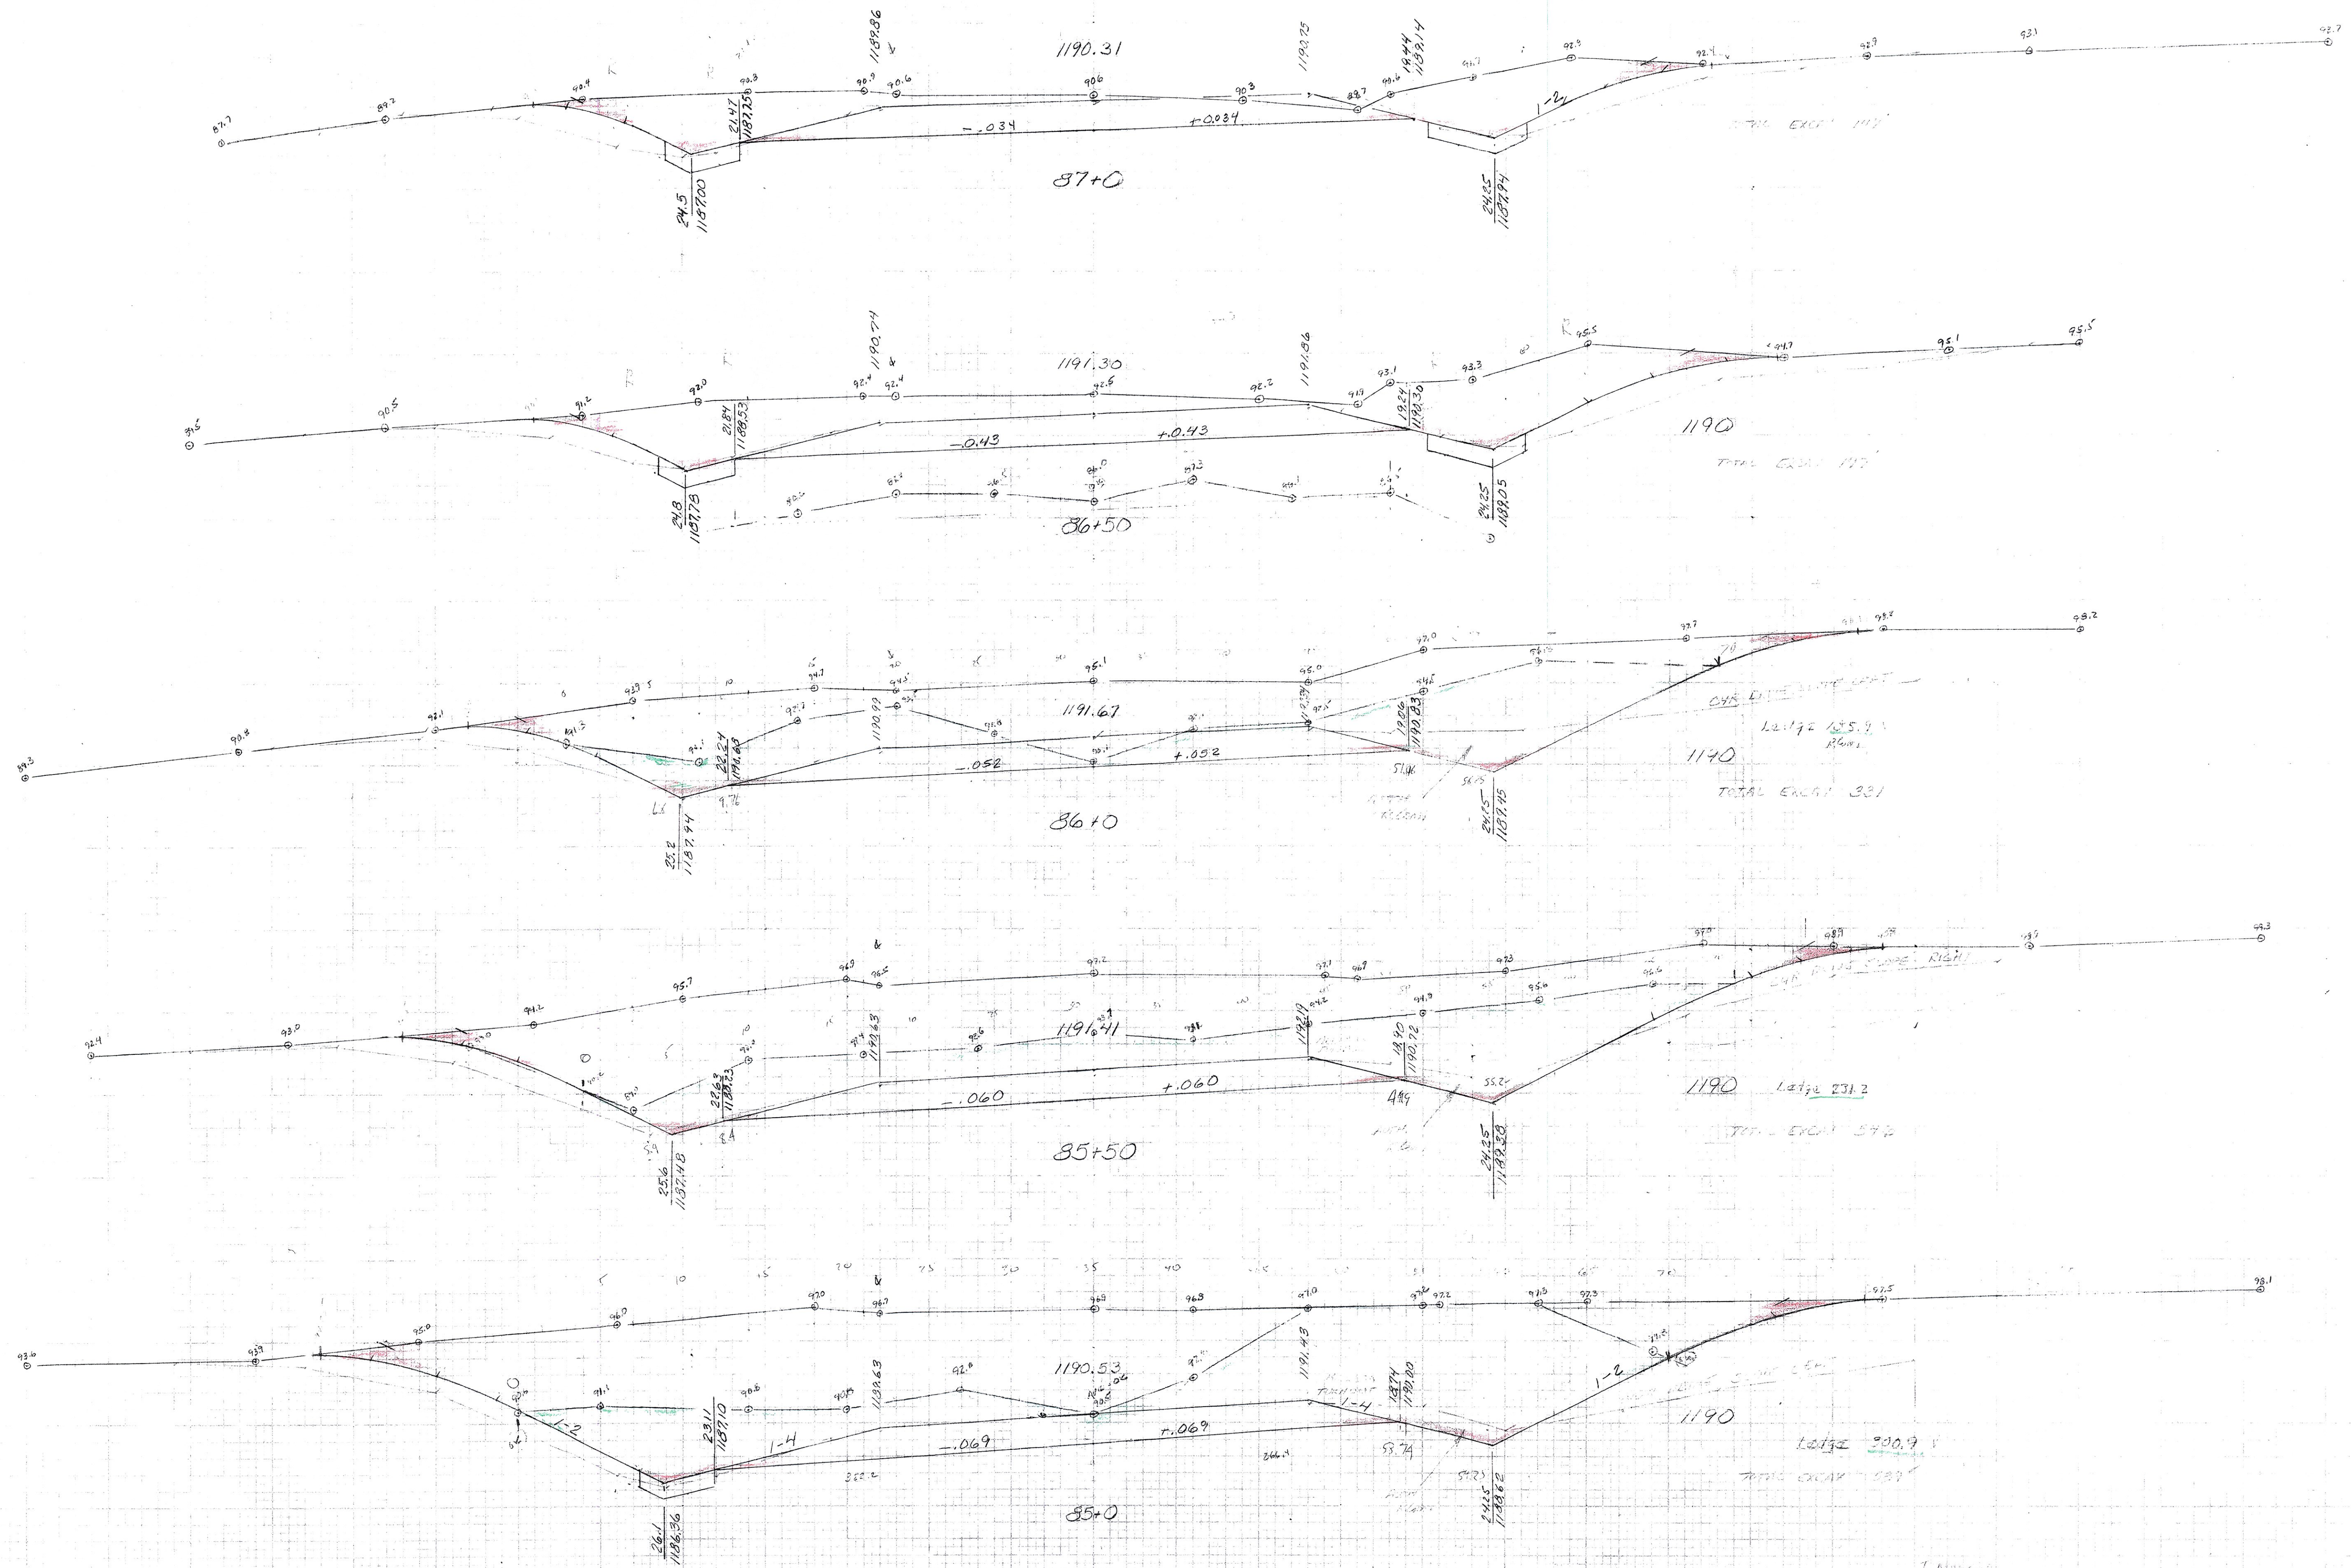

Comp. - Fisserre - North  
 4/11/13  
 4/11/13