


BELVIN MEGD M 6200(2)S
 REVISED SECTIONS
 SCOTT HILL ROAD
 90+50 ~ 93+50

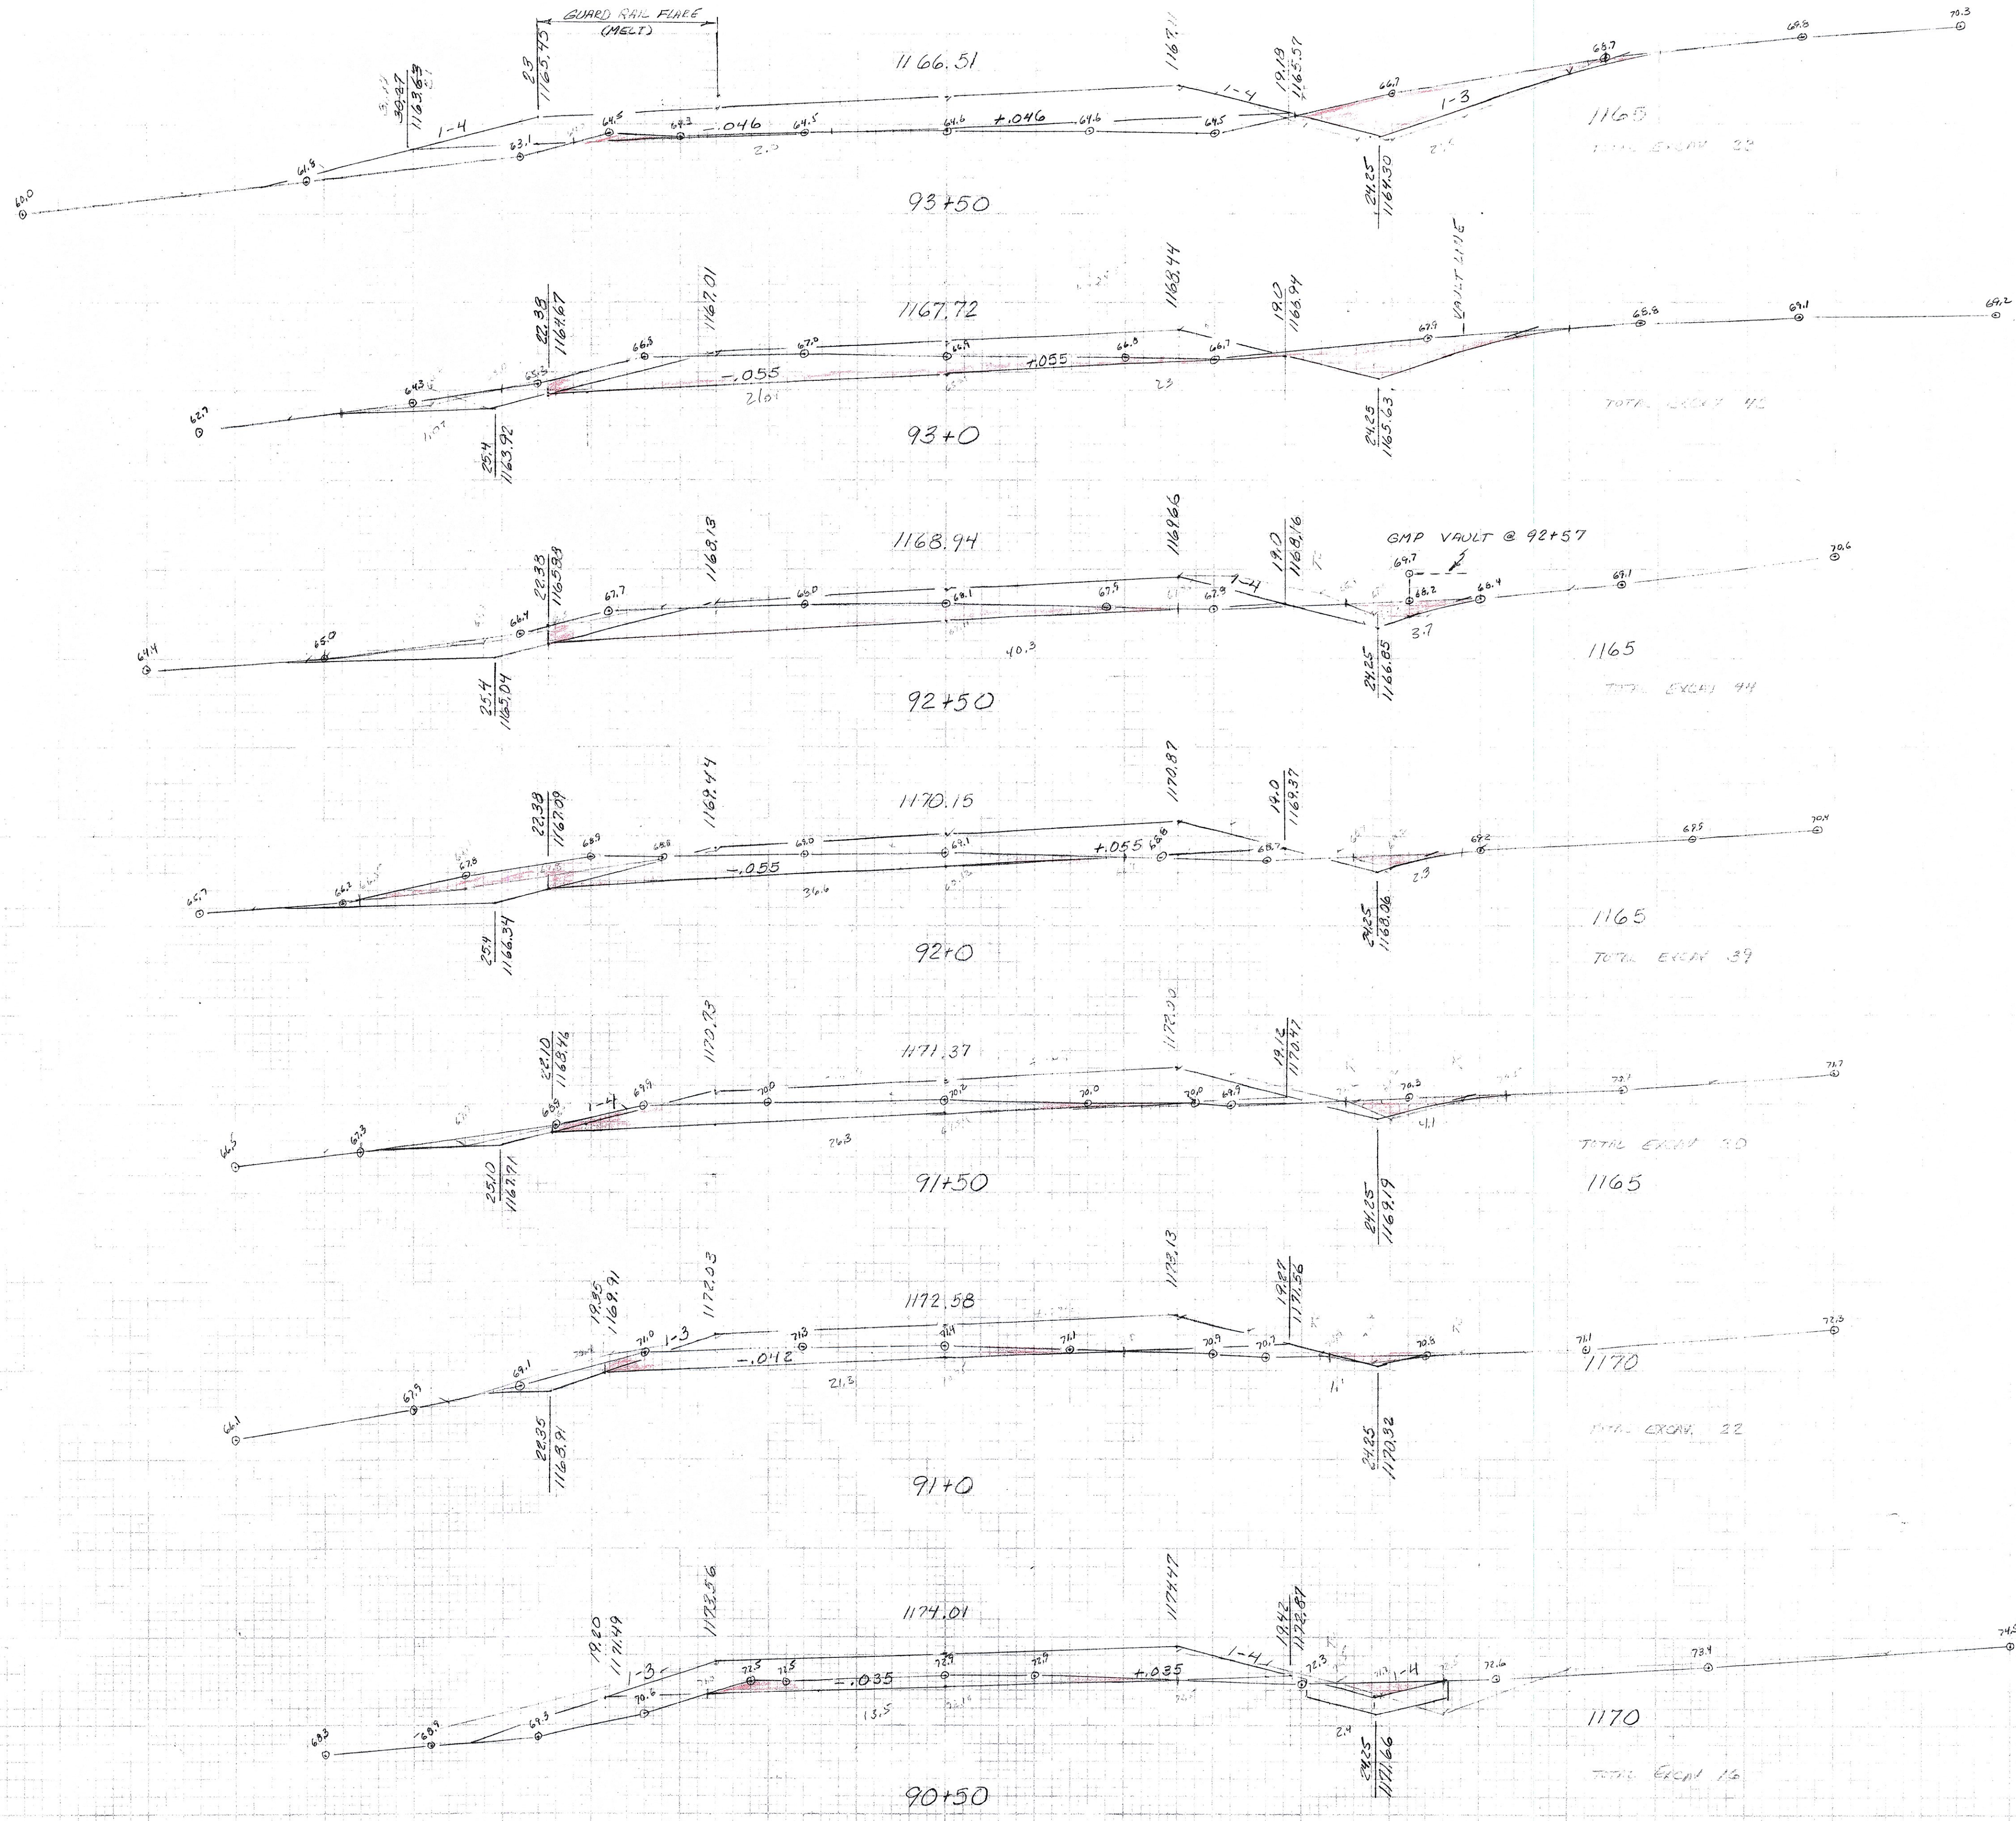

Comp. - Insert E. No. 411188
 R. Cont. 412499
 R. Cont. 415713