
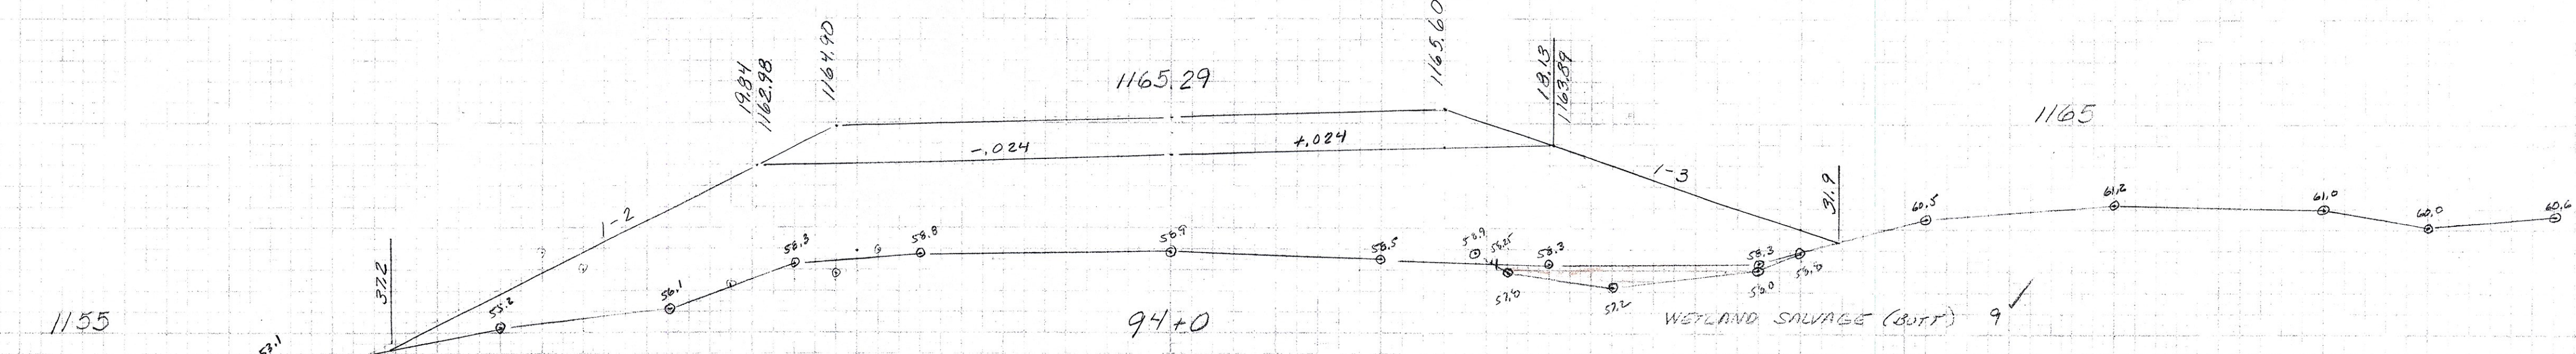
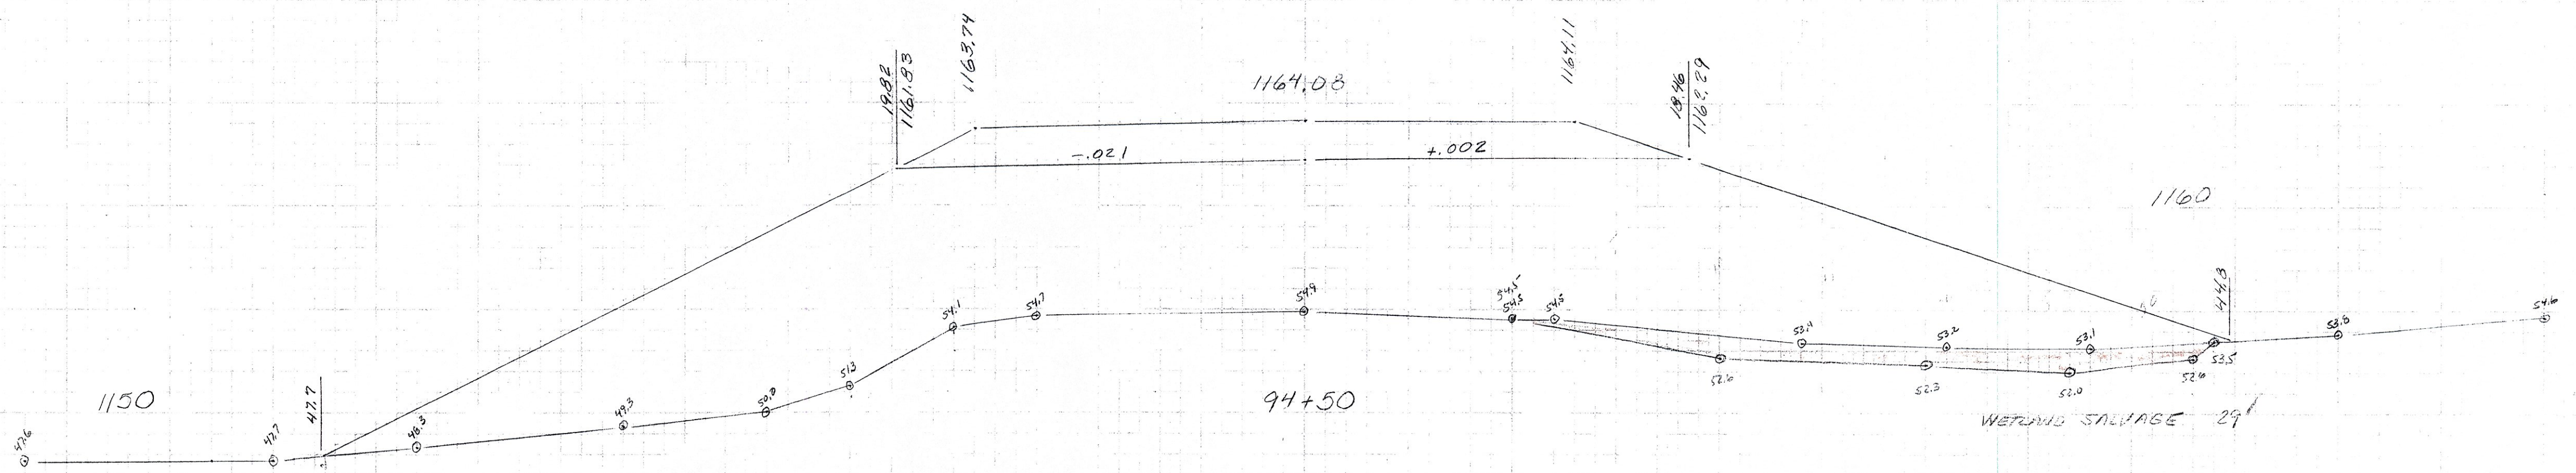
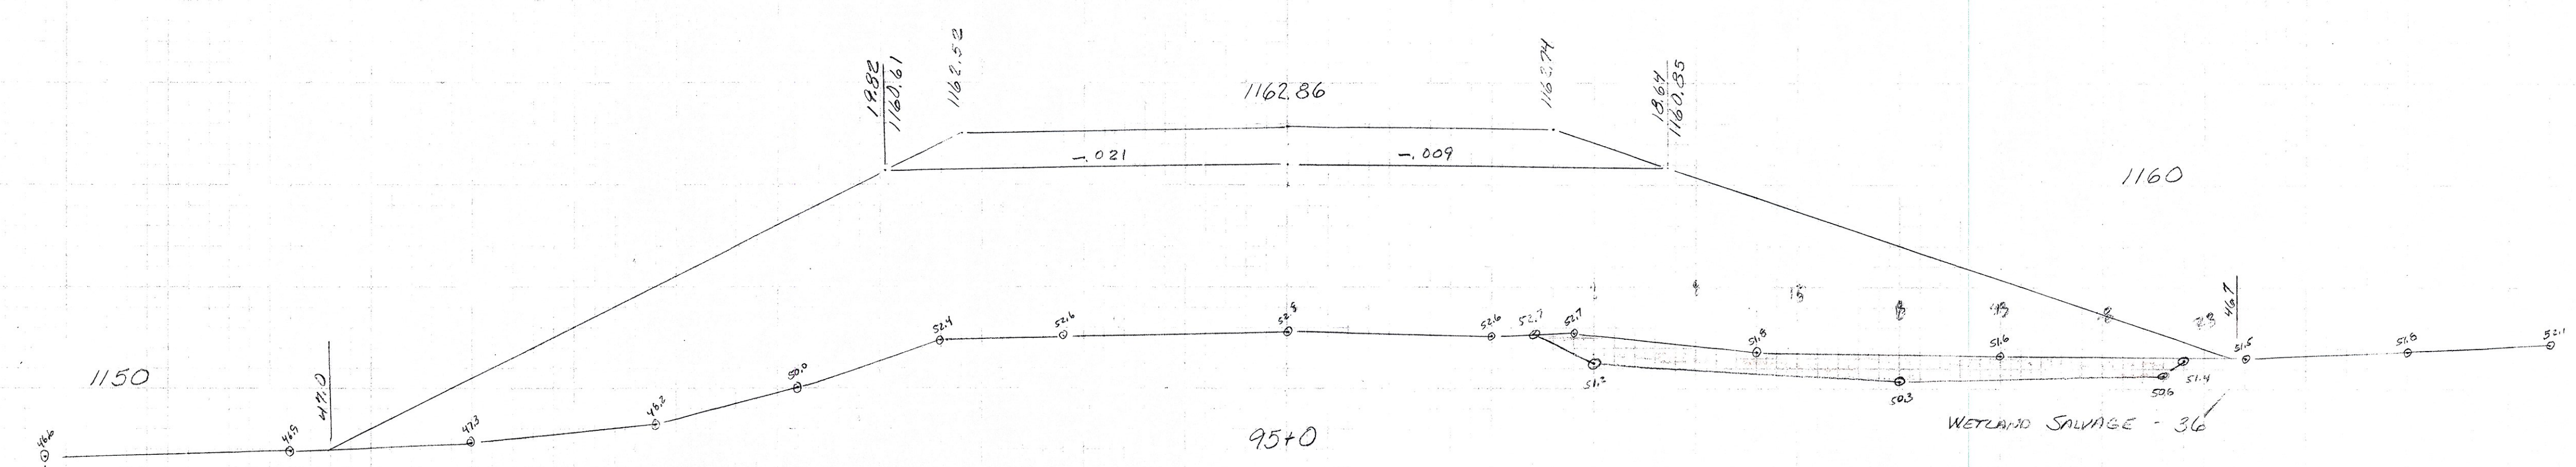


BERLIN MEGC M6200(2)S
 REVISED SECTIONS
 SCOTT HILL ROAD
 94+0 ~ 95+50

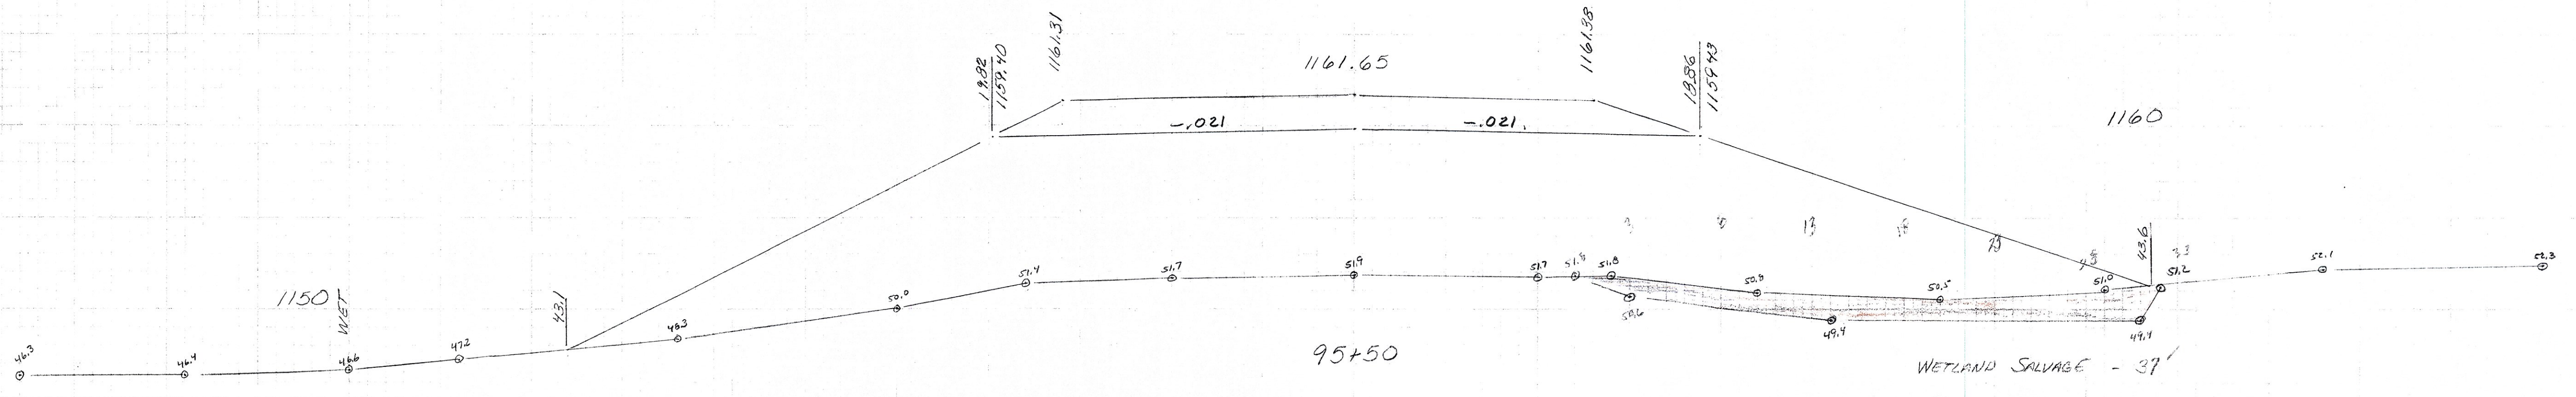

Comp. - RASCOTTE - North 4/25/65
 R. L. Smith
 11/20/70