


BERLIN MEGC M6200(2) S
 REVISED SECTIONS
 SCOTT HILL ROAD
 96+0 ~ 98+0

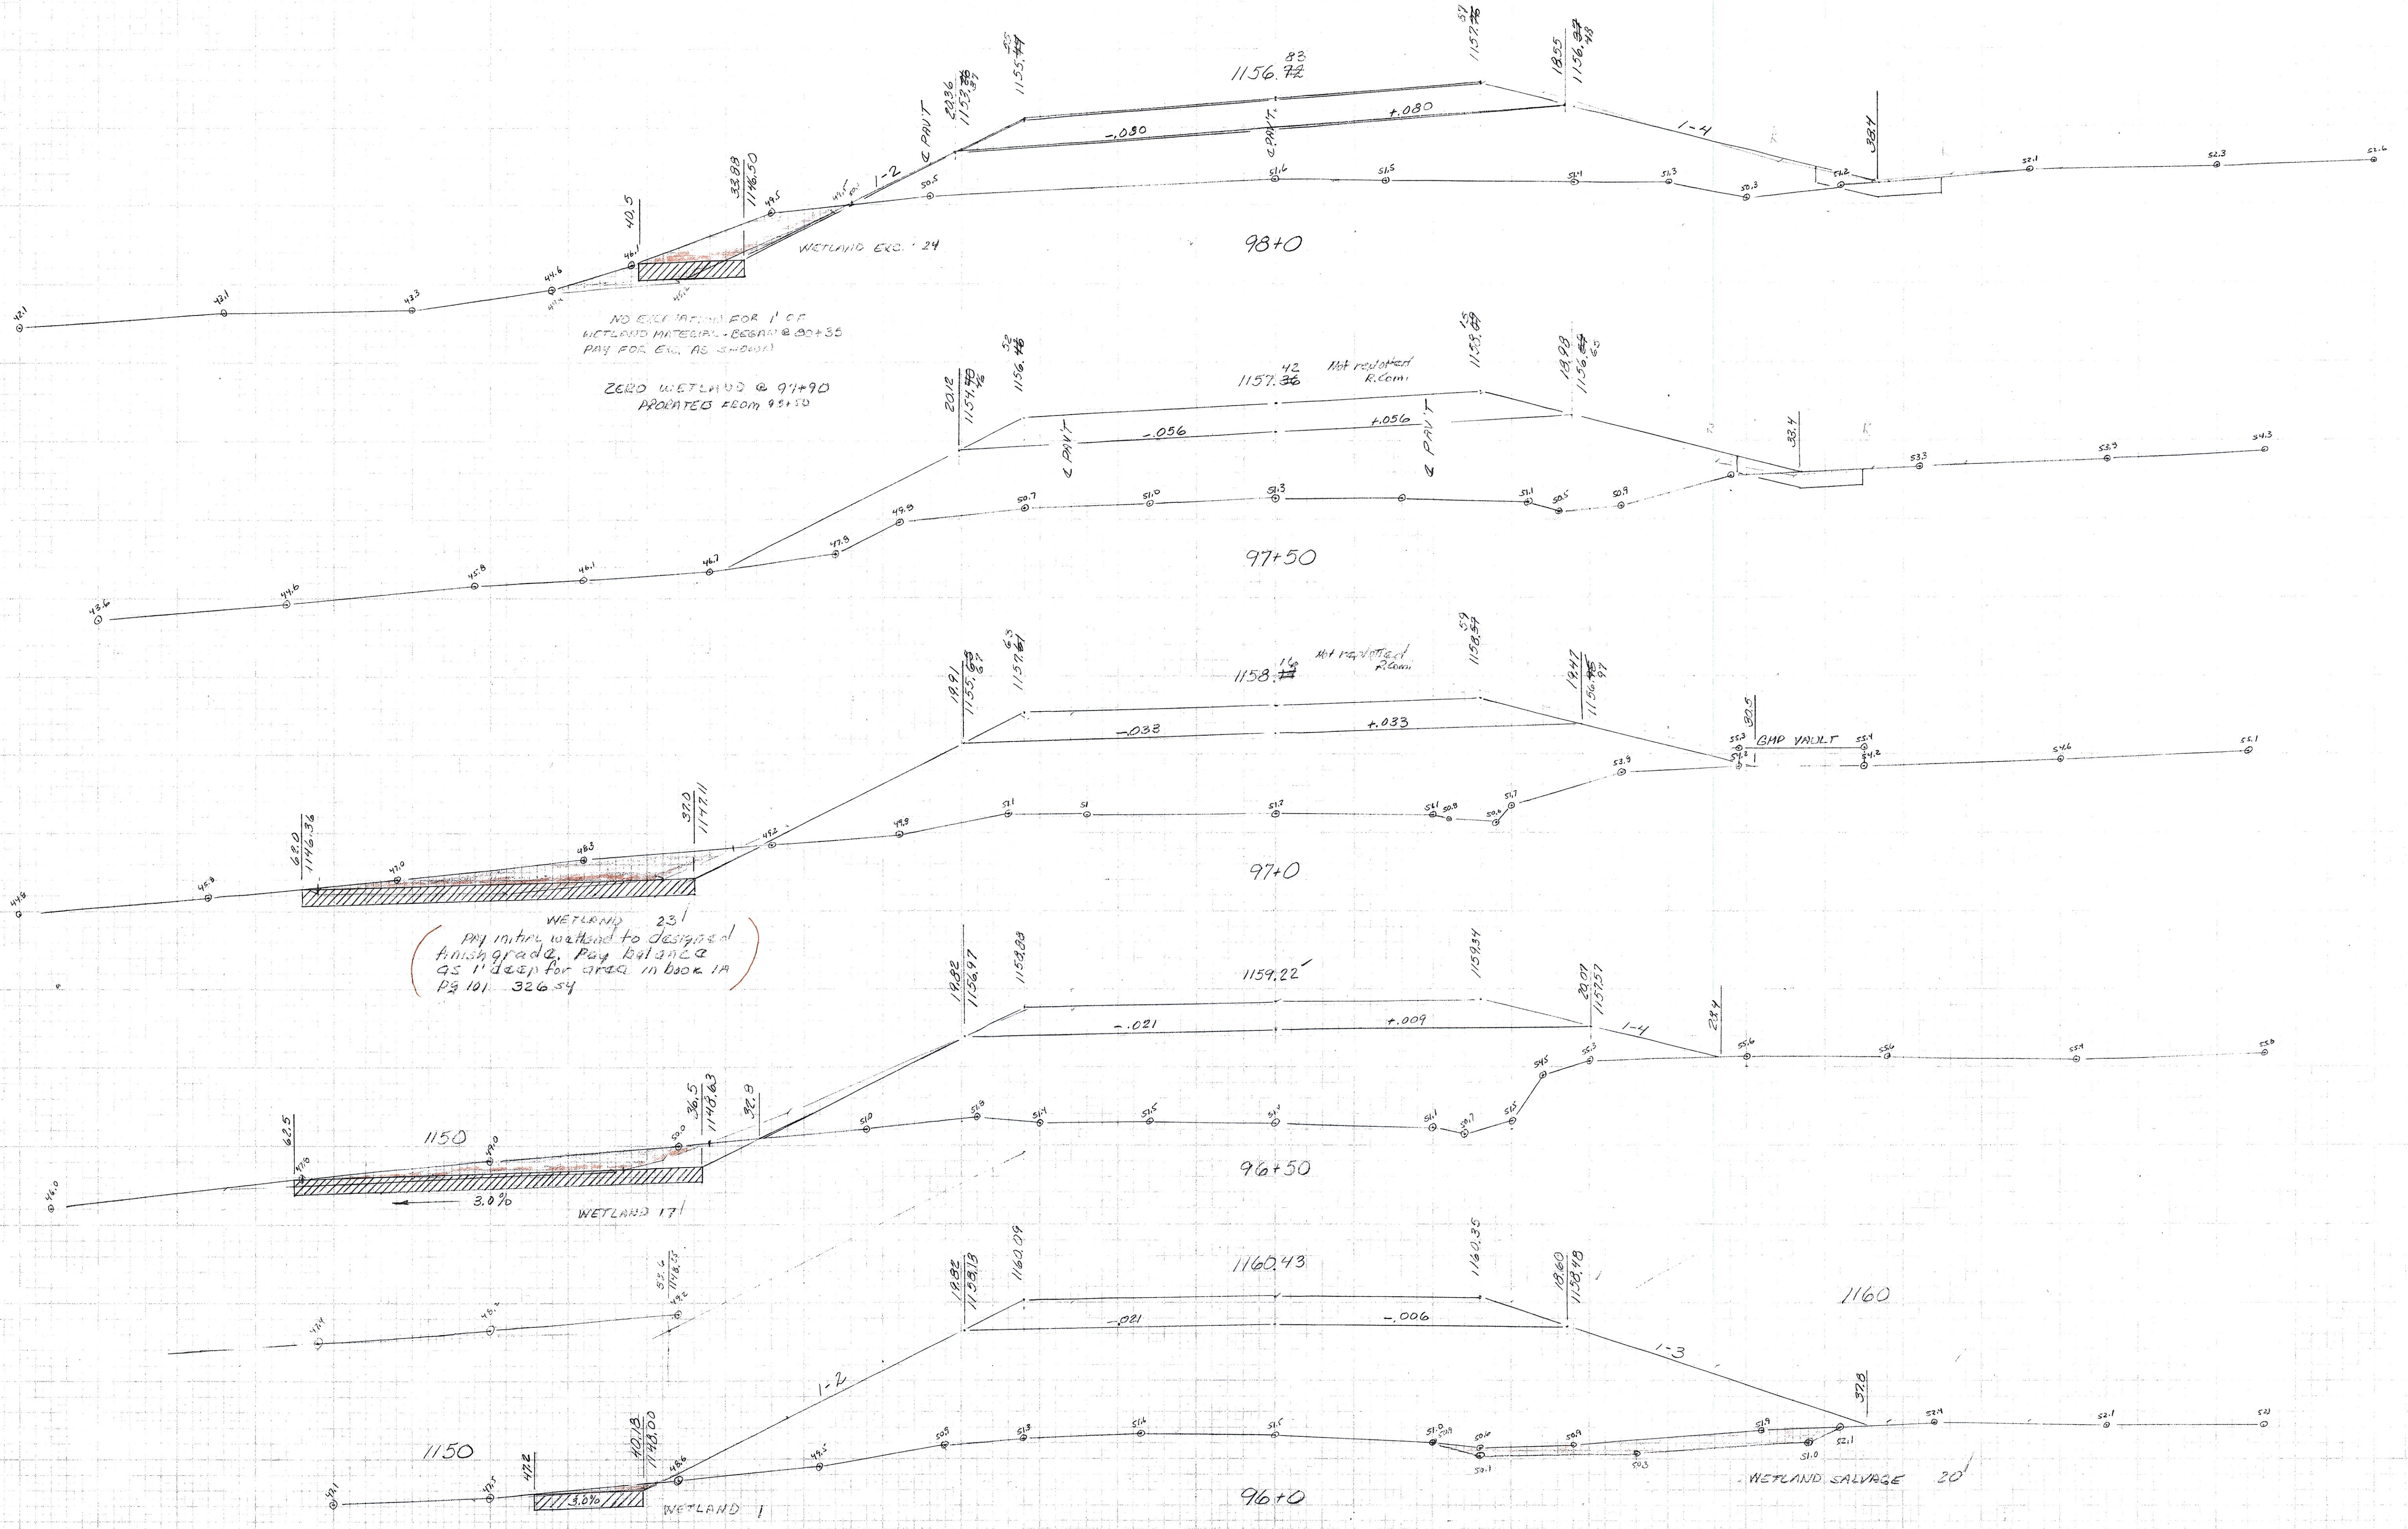

WETLAND 23
 1st minor wetland to designated
 finish grade. Pay Balance
 as 1' deep for area in box 1A
 P3 101.326.54

Copy-Plotted: North 11/19/98
 R.Lam.
 4/20/99