


BERLIN MEGC 116200(2)S
 REVISED SECTIONS
 SCOTT HILL ROAD
 98+50 ~ 99+50

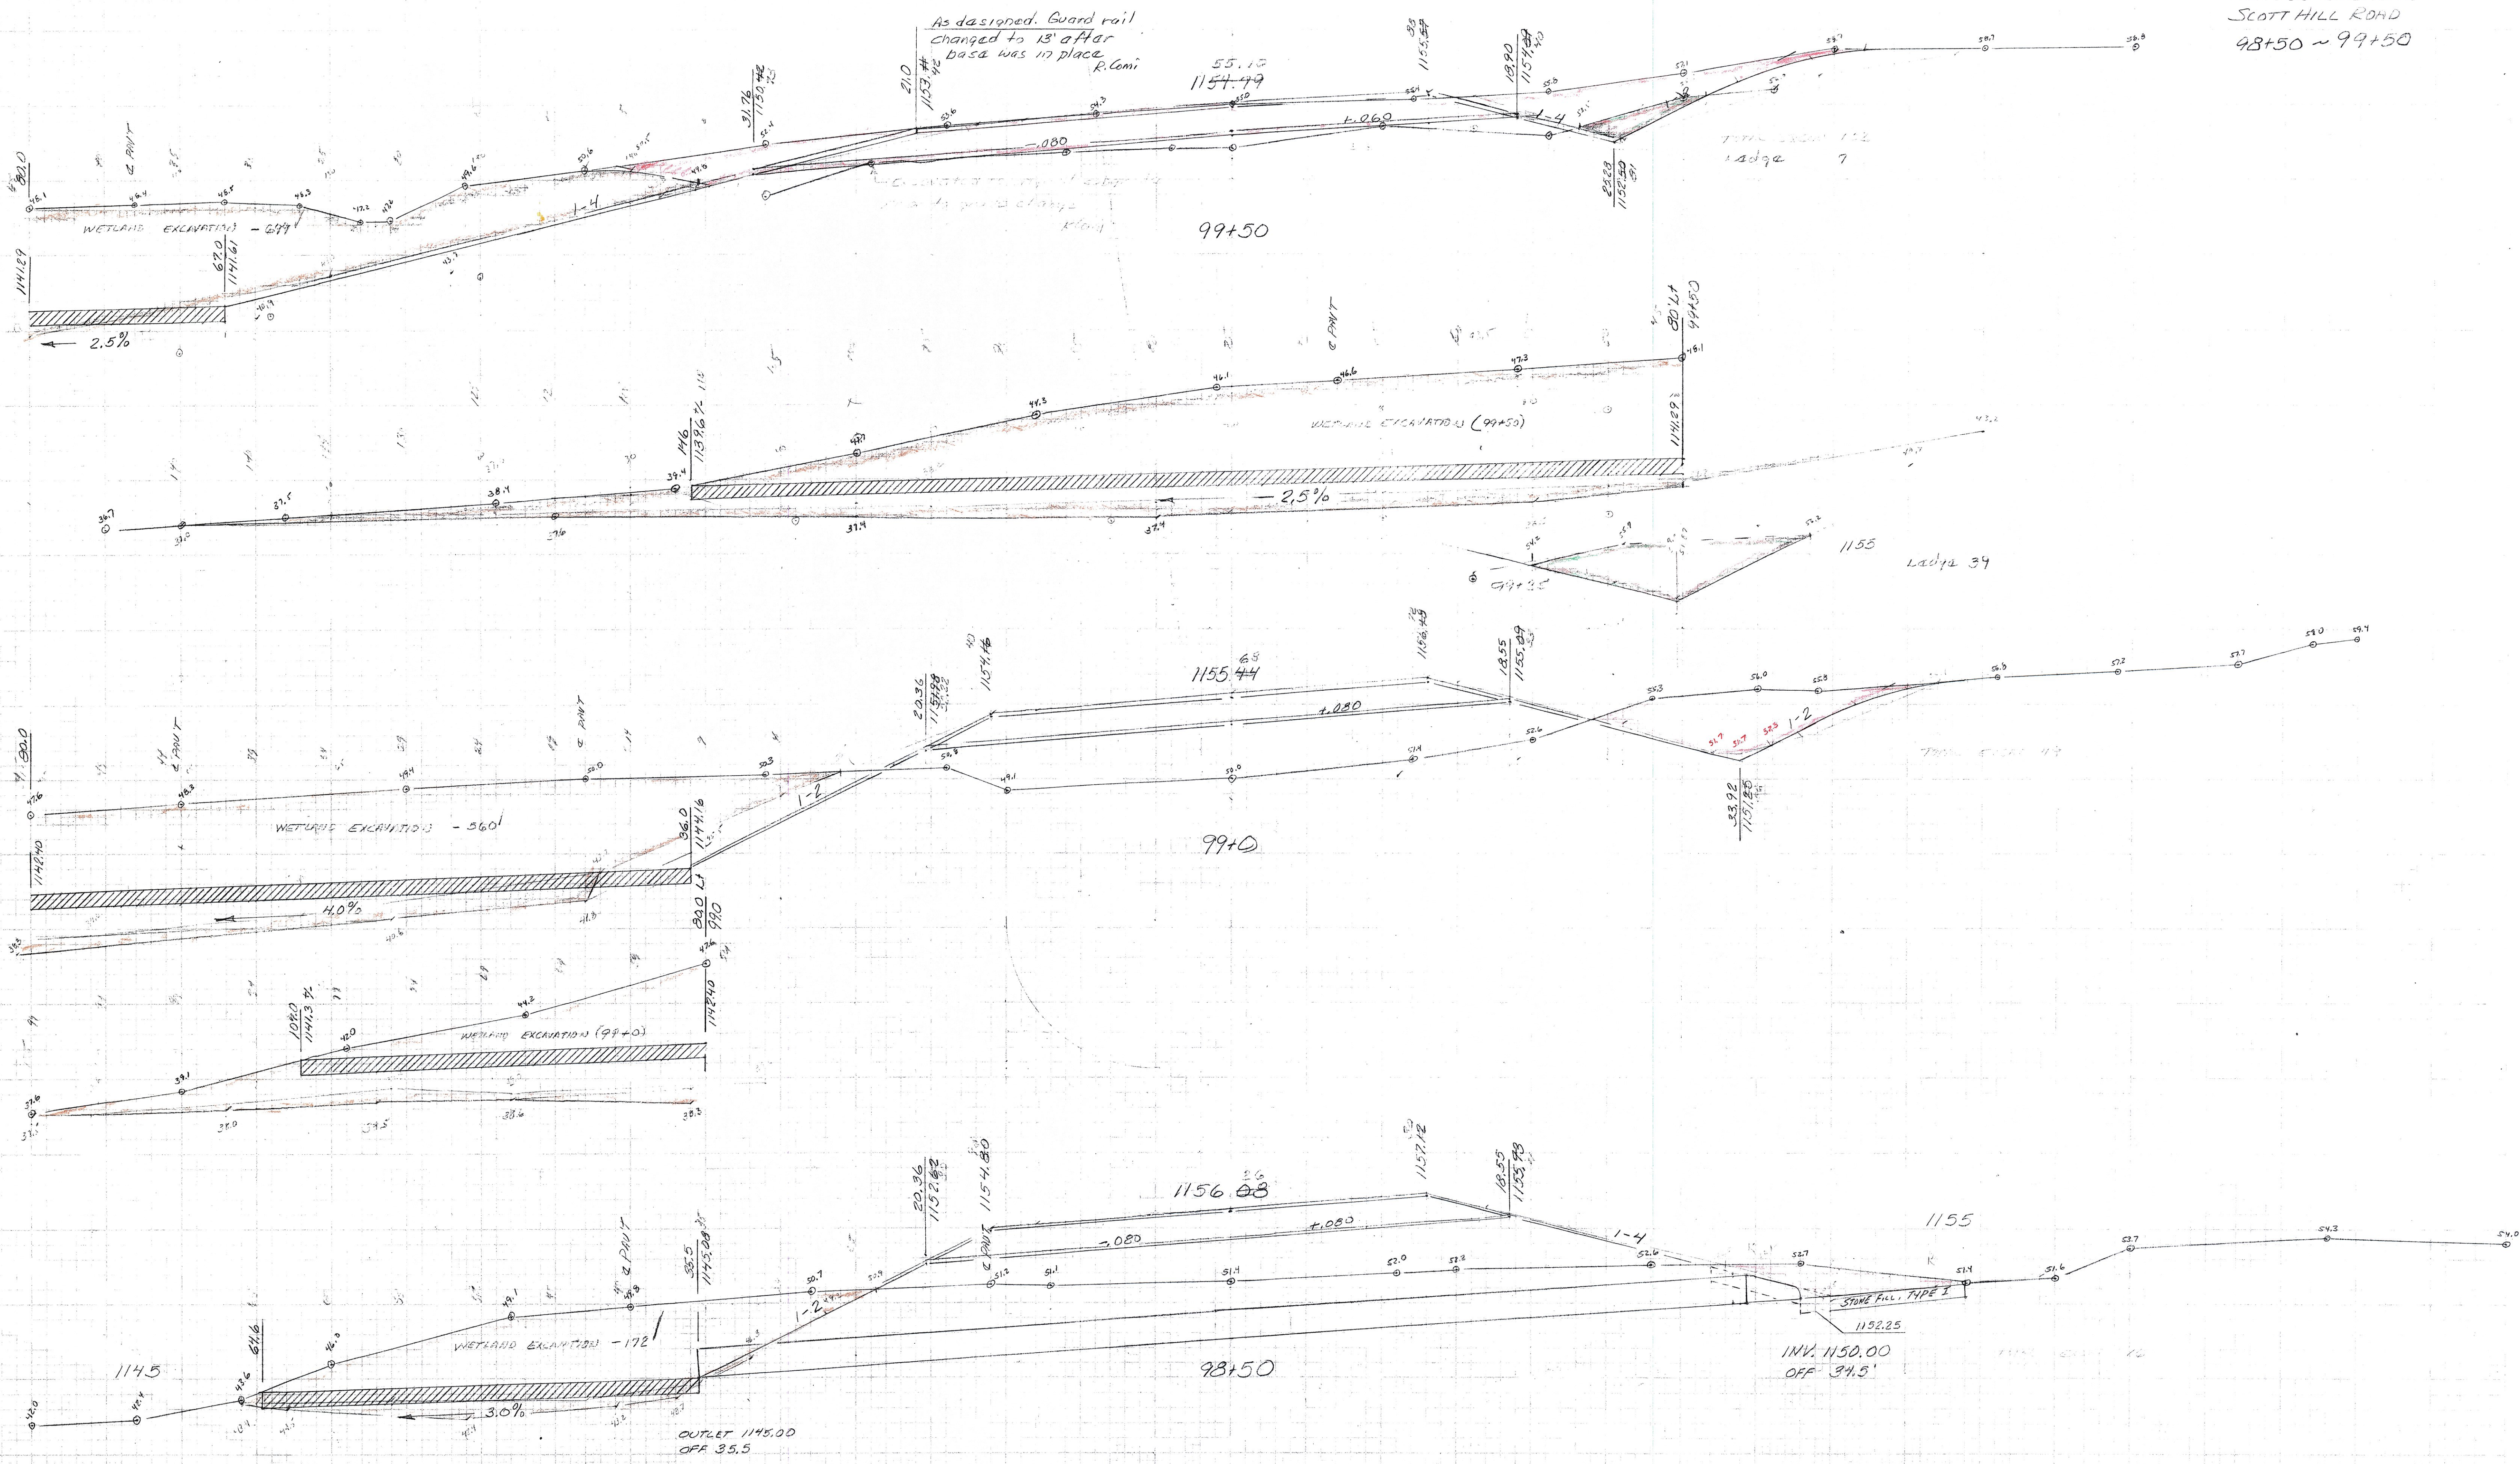

Cont. - FURTHER DRAWING
 R.C.M.
 1/8" = 10'