


BERLIN
ROAD PROFILE 87+0-88+50
E - Lt # Rt 11'

FINAL SURVEY SURVEYED BY DATE
PLOTTED
NOTE BOOK NO.
TEMPLATE NO.
AREAS CHECKED

ORIGINAL SURVEY SURVEYED BY DATE
PLOTTED
NOTE BOOK NO.
TEMPLATE NO.
AREAS CHECKED

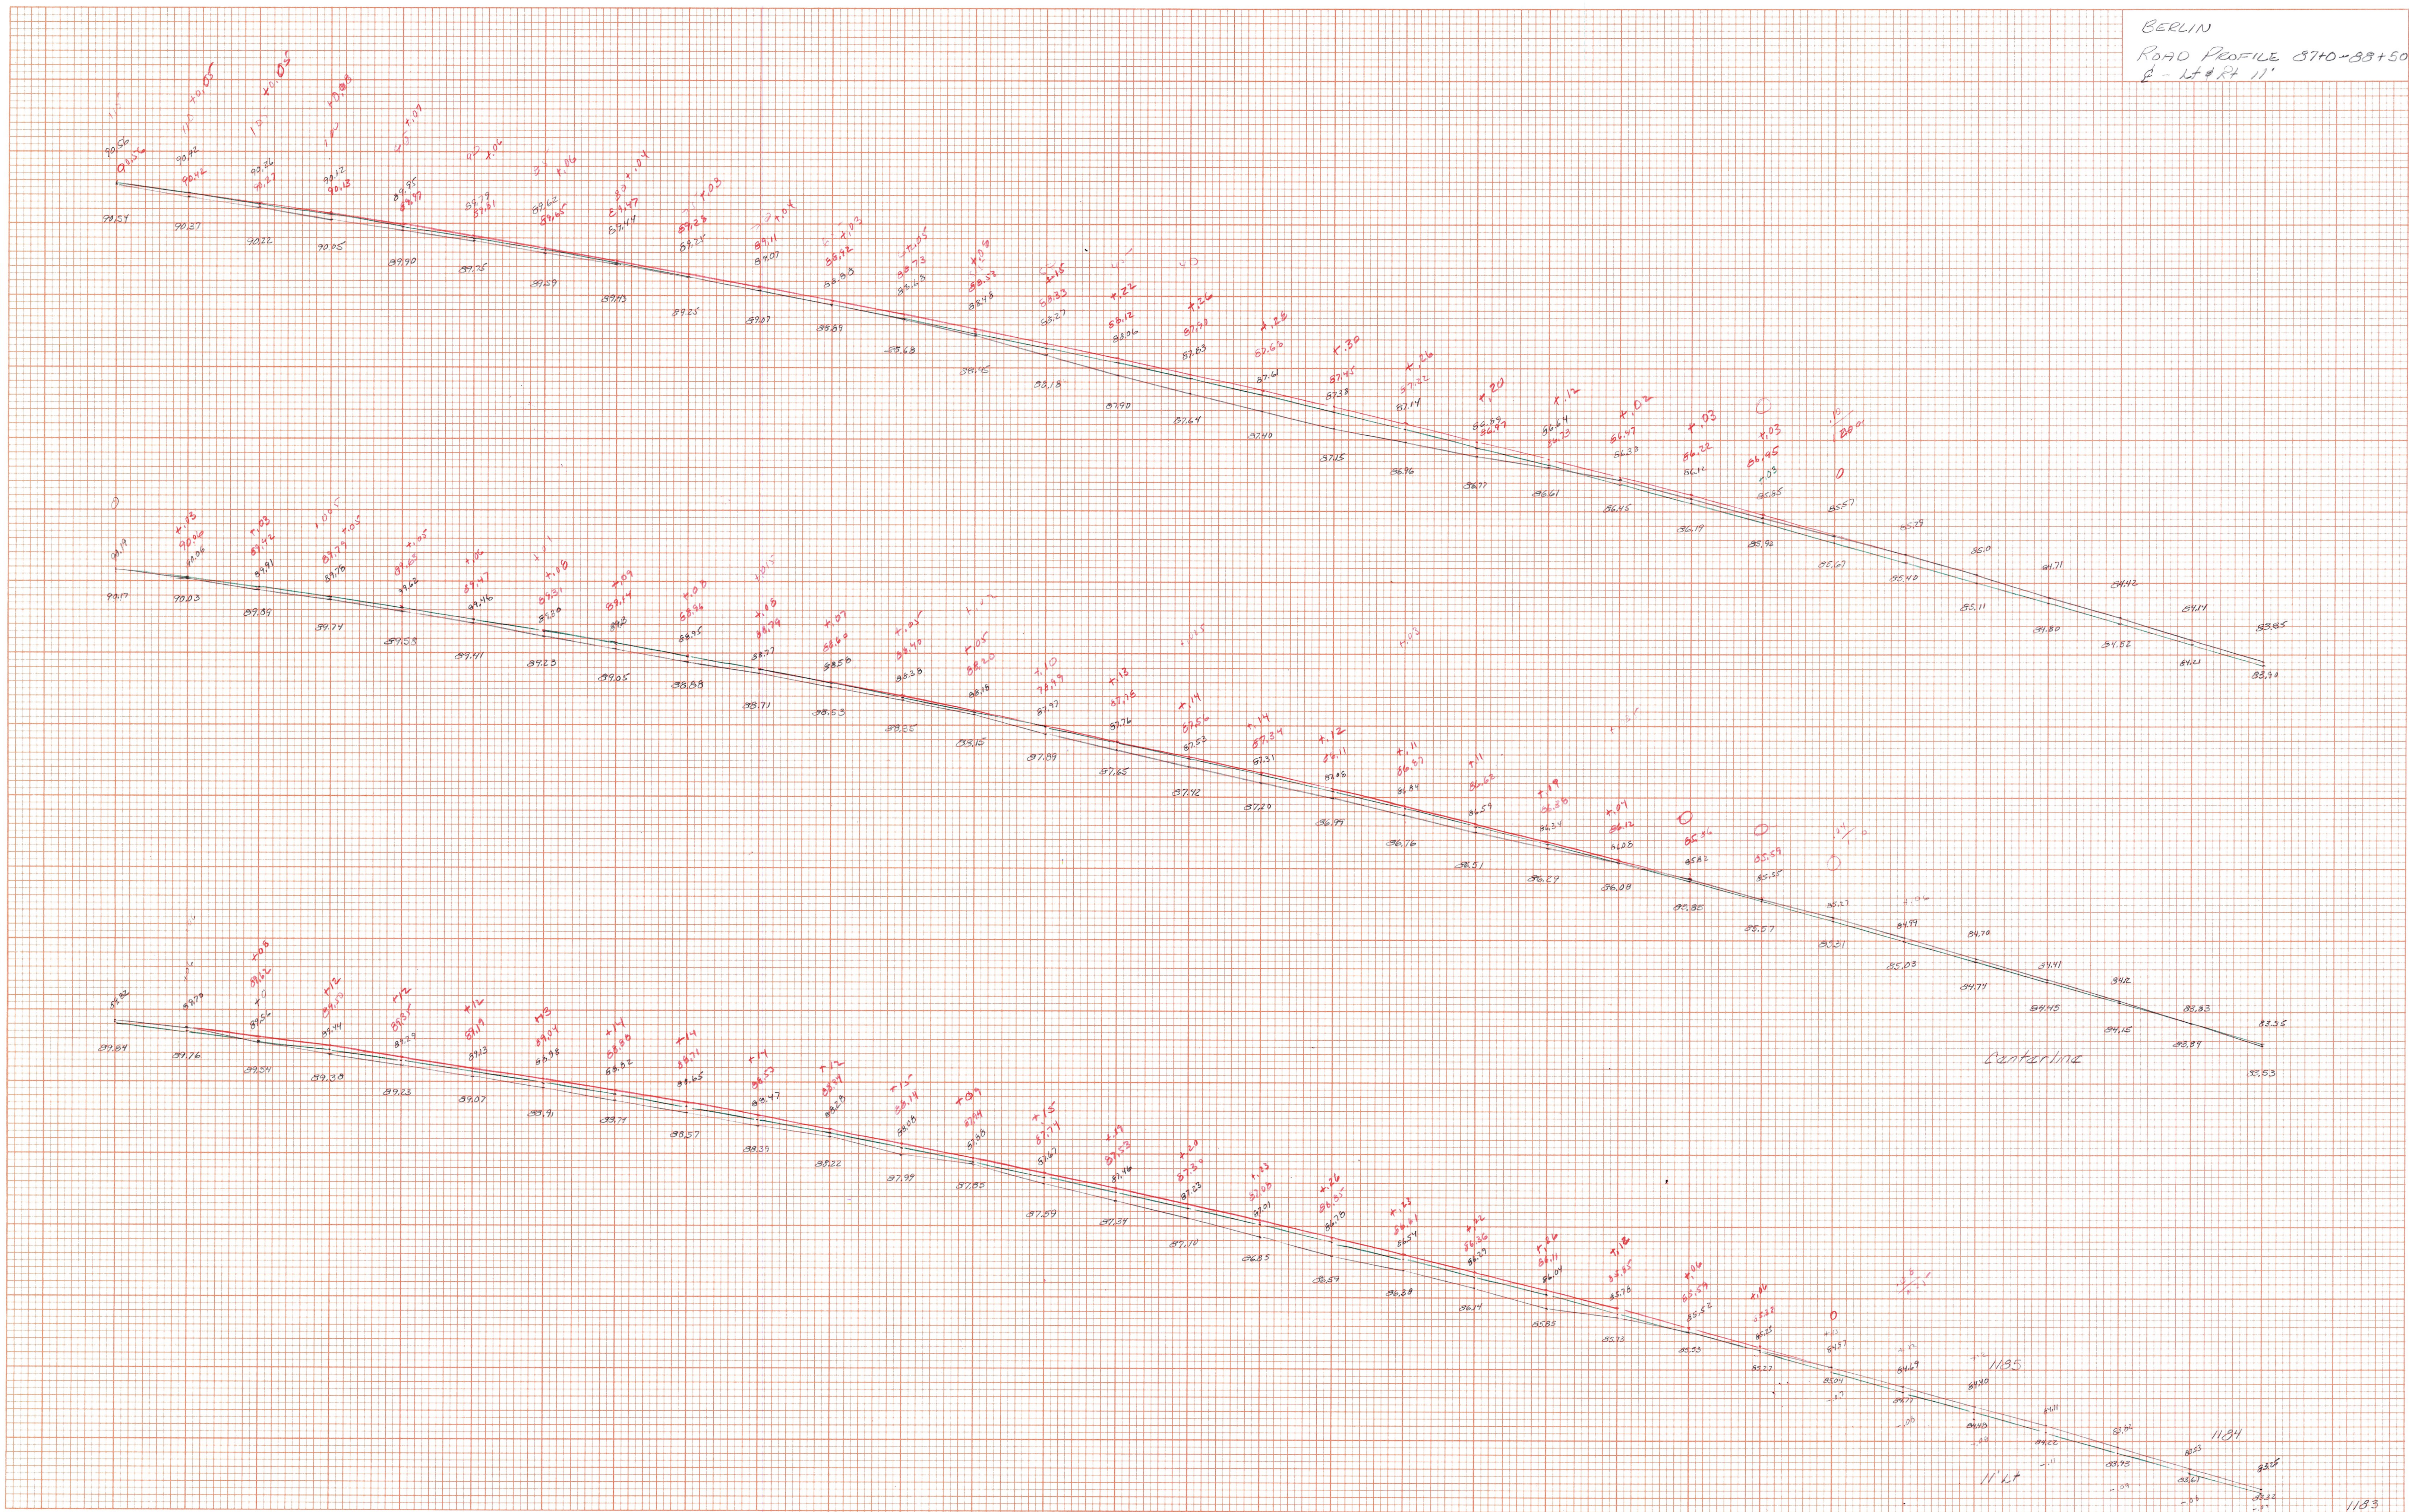

Panel existing
Green - designed