



GRUBBING MATERIAL SHALL CONSIST OF GRUBBED OR STRIPPED EARTH MATERIAL CONTAINING ROOTS OF NATIVE STREAMBANK VEGETATION. PROVIDE FOR *TEMPORARY EROSION CONTROL BY APPLYING SEED, FERTILIZER AND HAY MULCH TO THE FINISH SURFACE.

CONTINUE STONE FILL TO ORIGINAL GROUND OR 1'-0" ABOVE DESIGN FLOW ELEVATION.

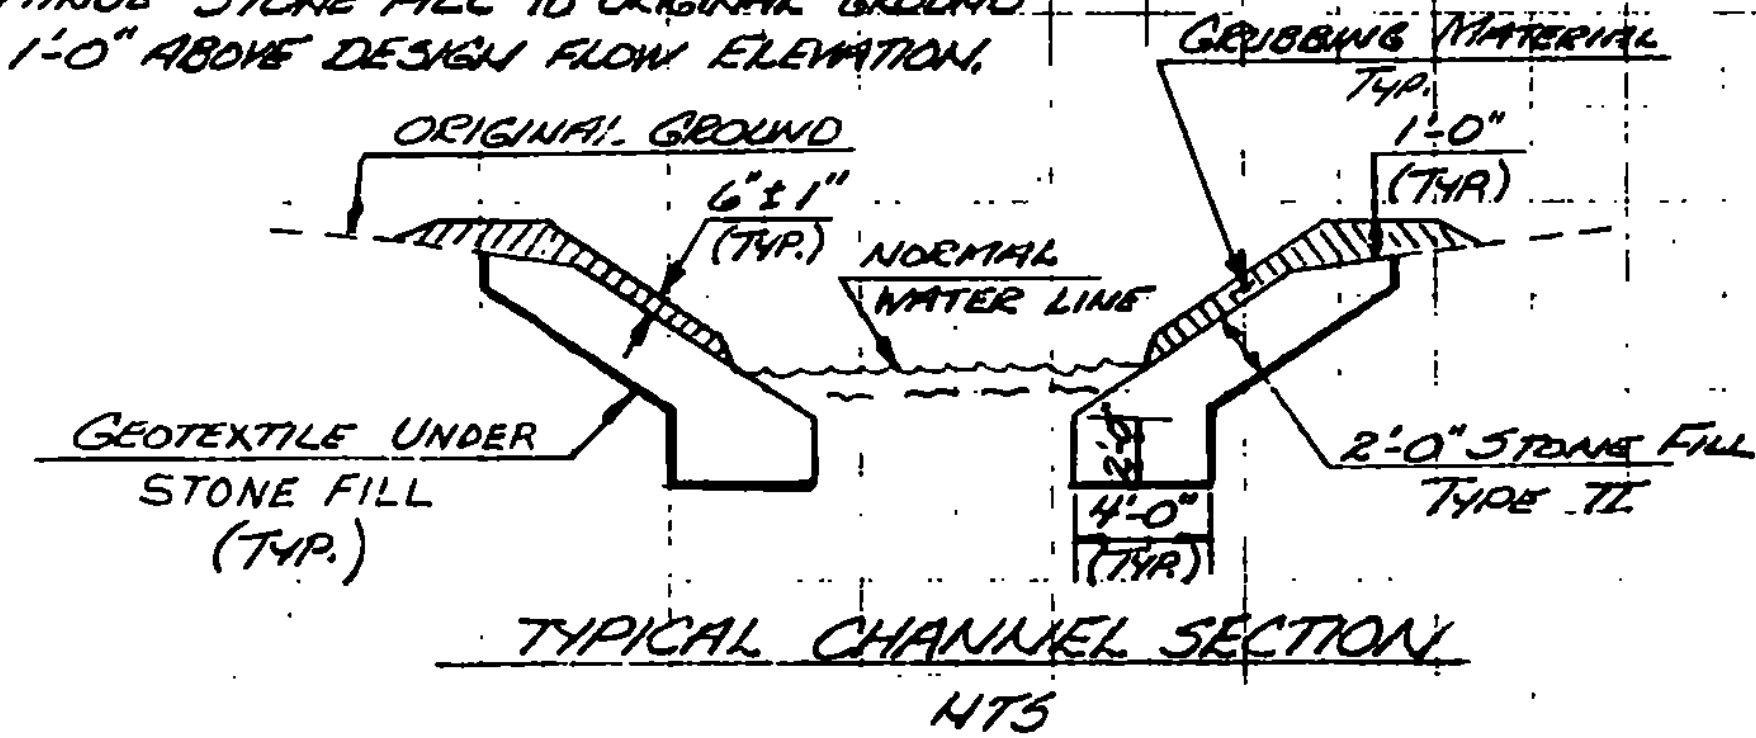

* TEMPORARY EROSION CONTROL TO BE PAID AS SUBSIDIARY TO OTHER ITEMS IN CONTRACT.

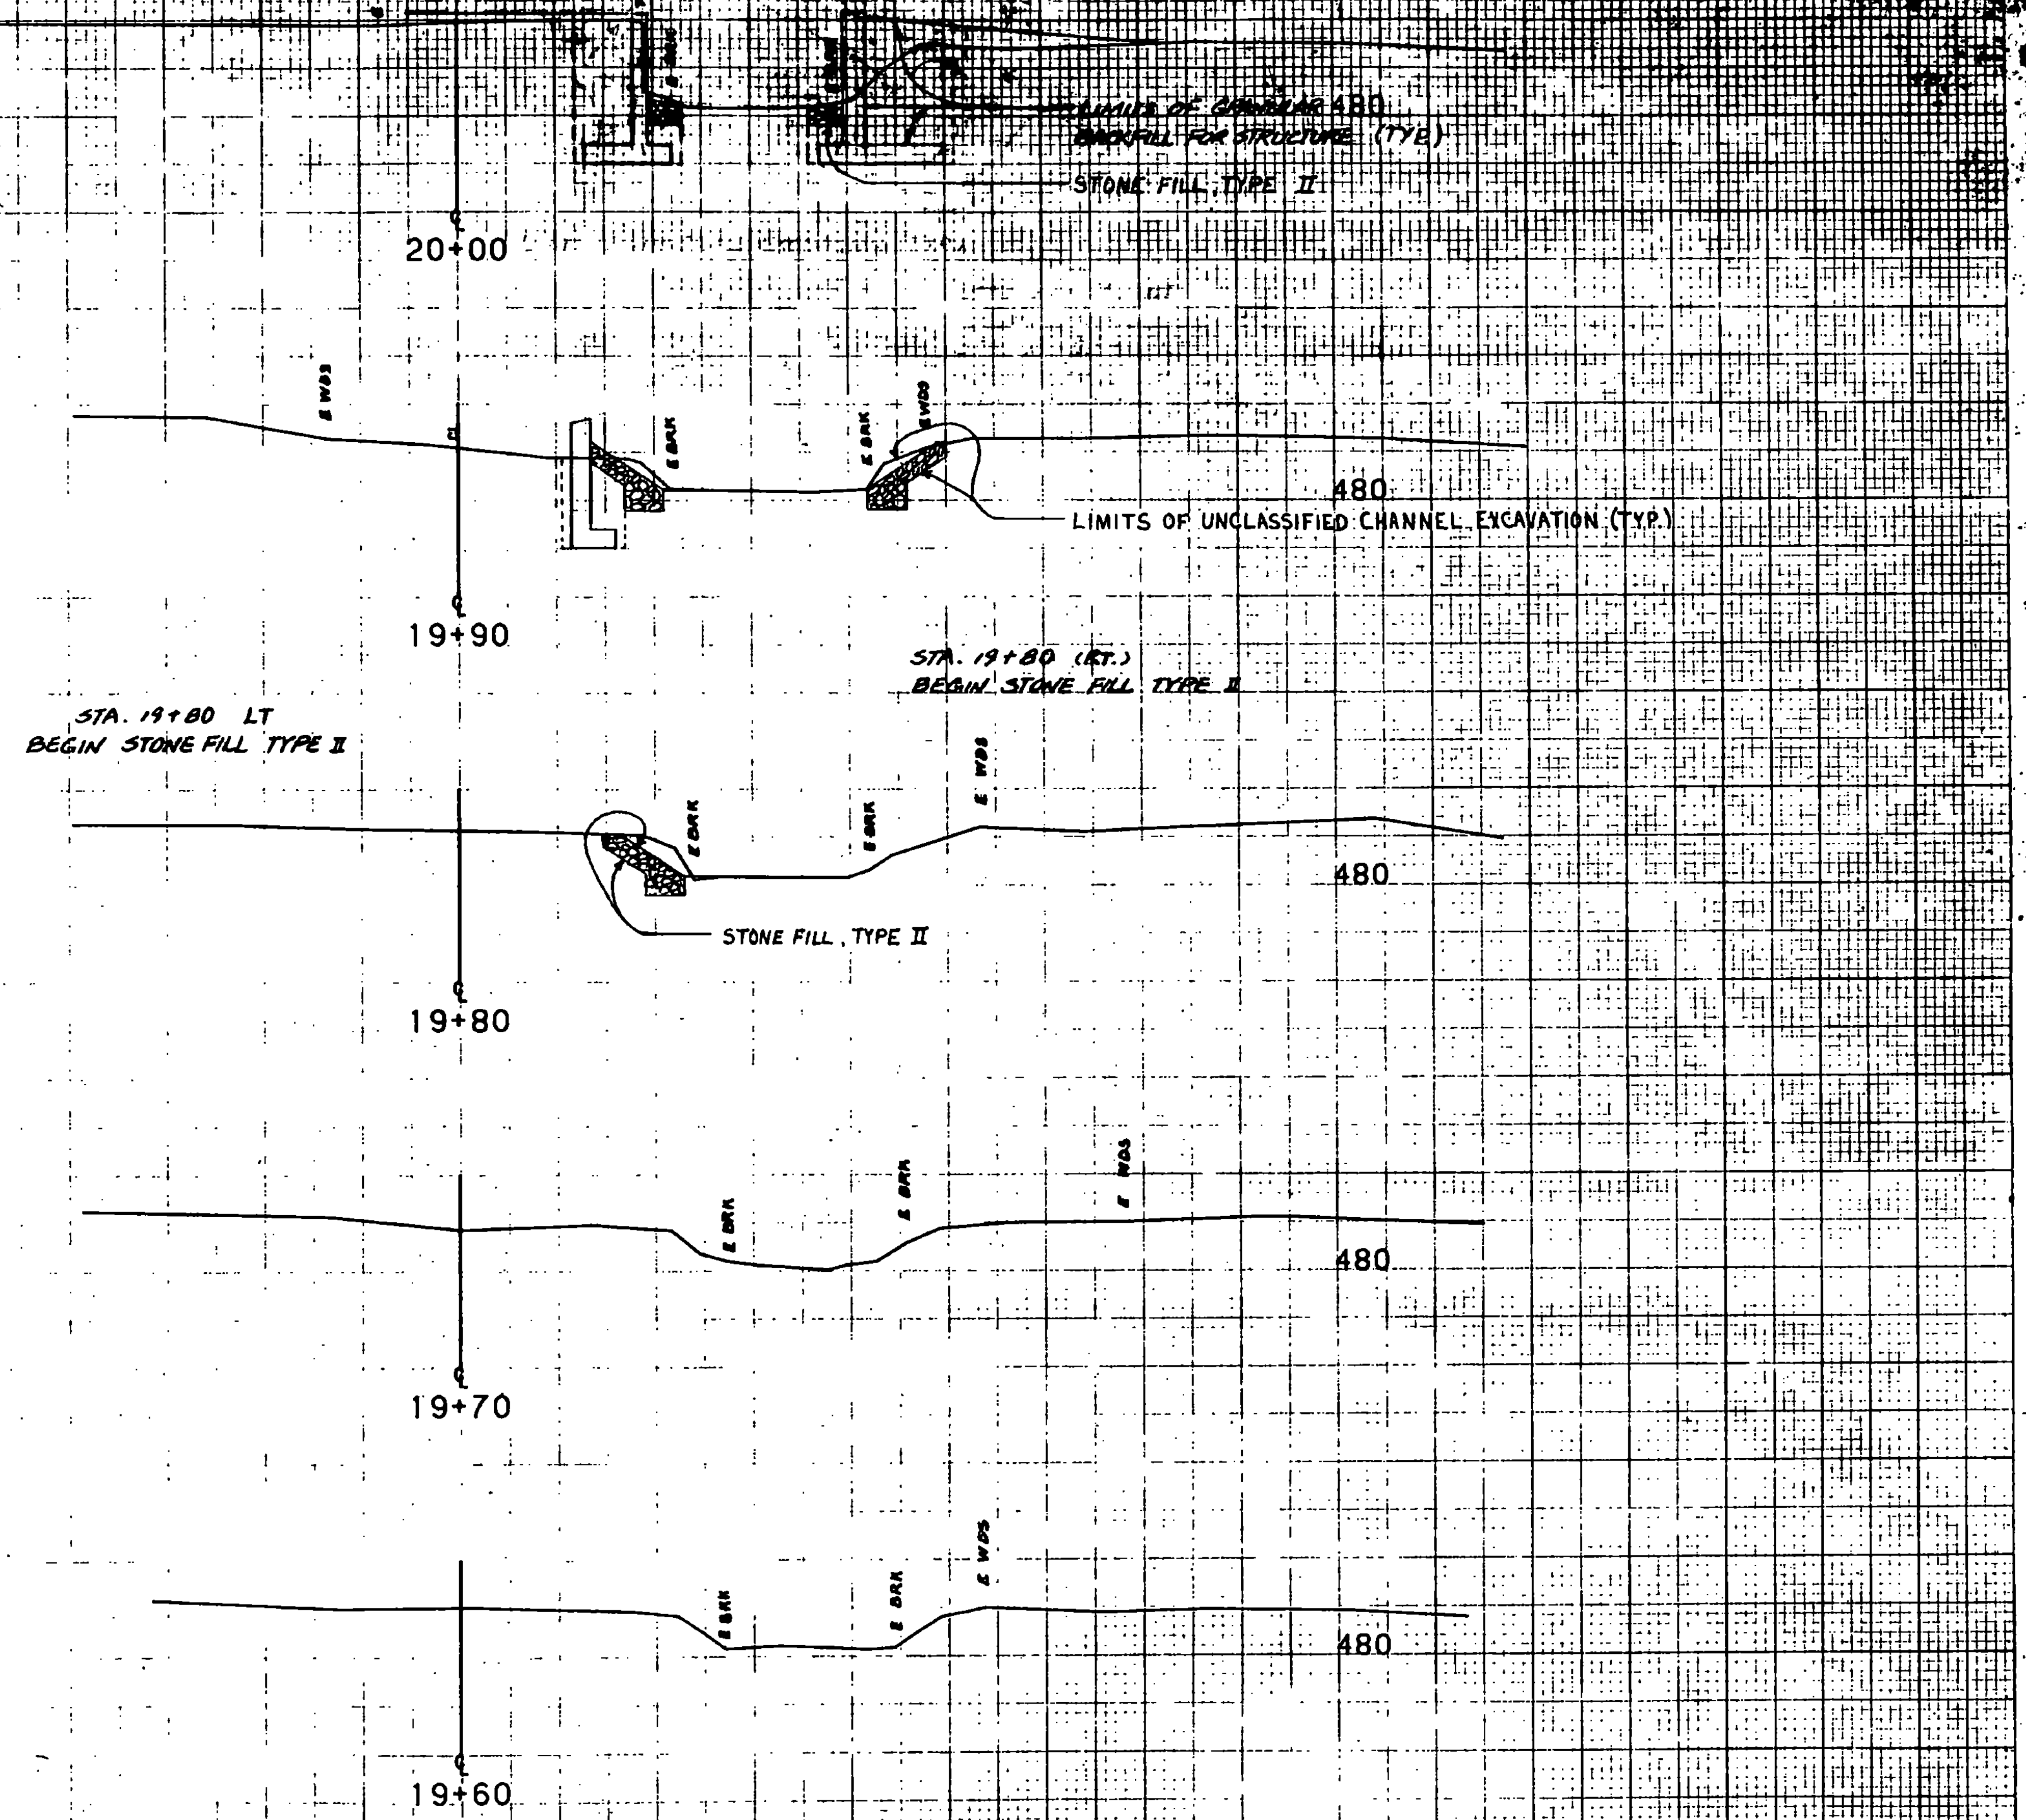

FROM STA.	19+60	TO STA.	20+00
PROJECT NAME	CHELSEA CHANNEL SECTIONS		
NO.	TH3808	PLOTTED	04/19/00
SURVEYED BY	P. NYE	DATE	02/28/01
SHEET	77	OF	79

SCALE 1" = 10 FEET