


STA 20+50 (L.T. & R.T.)  
END UNCLASSIFIED CHANNEL EXCAVATION

STA 20+49 L.T.  
END STONE FILL TYPE I

STA 20+47 (R.T.)  
END STONE FILL TYPE II  
STA 20+42 (R.T.) END STRUCTURE EXCAVATION  
2 STONE FILL TYPE I

NOTE: GRUBBING MATERIAL AND  
GEOTEXTILE FABRIC FOR  
FILTER NOT SHOWN FOR CLARITY.

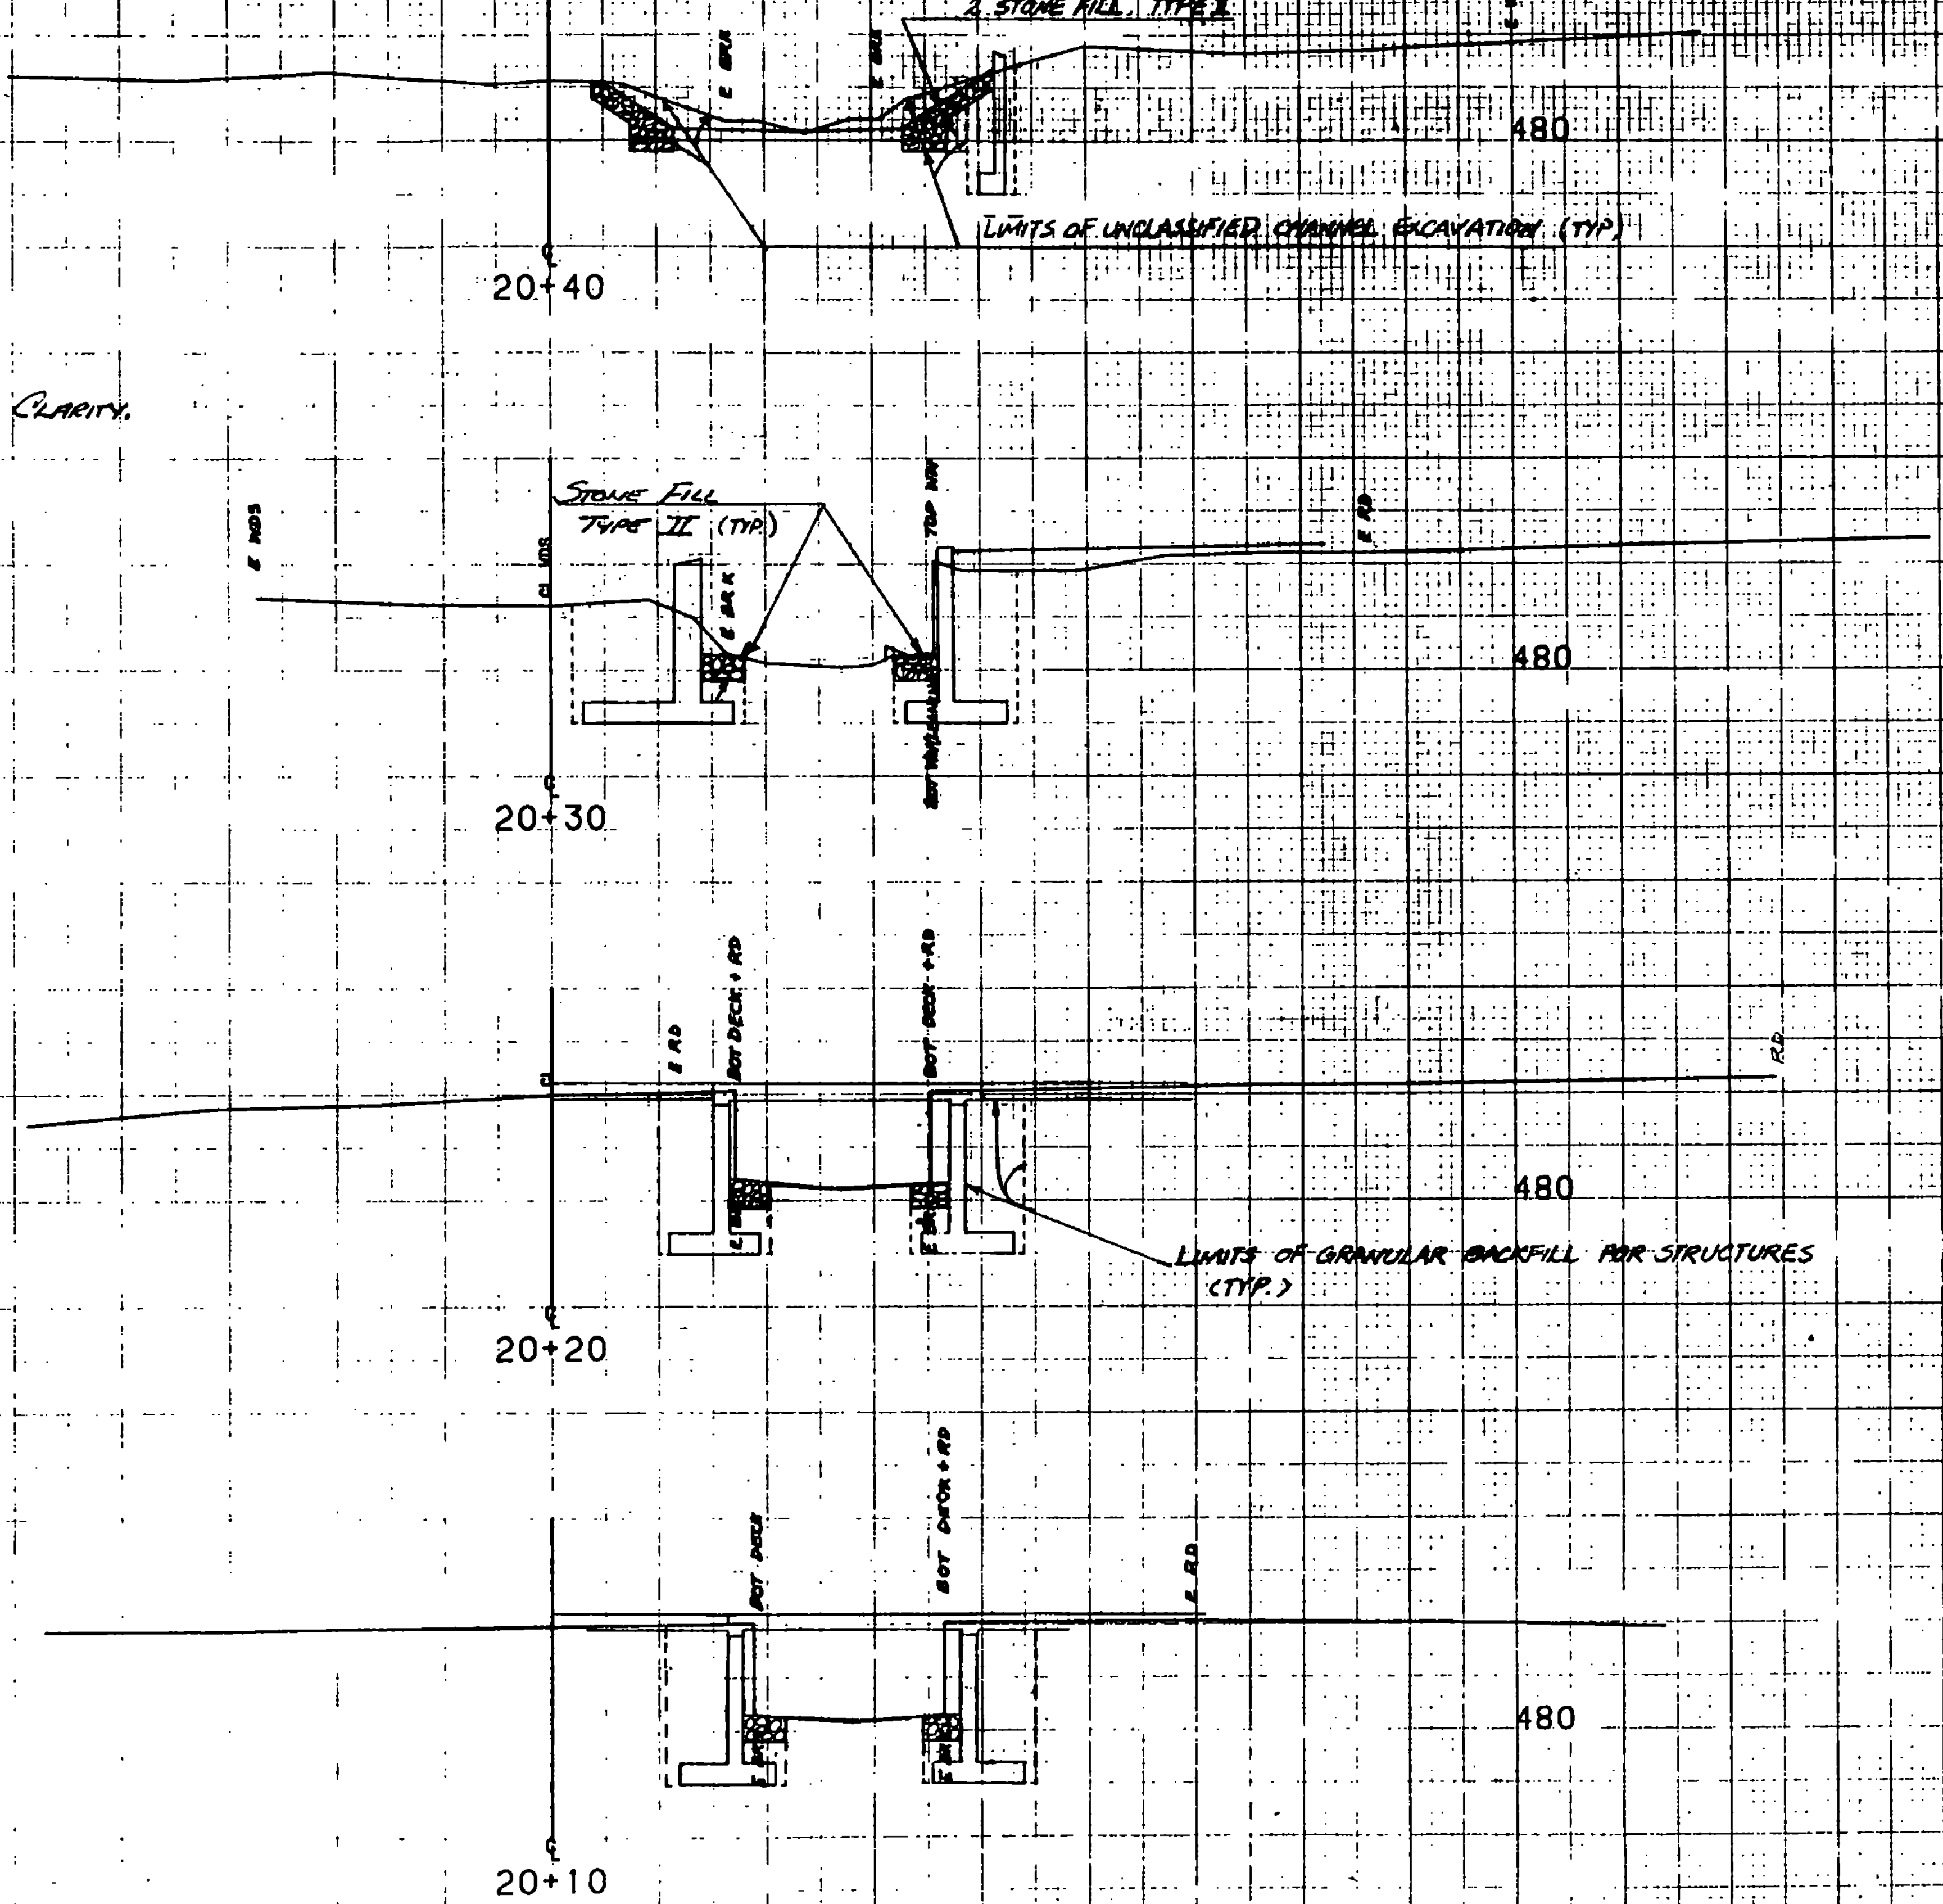

FROM STA.	20+10	TO STA.	20+40
PROJECT NAME	CHELSEA CHANNEL		
NO.	TH3806		
SURVEYED BY	P. NYE		
SHEET	73	OF	123 SHEETS

SCALE 1" = 10 FEET

PLOTTED 04/12/88