
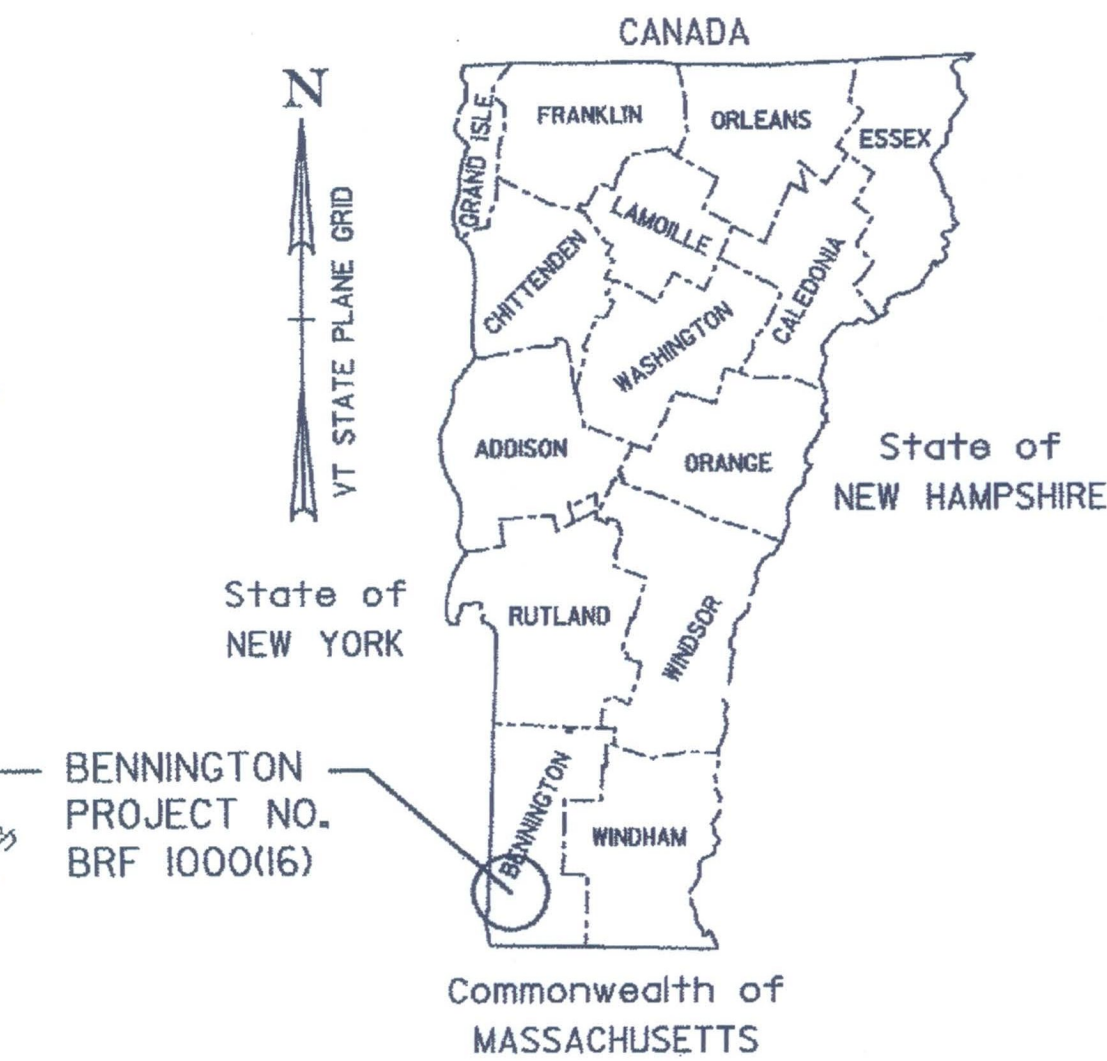
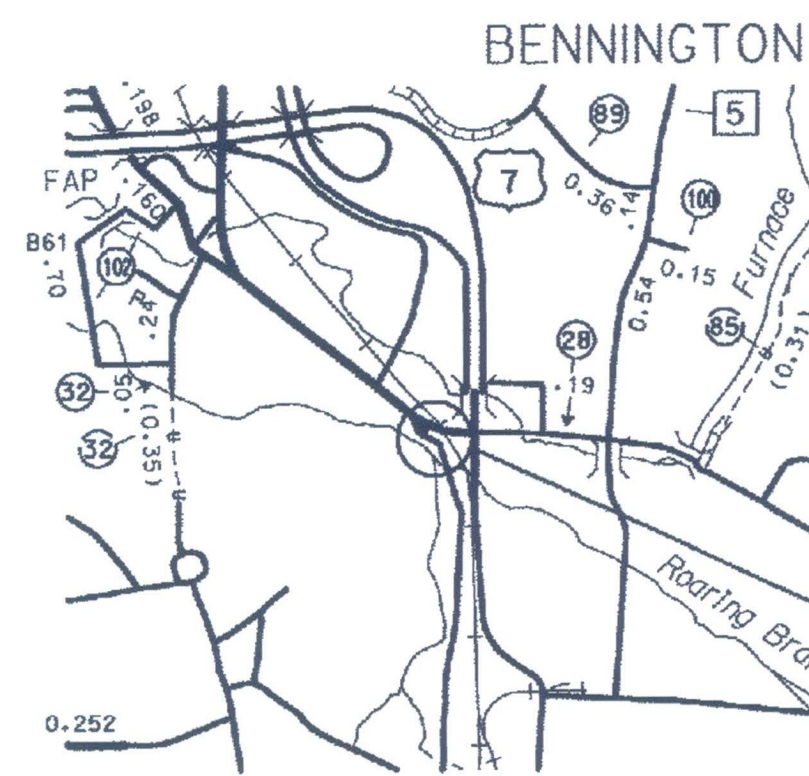


STATE OF VERMONT AGENCY OF TRANSPORTATION

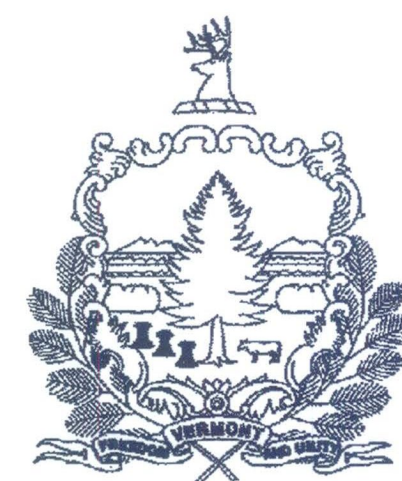

| RECORD PLANS | |
|--|--|
| CONTRACTOR: | ALPINE CONSTRUCTION, LLC - SCHUYLerville, NY |
| RESIDENT ENGINEER: | RON LEMAIRE |
| CONSTRUCTION BEGAN: | MARCH 09, 2015 |
| CONSTRUCTION COMPLETE: | JUNE 05, 2017 |
| RECORD PLANS BY: | RON LEMAIRE & AARON WEAVER |
| I HEREBY CERTIFY THAT ALL THE CONSTRUCTION REQUIRED BY THIS SET OF DRAWINGS HAS BEEN ACCOMPLISHED AS INDICATED HEREIN. | |
| BY: | <i>[Signature]</i> For RESIDENT ENGINEER |
| DATE: | May 29, 2018 |
| NOTE: Any further information concerning final quantities, amounts or other details relative to this project may be found by contacting Vtrans Records Management. | |


PROPOSED IMPROVEMENT BRIDGE PROJECT TOWN OF BENNINGTON COUNTY OF BENNINGTON BENMONT AVE. (TH-7) (URBAN MINOR ARTERIAL) BRIDGE NO. 57

PROJECT LOCATION

BEGINNING ON BENMONT AVENUE APPROXIMATELY 0.08 MILES NORTH OF ITS INTERSECTION WITH HUNT STREET AND EXTENDING NORTHERLY ALONG BENMONT AVENUE APPROXIMATELY 309 FEET (0.06 MILES).


STRUCTURE LENGTH: 269.16 FEET
ROADWAY LENGTH: 40.04 FEET
PROJECT LENGTH: 309.20 FEET

WORK TO BE PERFORMED UNDER THIS PROJECT INCLUDES REPLACEMENT OF BRIDGE #57 WITH A NEW BRIDGE ON EXISTING ALIGNMENT WITH CHANNEL WORK AND OTHER RELATED HIGHWAY ITEMS.

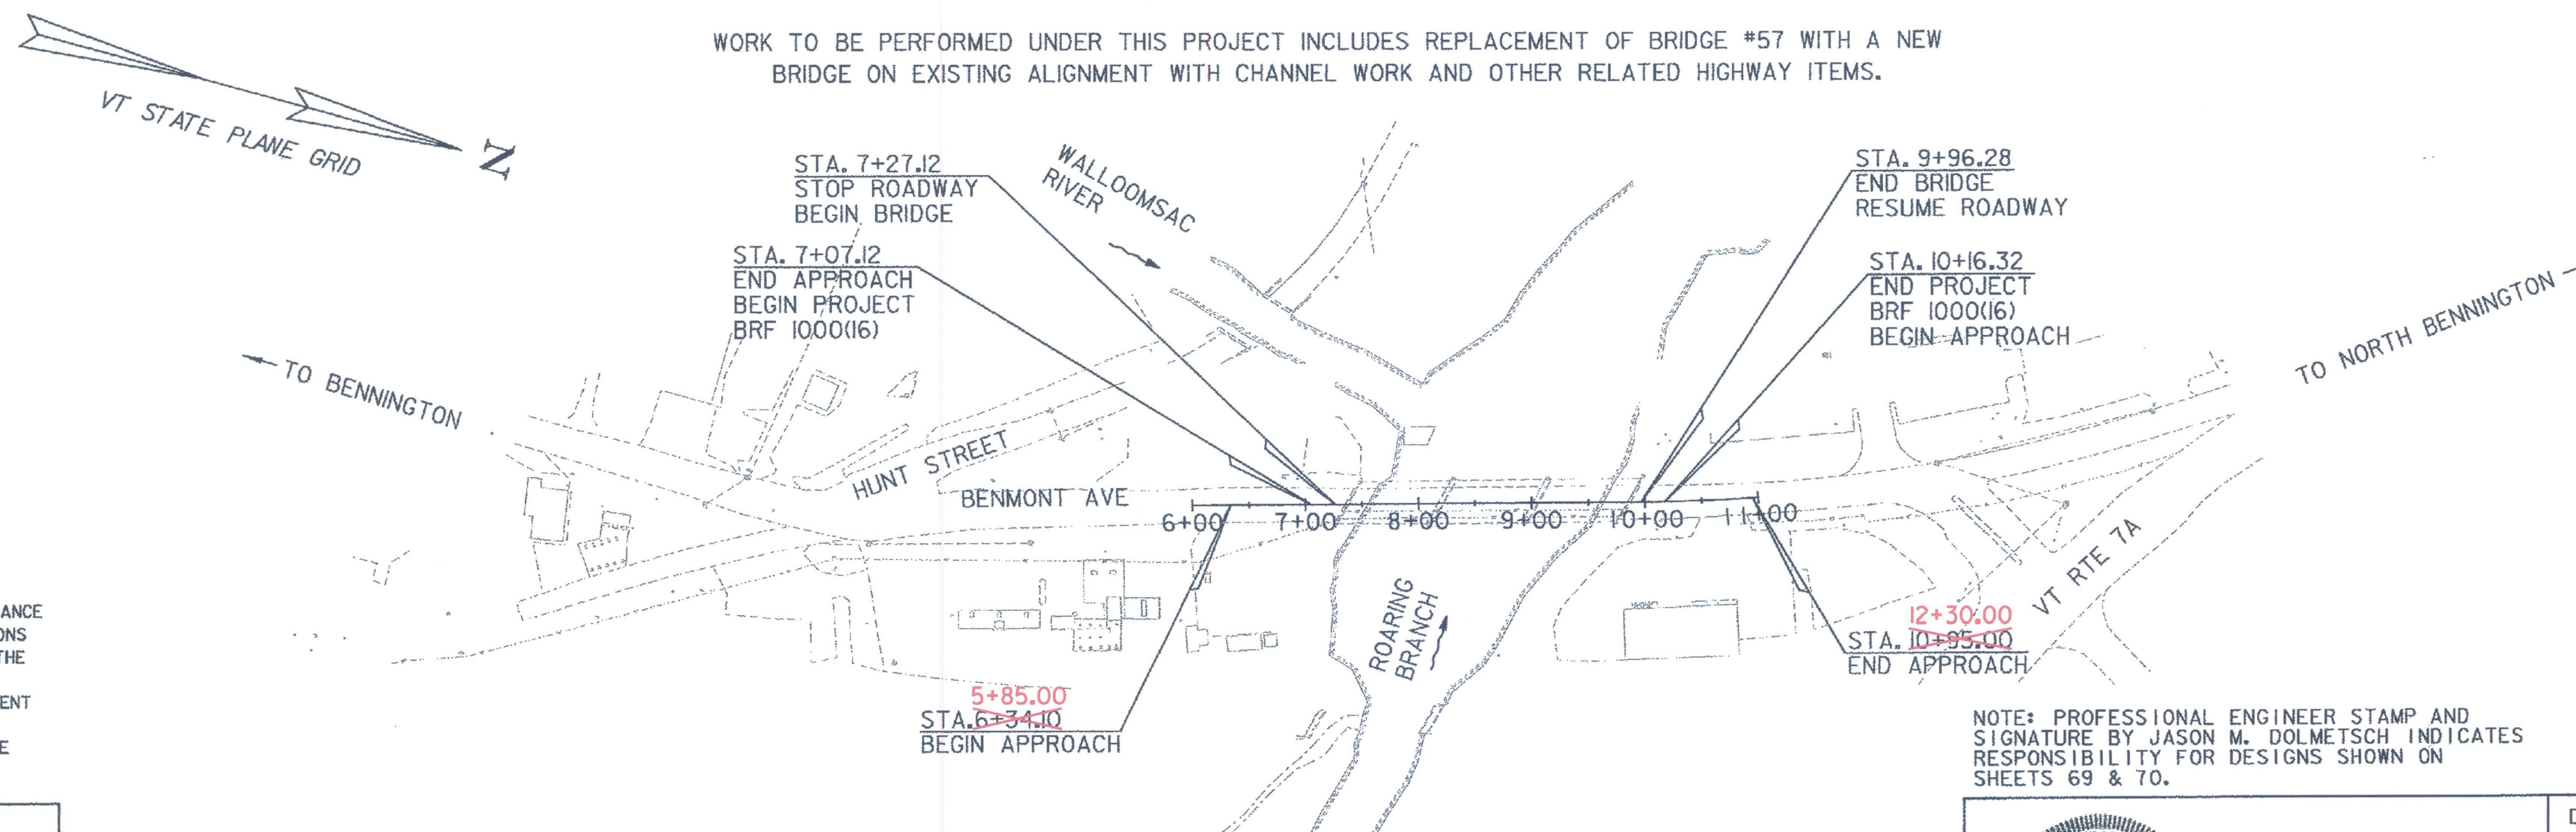

CONSTRUCTION IS TO BE CARRIED ON IN ACCORDANCE WITH THESE PLANS AND THE STANDARD SPECIFICATIONS FOR CONSTRUCTION DATED 2011, AS APPROVED BY THE FEDERAL HIGHWAY ADMINISTRATION ON JULY 20, 2011 FOR USE ON THIS PROJECT, INCLUDING ALL SUBSEQUENT REVISIONS AND SUCH REVISED SPECIFICATIONS AND SPECIAL PROVISIONS AS ARE INCORPORATED IN THESE PLANS.

| | |
|--|-------------|
| QUALITY ASSURANCE PROGRAM : LEVEL 2 | |
| SURVEYED BY : L. ORVIS PC & R. BULLOCK - L. ORVIS PC & G. HITCHCOCK | |
| SURVEYED DATE : 3/16/98 - 10/23/06 | |
| DATUM | |
| VERTICAL | NAVD 88 |
| HORIZONTAL | NAD 83 (92) |

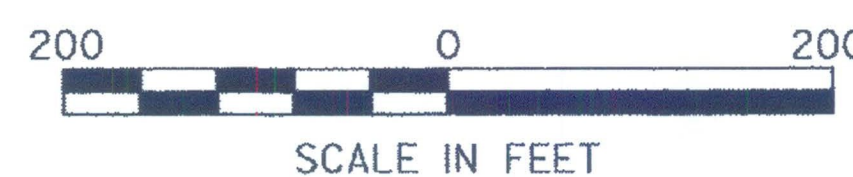

NOTE: PROFESSIONAL ENGINEER STAMP AND SIGNATURE BY JASON M. DOLMETSCH INDICATES RESPONSIBILITY FOR DESIGNS SHOWN ON SHEETS 69 & 70.

| | |
|----------------------|---|
| | DIRECTOR OF PROJECT DELIVERY |
| | APPROVED <i>[Signature]</i> DATE 8/1/2014 |
| | PROJECT MANAGER : DOUGLAS BONNEAU, P.E. |
| | PROJECT NAME : BENNINGTON PROJECT NUMBER : BRF 1000 (16) |
| TYLIN INTERNATIONAL | |
| SHEET 1 OF 75 SHEETS | |