 

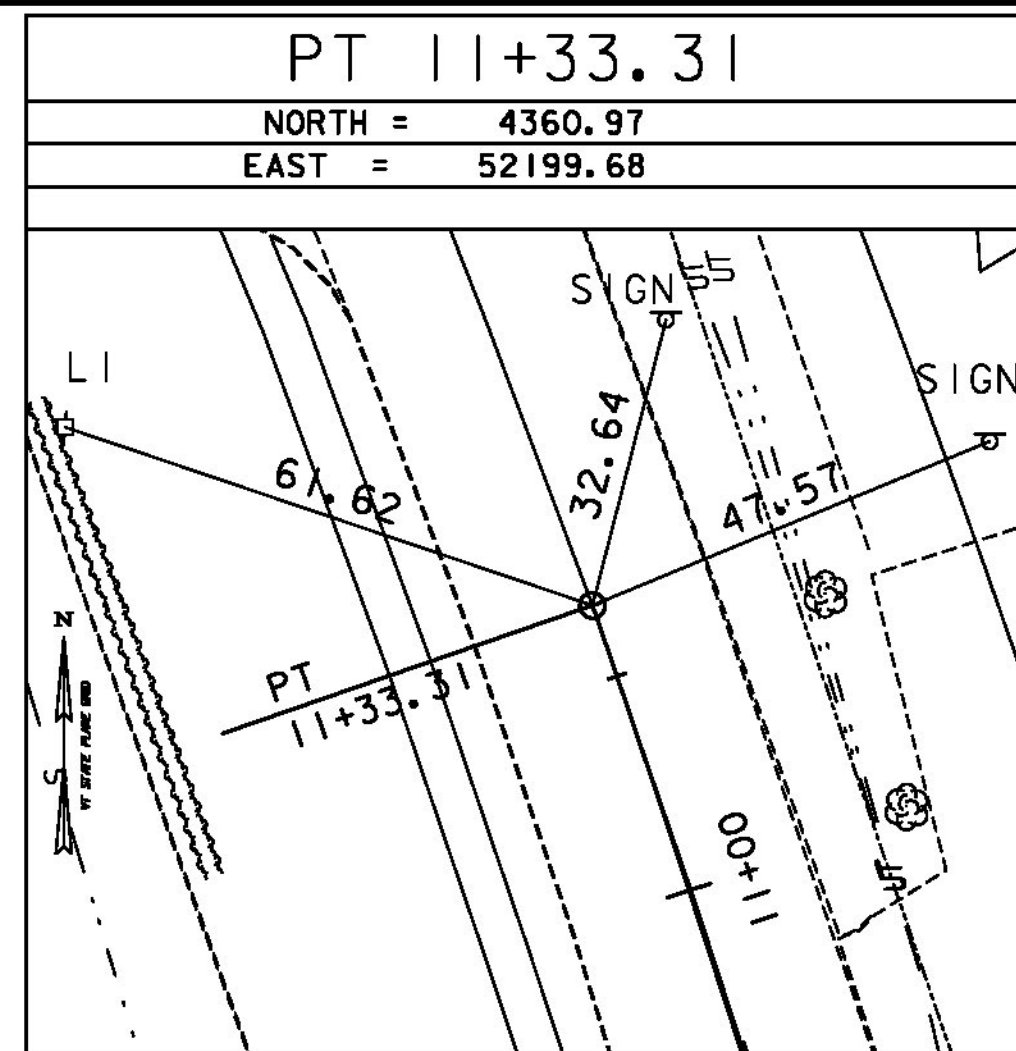
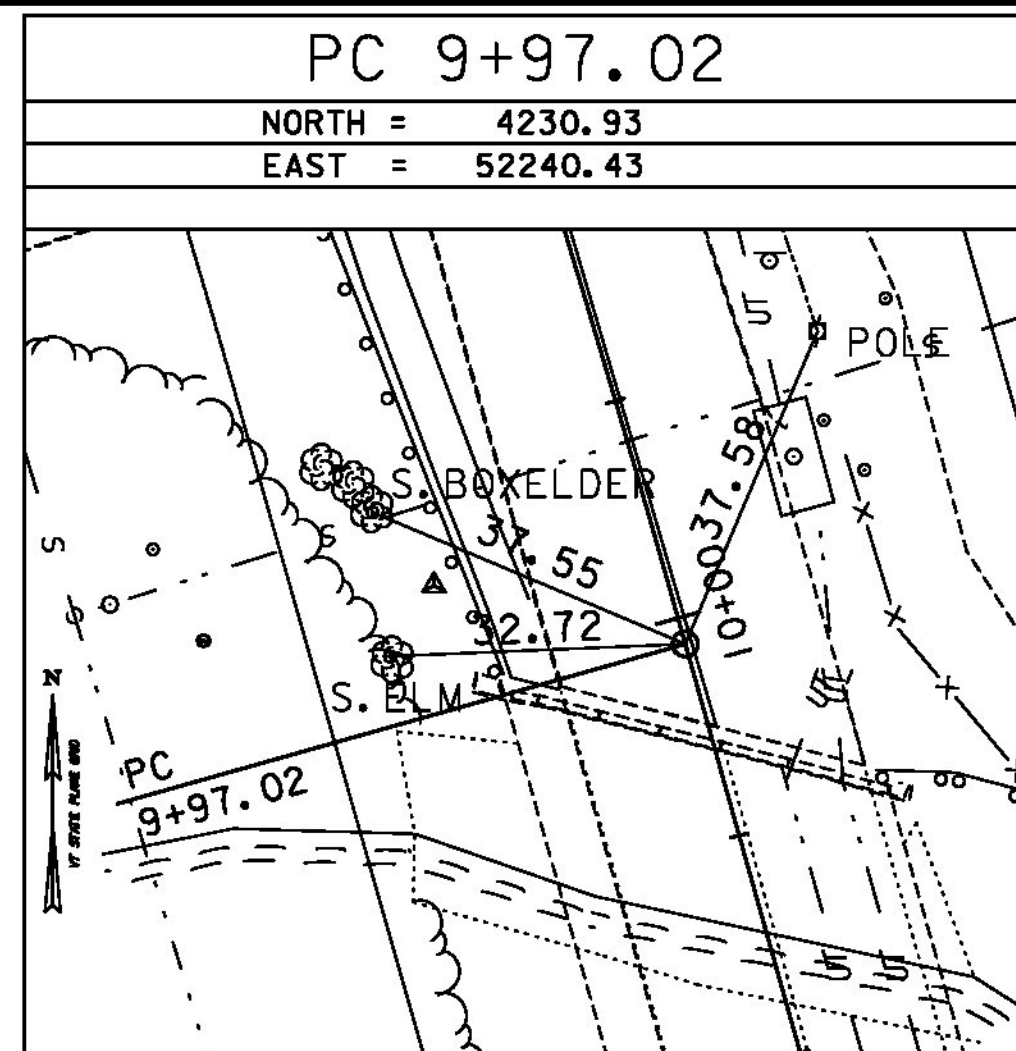
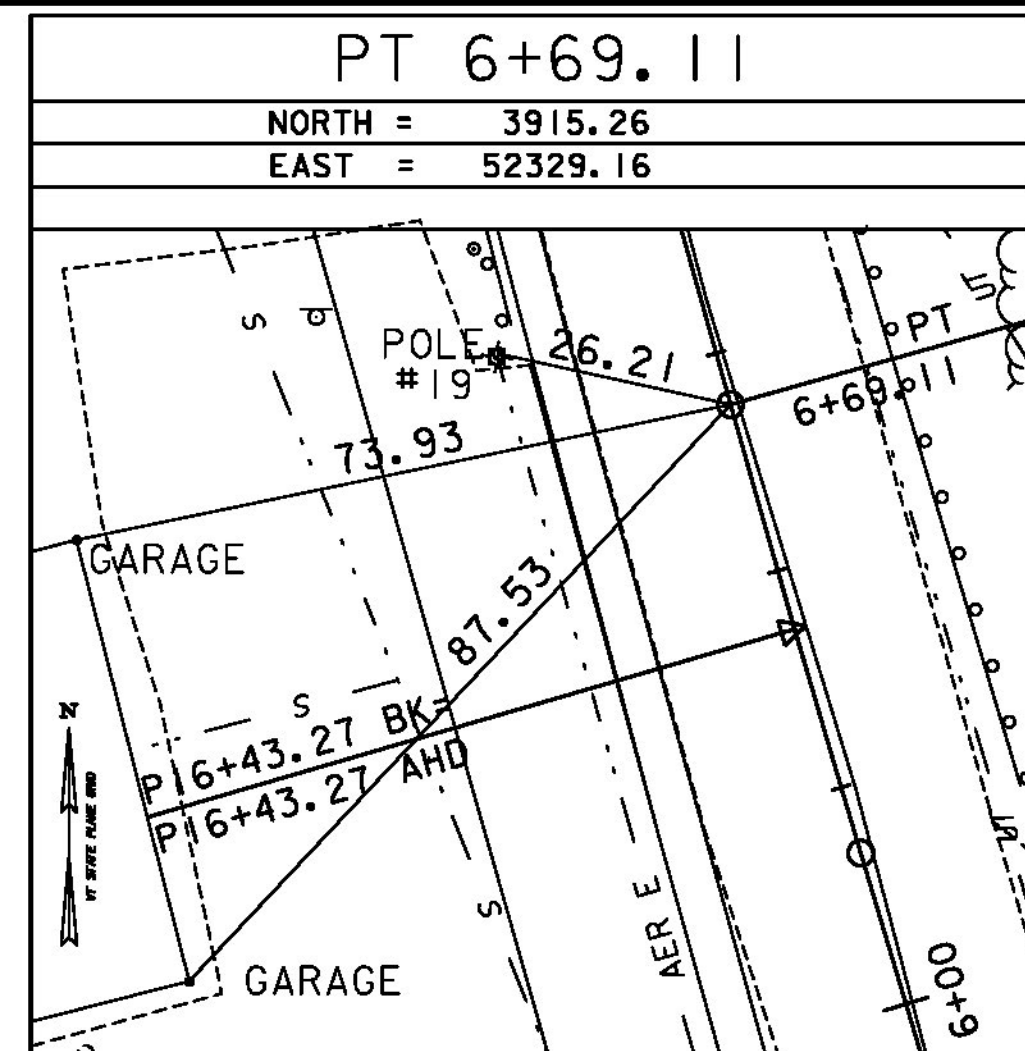


ALIGNMENT TIES

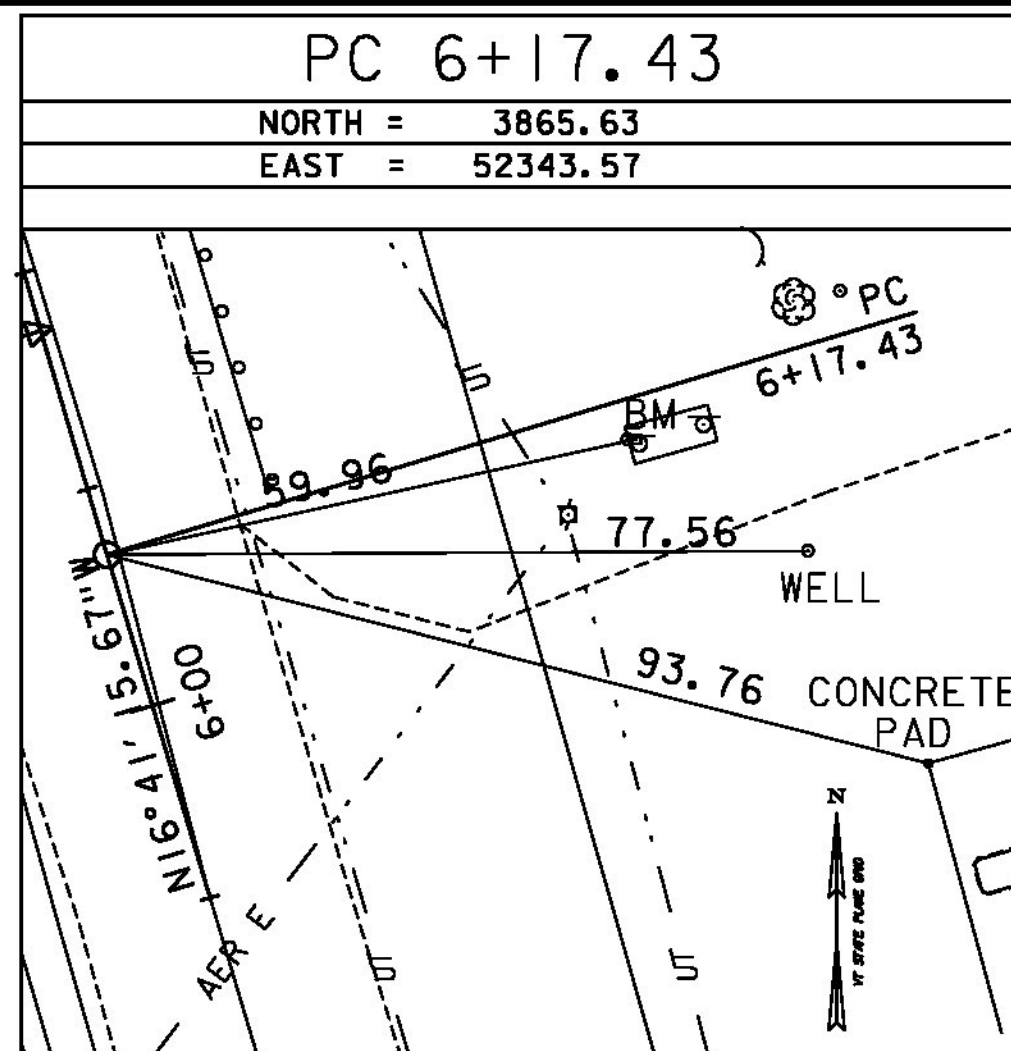

DATUM	
VERTICAL	NAVD 88
HORIZONTAL	NAD 83 (92)
ADJUSTMENT	COMPASS

PROJECT NAME:	BENNINGTON
PROJECT NUMBER:	BRF 1000(16)
FILE NAME:	z88j087bdr_11.dgn
PROJECT LEADER:	R. HEBERT
DESIGNED BY:	D. BURHANS
ALIGNMENT TIE SHEET	
PLOT DATE:	8/7/2014
DRAWN BY:	D. BURHANS
CHECKED BY:	D. BRYANT
SHEET 13	OF 75