

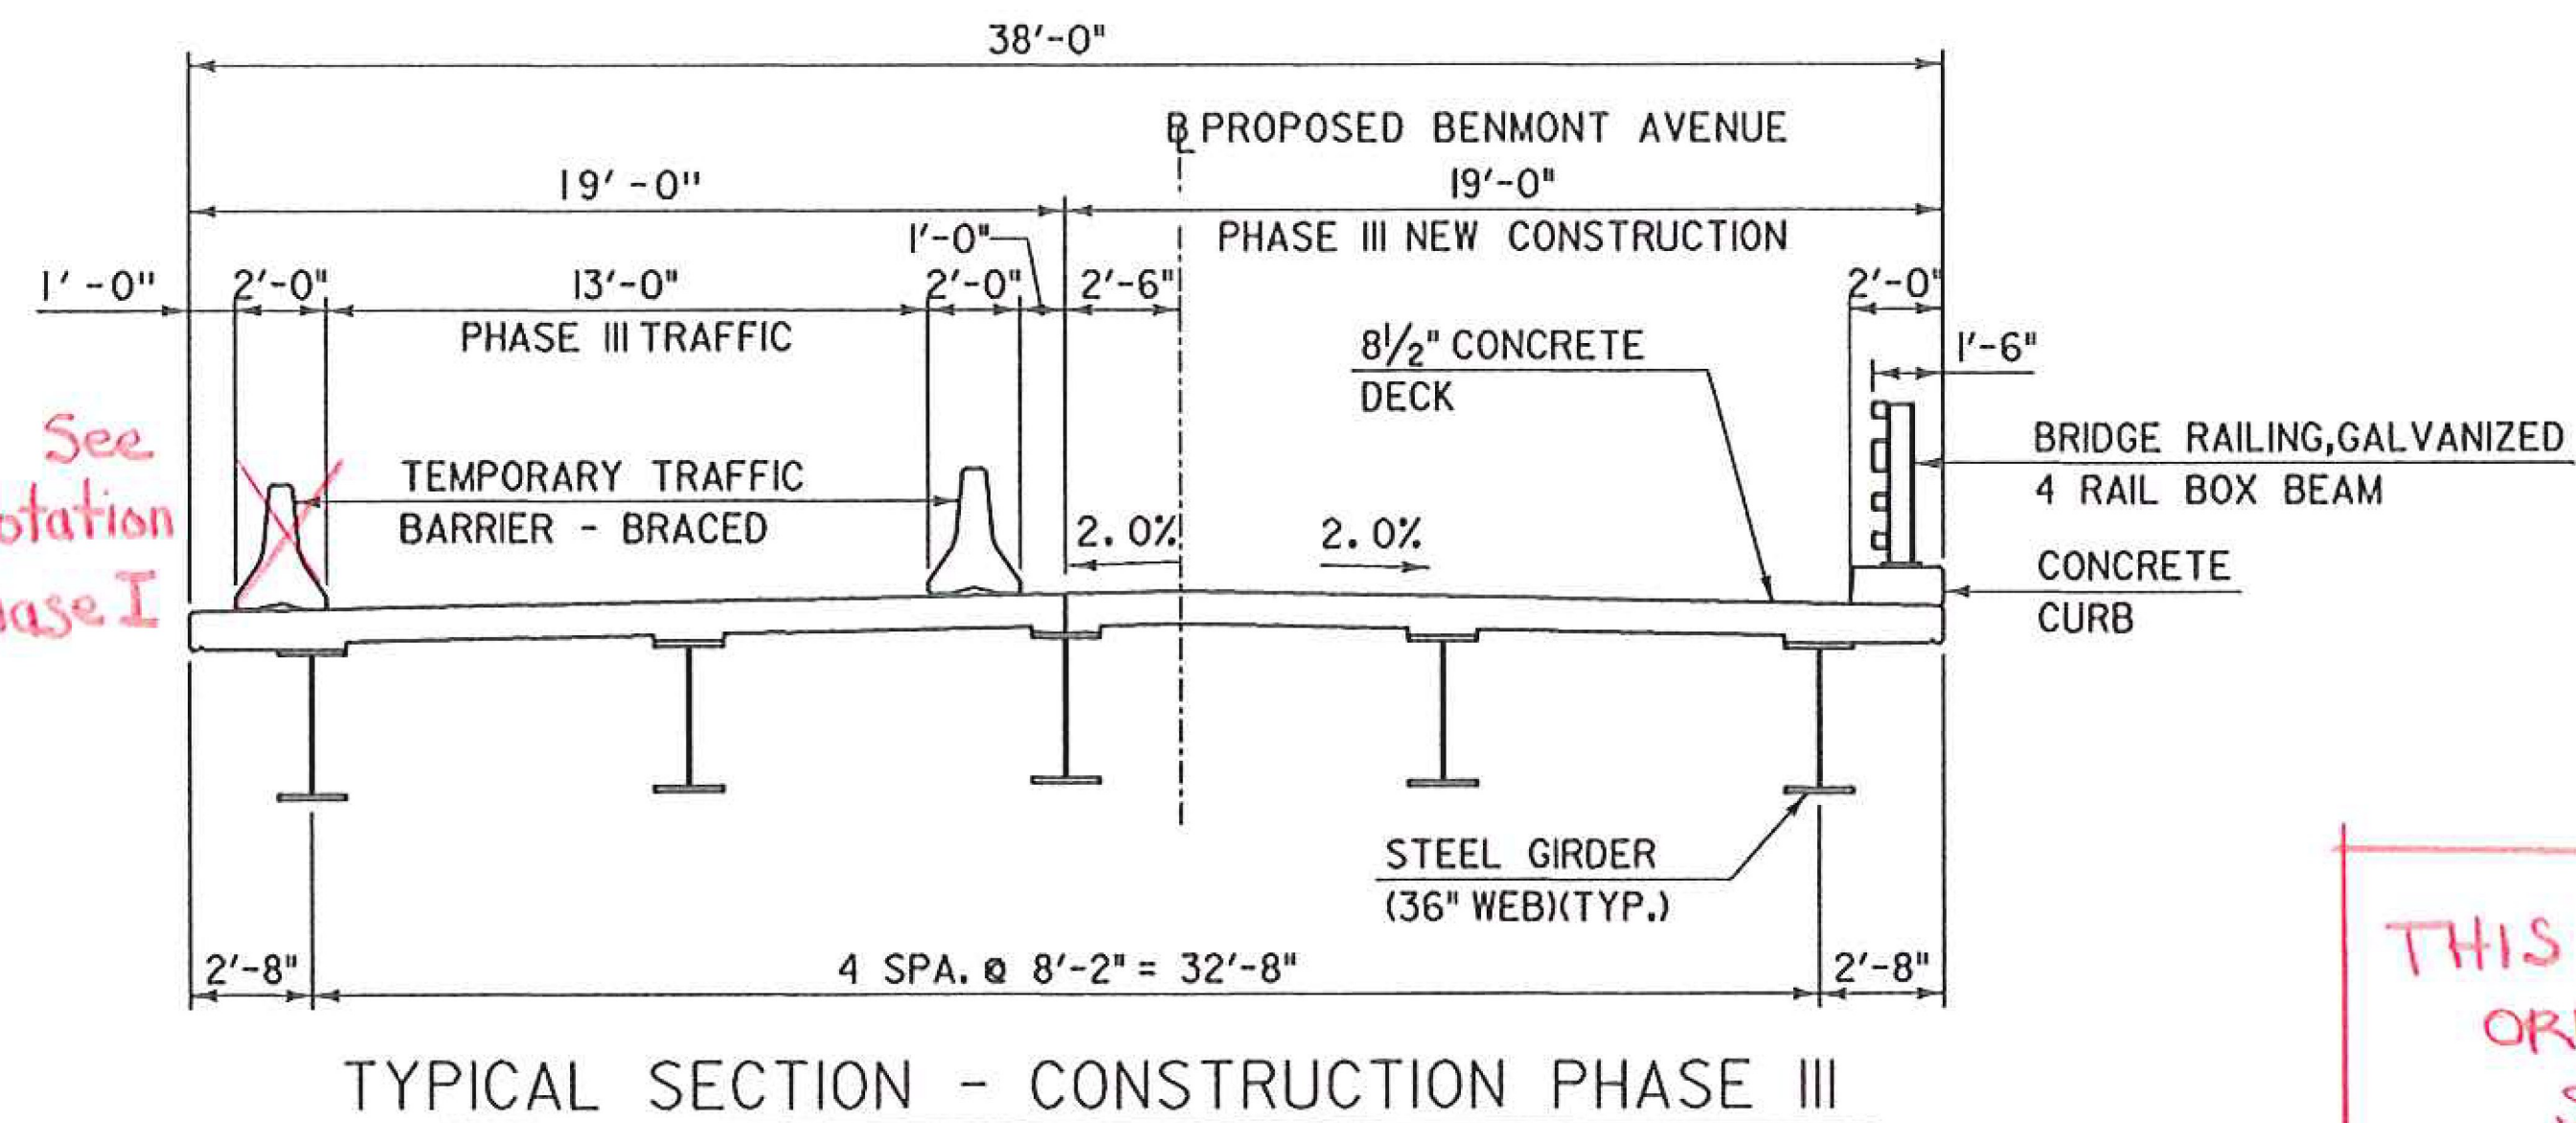
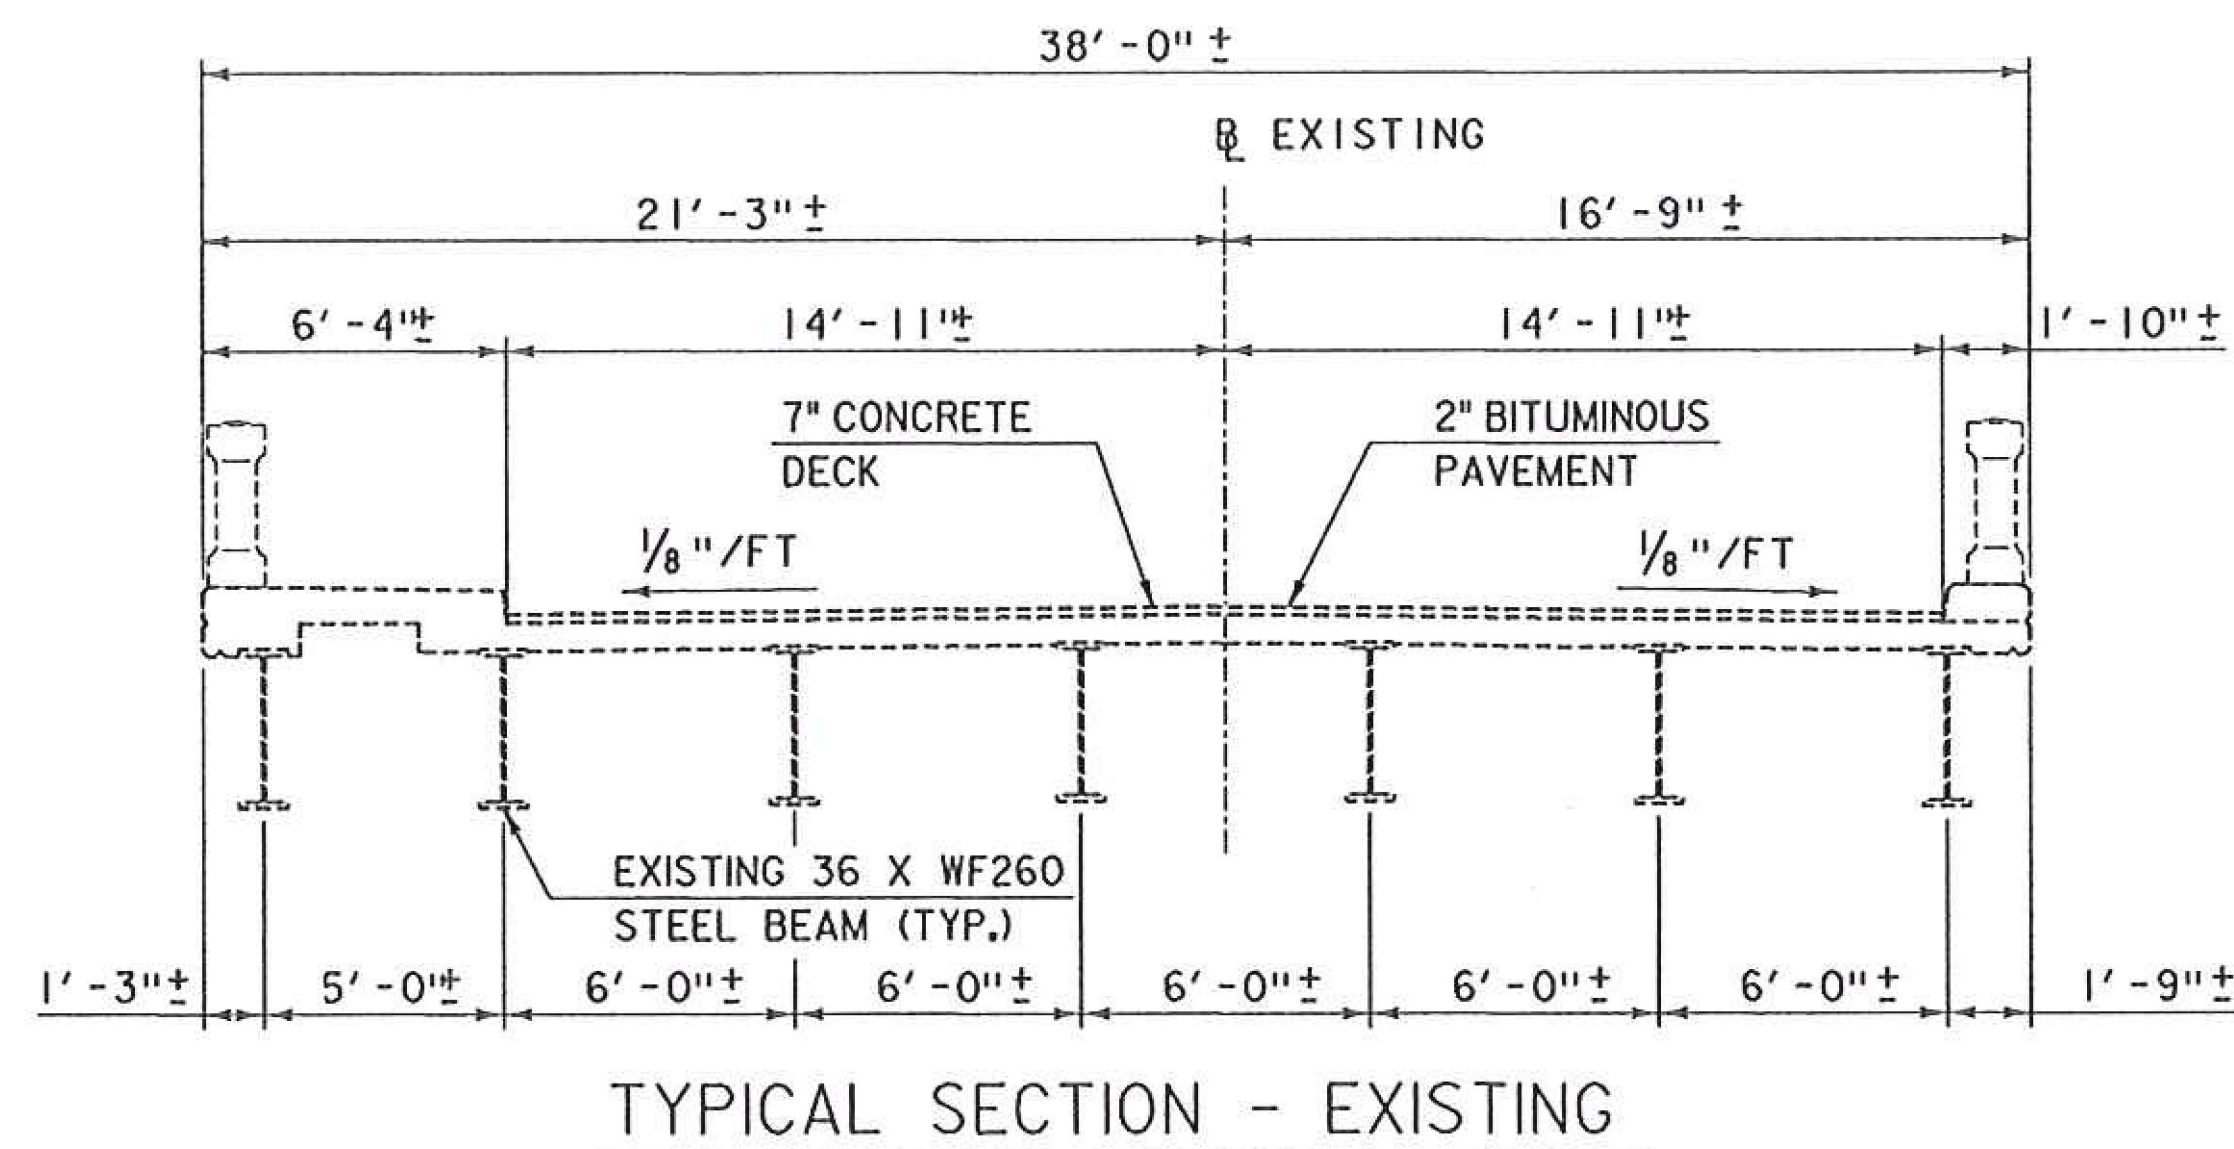


RECORD PLANS


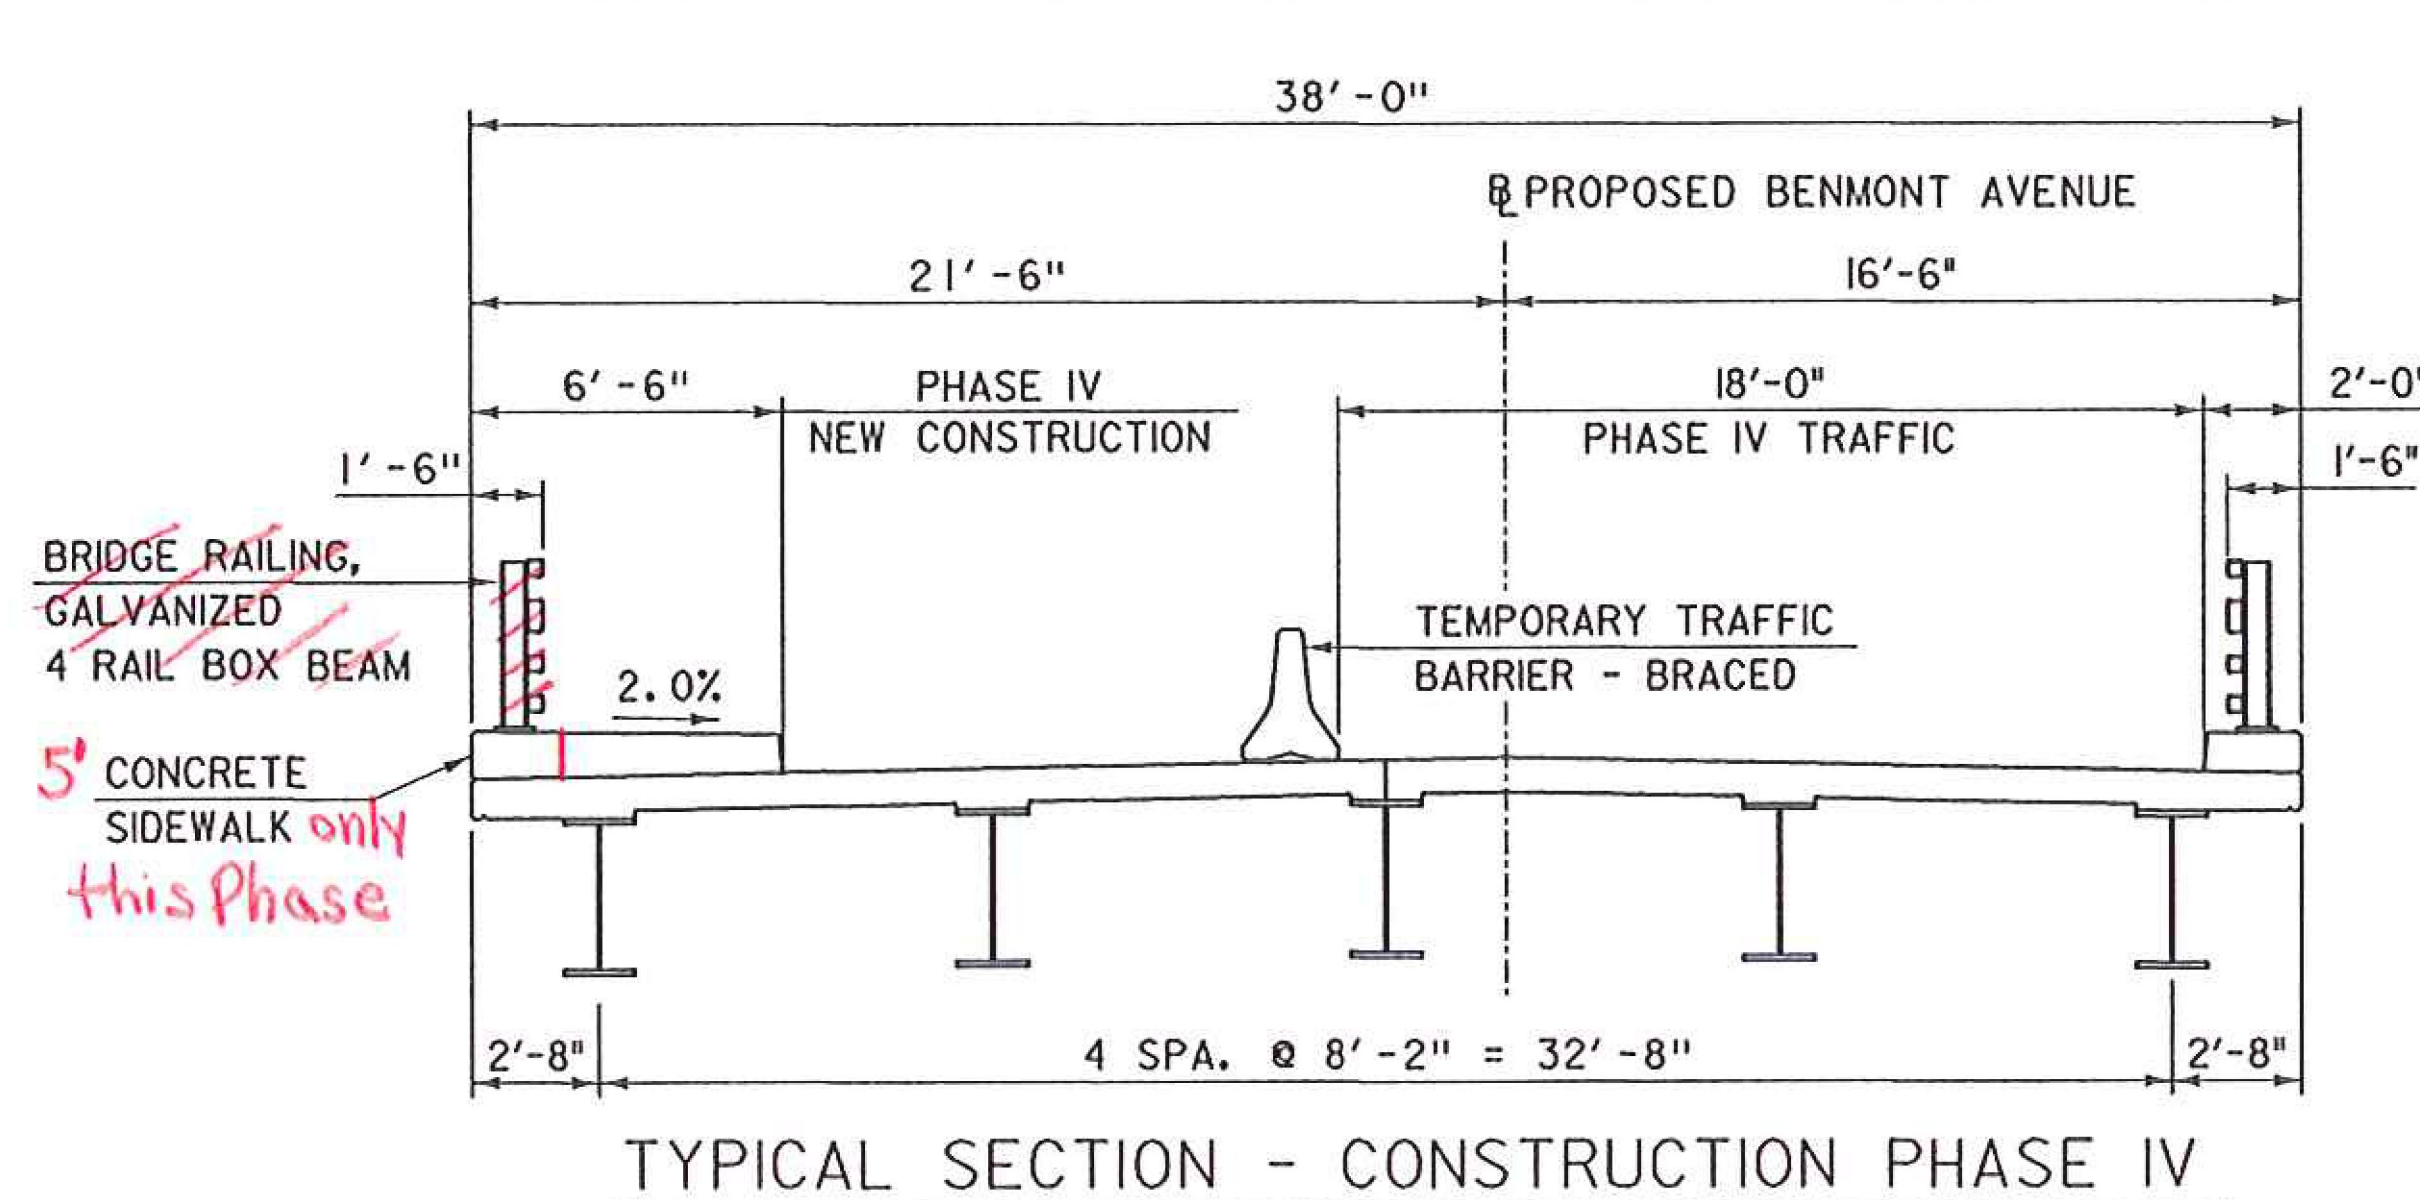


THIS SHEET REPLACES ORIGINAL CONTRACT SHEET 18

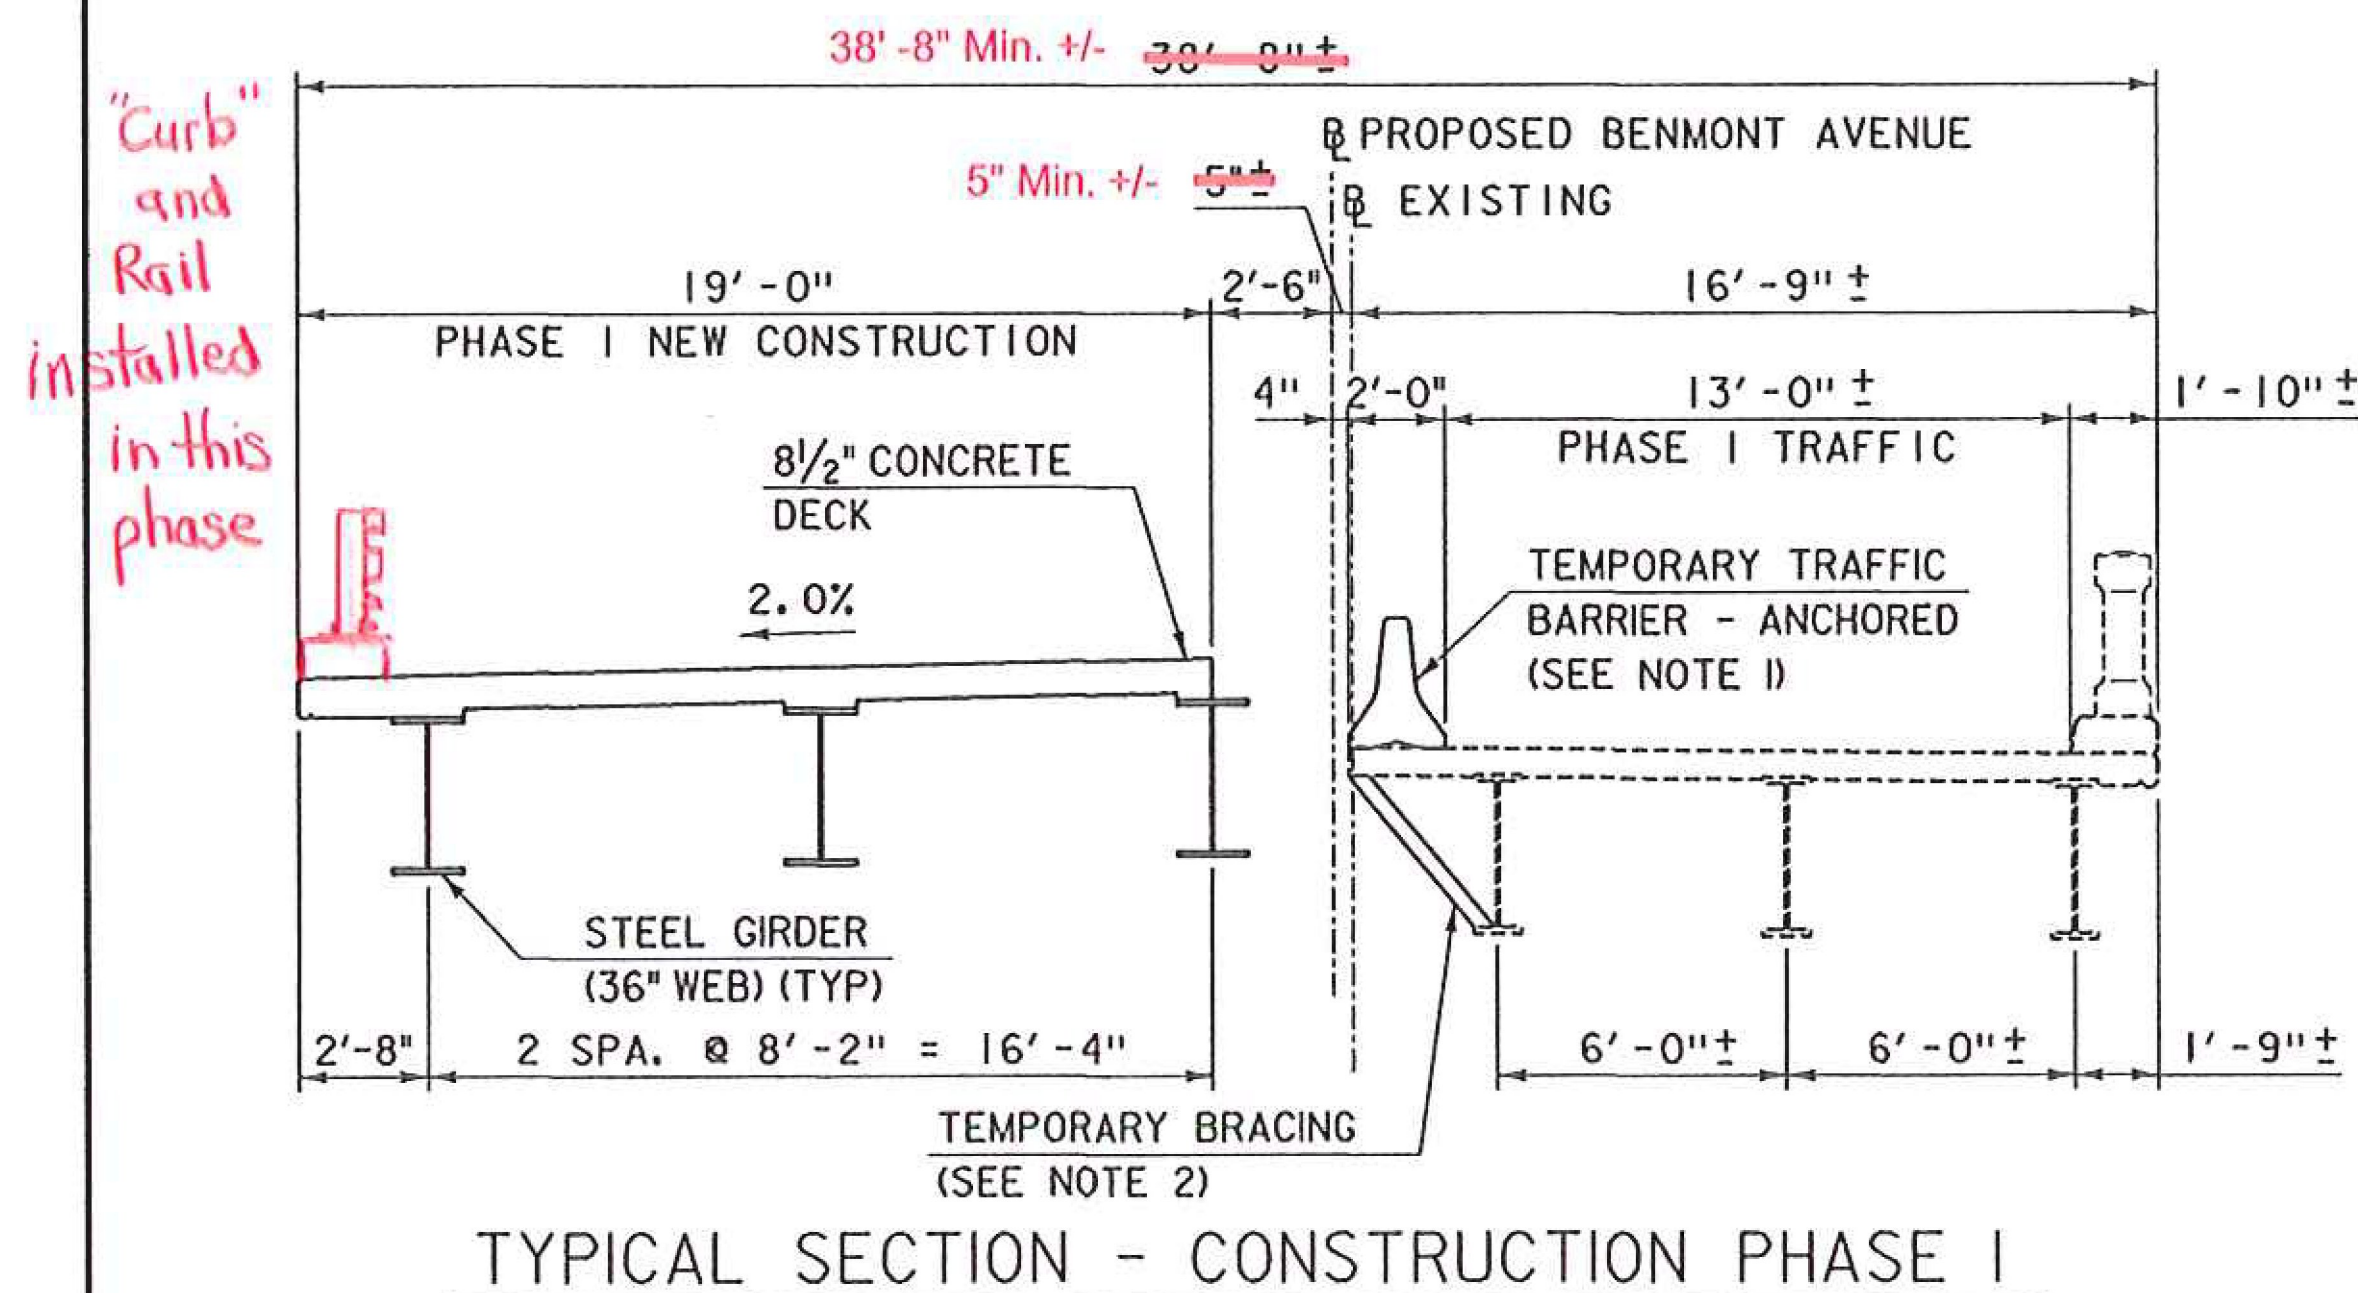

NOTES:

1. ANCHORED TEMPORARY TRAFFIC BARRIER SHALL MEET THE REQUIREMENTS FOR BRIDGE RAIL PERFORMANCE OF SECTION 621. THE DESIGN OF BARRIER CONNECTIONS, INCLUDING BUT NOT LIMITED TO SPACING OF HOLES, ANCHORAGE TYPE, AND ATTACHMENT DETAILS OF THE ANCHORED TEMPORARY TRAFFIC BARRIER SYSTEM, IS THE RESPONSIBILITY OF THE CONTRACTOR AND SHALL BE SUBMITTED TO VTRANS FOR REVIEW PER SUBSECTION 105.03(b). TEMPORARY TRAFFIC BARRIER - ANCHORED MAY BE ANCHORED TO EXISTING DECK BUT NOT TO PROPOSED DECK. PAYMENT FOR TEMPORARY TRAFFIC BARRIER - ANCHORED SHALL BE INCLUDED IN ITEM 900.645 "SPECIAL PROVISION (TRAFFIC CONTROL, ALL-INCLUSIVE)."
2. TEMPORARY BRACING TO BE DESIGNED BY CONTRACTOR. THE DESIGN AND DETAILS OF THE TEMPORARY BRACING SHALL BE SUBMITTED TO VTRANS FOR REVIEW PER SUBSECTION 105.03(b). PAYMENT FOR TEMPORARY BRACING SHALL BE INCIDENTAL TO ITEM 900.645, "SPECIAL PROVISION (TRAFFIC CONTROL, ALL-INCLUSIVE)."
3. PAYMENT FOR TEMPORARY TRAFFIC BARRIER - BRACED SHALL BE INCLUDED IN ITEM 900.645 "SPECIAL PROVISION (TRAFFIC CONTROL, ALL-INCLUSIVE)."
4. FOR TEMPORARY TRAFFIC BARRIER-BRACED DETAIL SEE SHEETS 25-26.

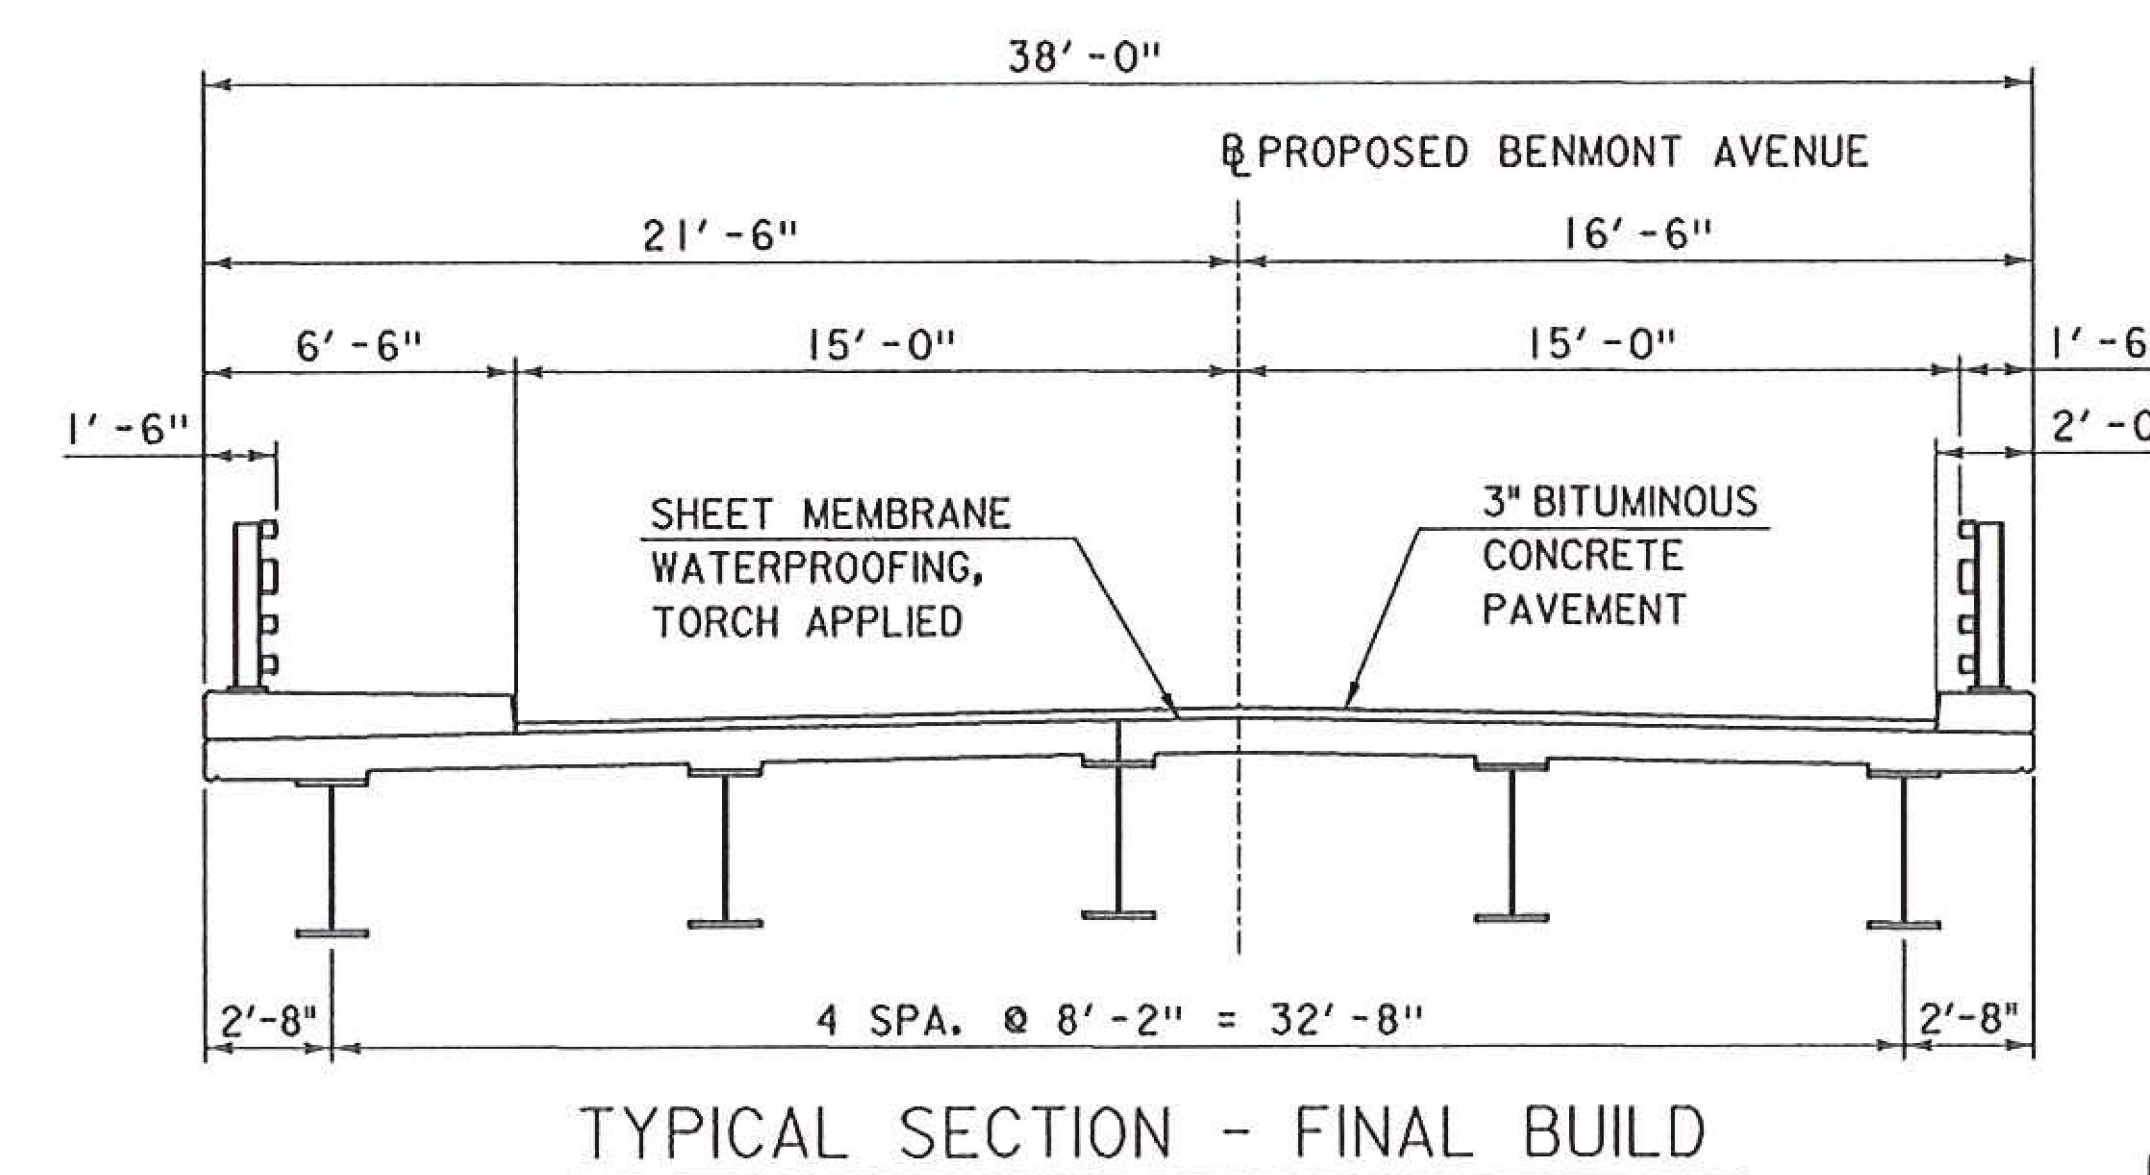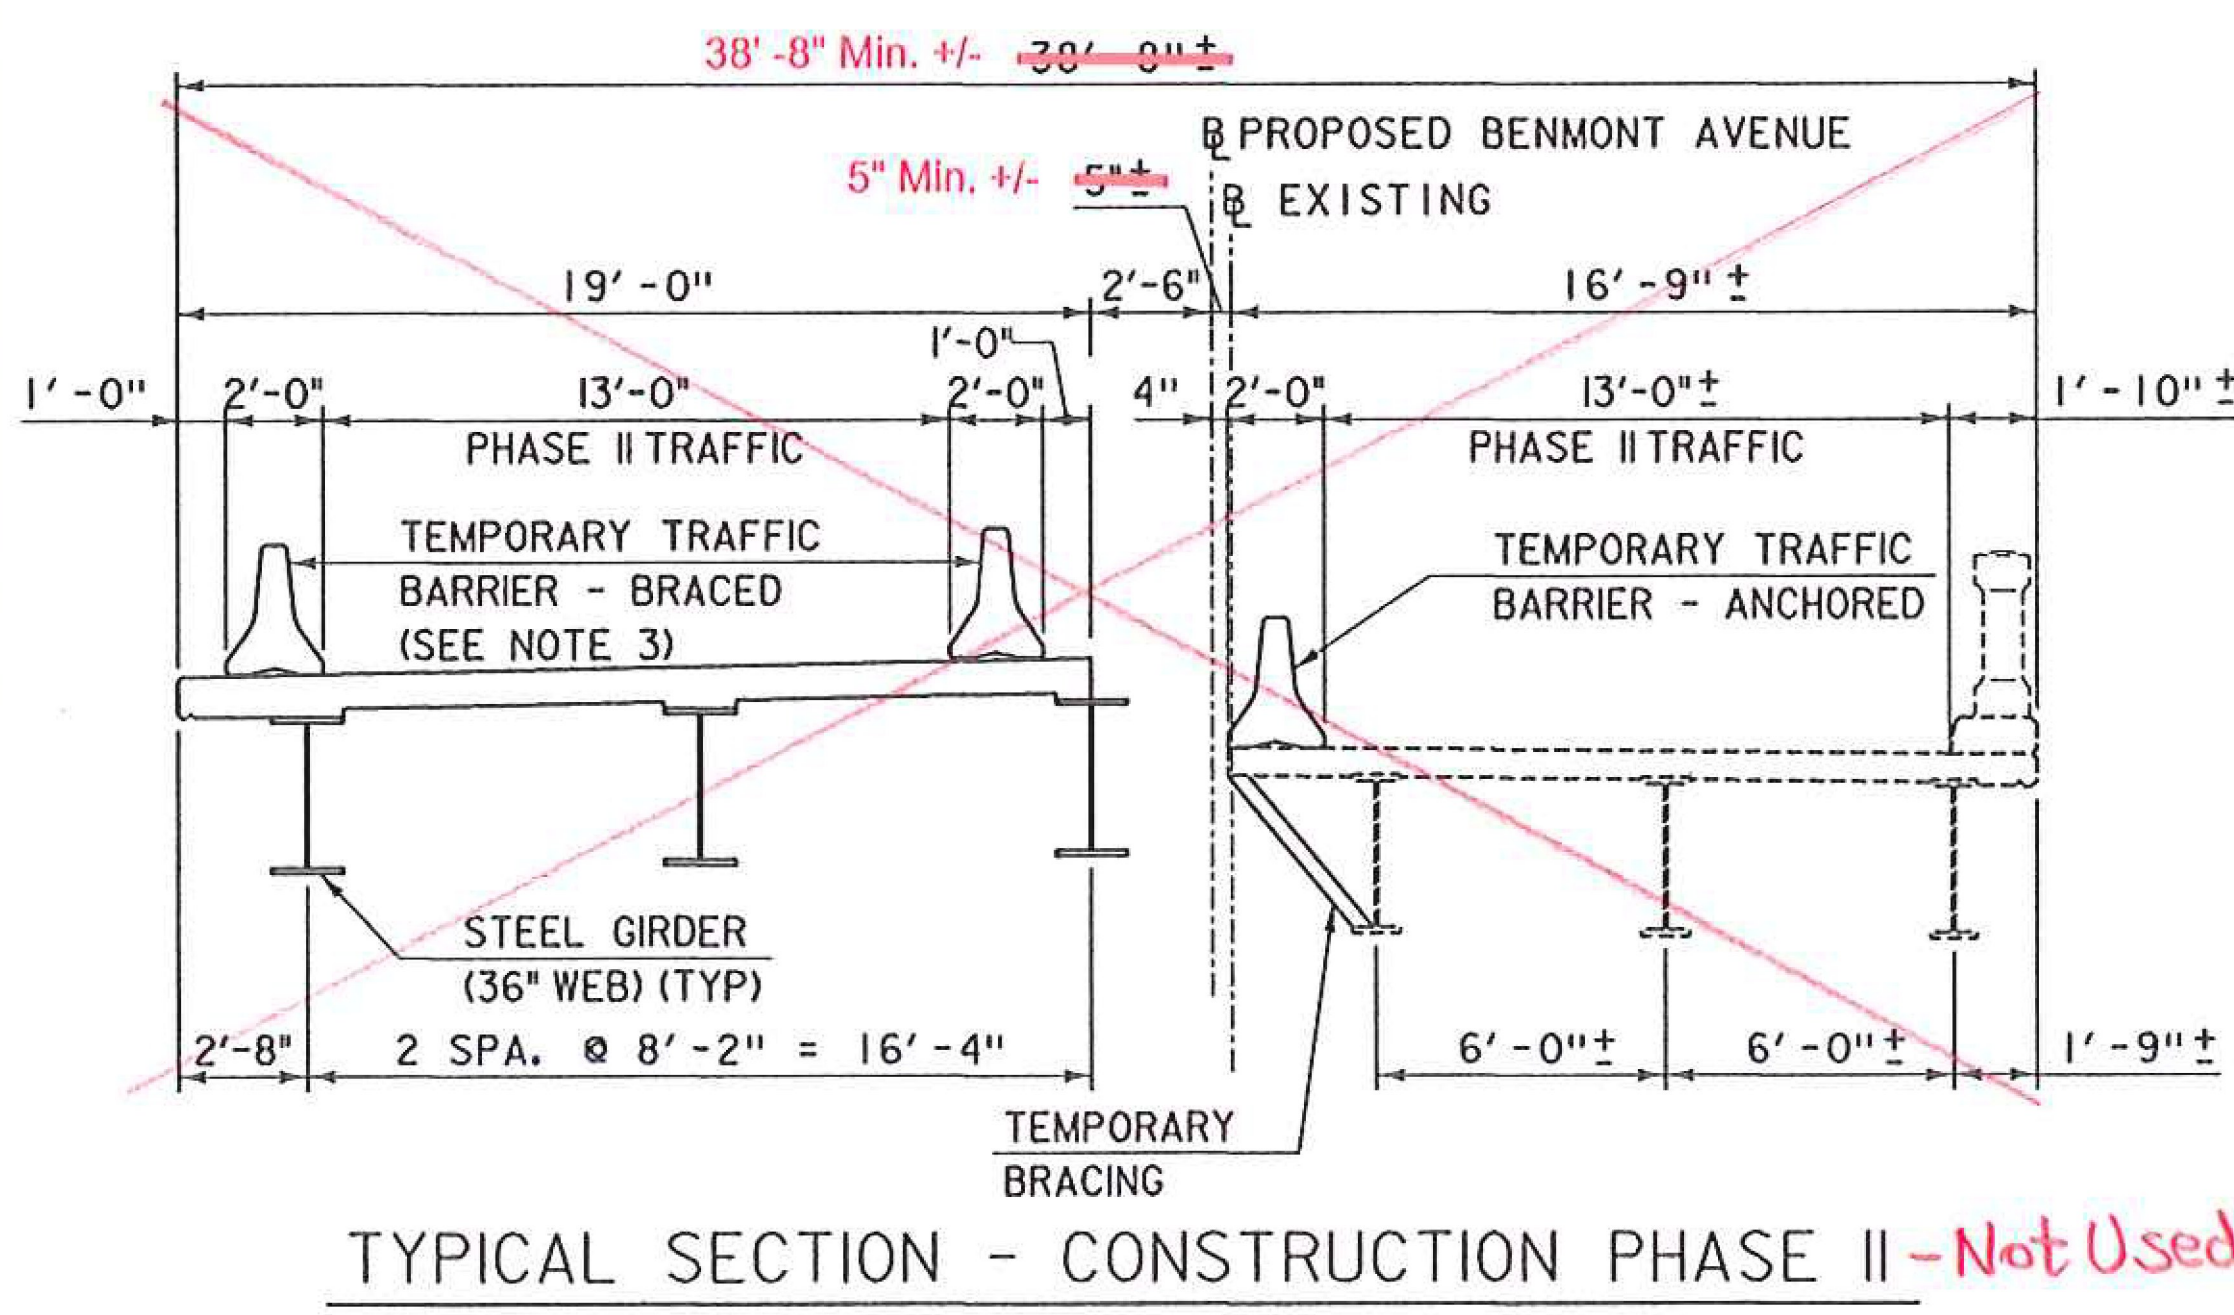

SCALE 1/4" = 1'-0"

PROJECT NAME:	BENNINGTON
PROJECT NUMBER:	BRF 1000(16)
FILE NAME:	z88j087bdr_bphase.dgn
PROJECT LEADER:	R. HEBERT
DESIGNED BY:	D. MYERS
BRIDGE CONSTRUCTION PHASING	
PLOT DATE:	8/27/2014
DRAWN BY:	S. MORGAN
CHECKED BY:	R. HEBERT
SHEET	18A OF 75