


**TRAFFIC SIGN SUMMARY**


MARKER, STATION, OR SIGN NUMBER	SIGN LEGEND	SIGN DIMENSIONS		NEW & SALVAGED SIGNS				NEW SIGN POSTS				REMARKS	SIGN DETAIL			
		E A	WIDTH (In)	HEIGHT (In)	"A"	"B"	SALV SIGN	SALV TIS	SQUARE STEEL (In)				ANCHOR	SLEEVE	DETAIL ON SHEET NUMBER	STD. SHEET NUMBER
									1.75	2.00	2.50					
									lb/ft							
1.88	2.42	3.35														
7+10.76, RT	BRIDGE 57 TH-7	I	6	8	0.33				I		10'		I		BRIDGE NO. PLAQUE VD-701	T-42
10+13.51, LT		I	6	8	0.33				I		11'		I			
						SF	SF	EA.	SF	EA.	FT	FT	FT	EA.		

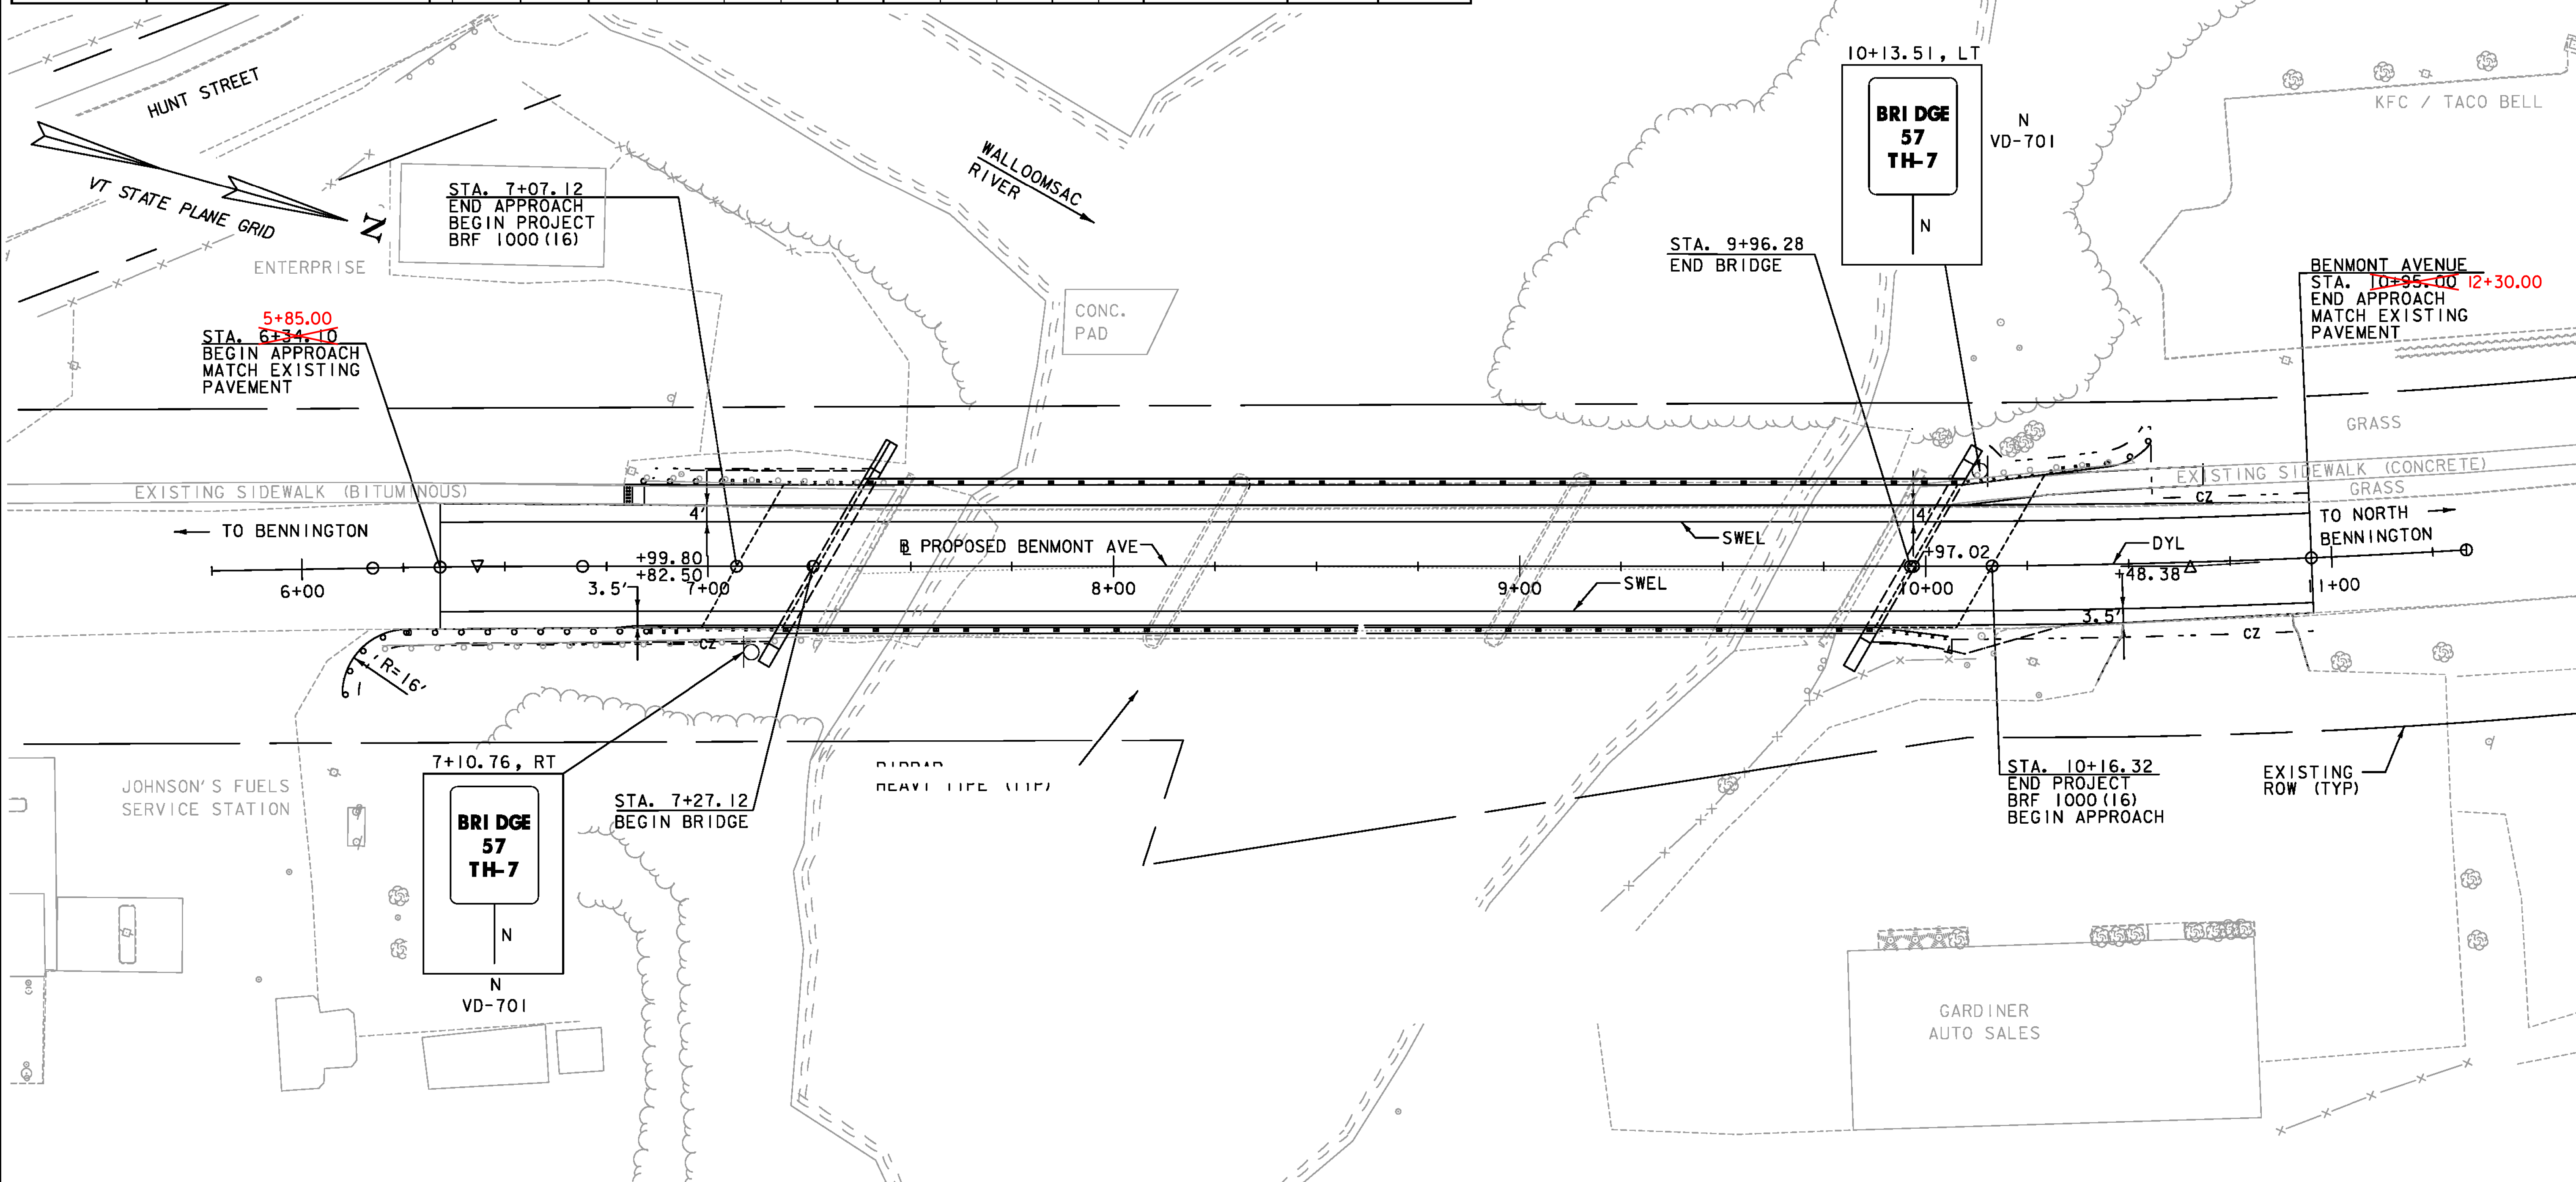

DATUM	
VERTICAL	NAVD 88
HORIZONTAL	NAD 83 (92)
ADJUSTMENT	COMPASS

**STRIPING LEGEND**  
 DYL - 4" DOUBLE YELLOW LINE  
 SWEL - 4" SINGLE WHITE EDGE LINE

4" INCH YELLOW LINE  
~~6+34.10 - 10+95.00, LT & RT~~  
 5+10.00 - 12+30.00  
 4" INCH WHITE LINE  
~~6+34.10 - 10+95.00, LT & RT~~  
 5+10.00 - 12+30.00

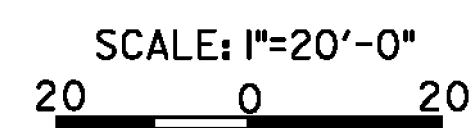

PROJECT NAME: BENNINGTON  
 PROJECT NUMBER: BRF 1000(16)

FILE NAME: z88j087bdr\_ss.dgn  
 PROJECT LEADER: R. HEBERT  
 DESIGNED BY: D. BRYANT  
 SIGNING AND STRIPING PLAN

PLOT DATE: 8/7/2014  
 DRAWN BY: P. MCCLURE  
 CHECKED BY: D. BRYANT  
 SHEET 28 OF 75