


PLAN
SCALE 1" = 20'-0"
20 0 20

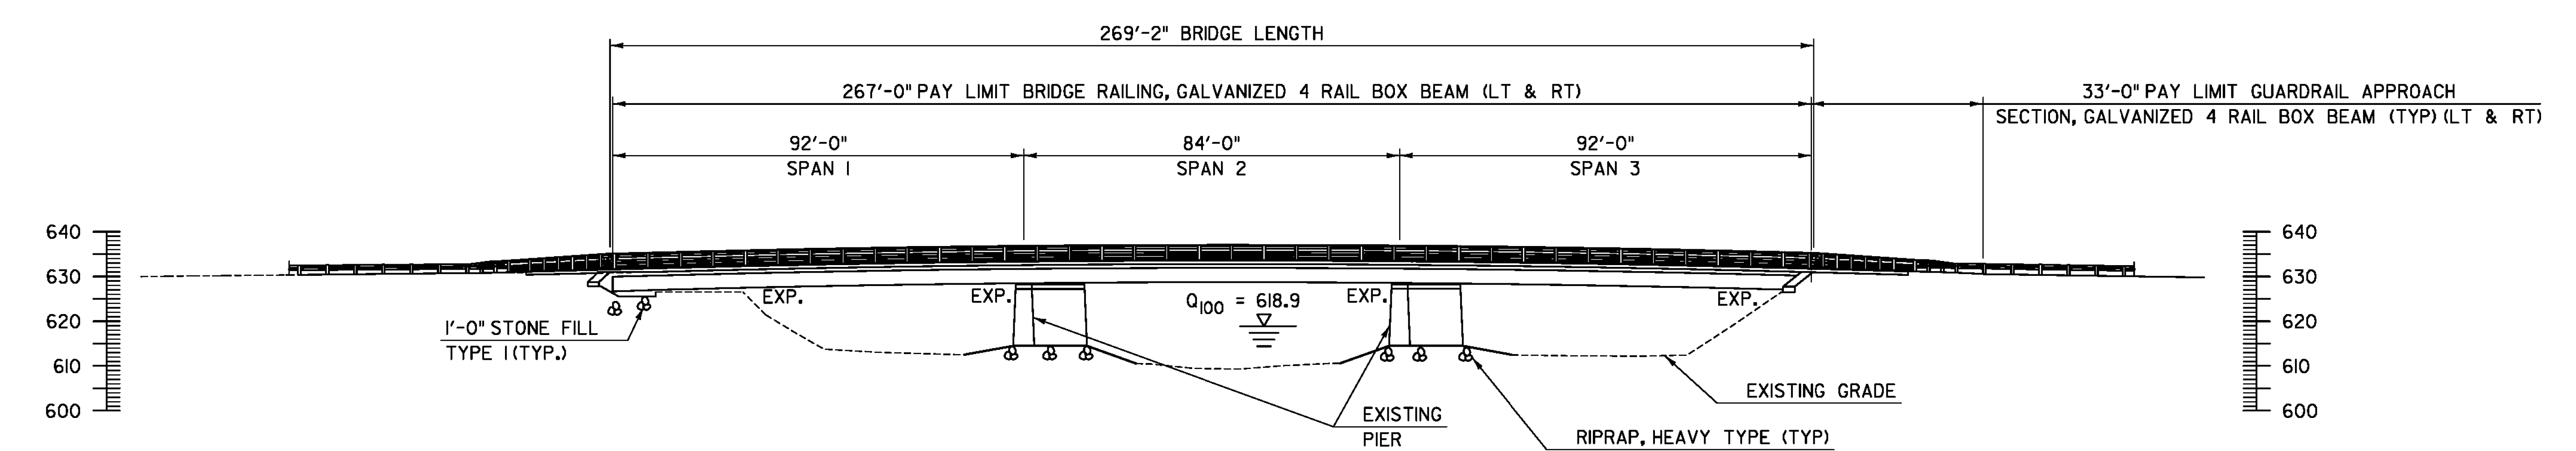

ELEVATION
SCALE 1" = 20'-0"
20 0 20

PROJECT NAME:	BENNINGTON
PROJECT NUMBER:	BRF 1000(16)
FILE NAME:	z88j087bdr_gpe.dgn
PROJECT LEADER:	R. HEBERT
DESIGNED BY:	D. MYERS
GENERAL PLAN AND ELEVATION	
PLOT DATE:	8/7/2014
DRAWN BY:	D. AXTEL
CHECKED BY:	R. HEBERT
SHEET	34 OF 75