


DECK REINFORCEMENT PLAN

SCALE 3/16" = 1'-0"

FOR ADDITIONAL SIDEWALK AND CURB REINFORCEMENT, SEE SHEET "DECK SLAB REINFORCING DETAILS"

GROUP I:
D538, D539, &
MECHANICAL
BAR CONNECTOR

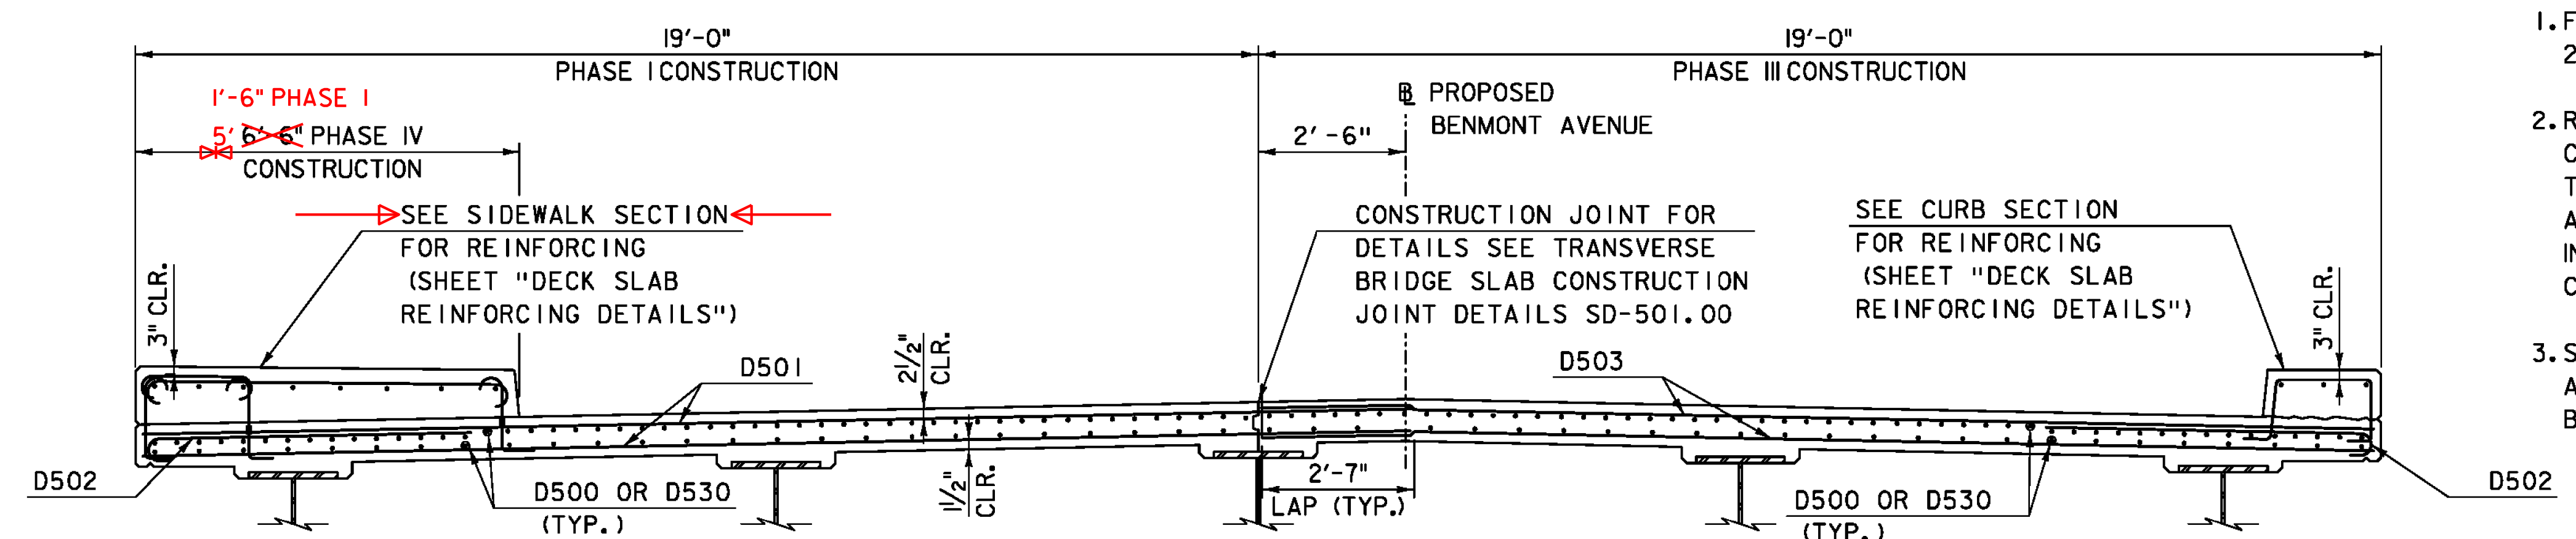

DECK SECTION

SCALE 1/2" = 1'-0"

NOTES:

1. FOR ADDITIONAL DECK DETAILS, SEE SHEETS "DECK SLAB REINFORCING PLAN 2" AND "DECK SLAB REINFORCING DETAILS".
2. REMOVABLE PROTECTIVE INSERTS SHALL BE INSTALLED IN MECHANICAL BAR CONNECTORS THROUGH THE DURATION OF PHASE III CONSTRUCTION TO KEEP THE COUPLERS FREE AND CLEAR OF DEBRIS UNTIL THE SIDEWALK DOWELS ARE INSTALLED DURING PHASE IV CONSTRUCTION. PAYMENT FOR PROTECTIVE INSERTS SHALL BE INCIDENTAL TO ITEM 507.19, "MECHANICAL BAR CONNECTOR."
3. SEE ABUTMENT NO. 1 REINFORCING, ABUTMENT NO. 2 REINFORCING, AND ABUTMENT SECTIONS SHEETS FOR ADDITIONAL REINFORCING NOT SHOWN AT BRIDGE ENDS.

PROJECT NAME:	BENNINGTON	FILE NAME:	z88j087bdr_deckpln1.dgn	PLOT DATE:	8/7/2014
PROJECT NUMBER:	BRF 1000(16)	PROJECT LEADER:	R. HEBERT	DRAWN BY:	S. MORGAN
		DESIGNED BY:	D. MYERS	CHECKED BY:	R. HEBERT
		DECK SLAB REINFORCING PLAN 1		SHEET	36 OF 75