


NOTE:
ASPHALTIC PLUG - TYPE JOINT SHALL BE DESIGNED FOR 2" MOVEMENT.

TYPICAL APPROACH SLAB SECTION A-A


SCALE 3/8" = 1'-0"

- NOTES:
- ALL ELEVATIONS AT TOP OF APPROACH SLAB, SIDEWALK OR CURB SURFACE.
 - SEE APPROACH SLAB DETAILS 2 SHEET FOR SECTION B-B DETAIL.

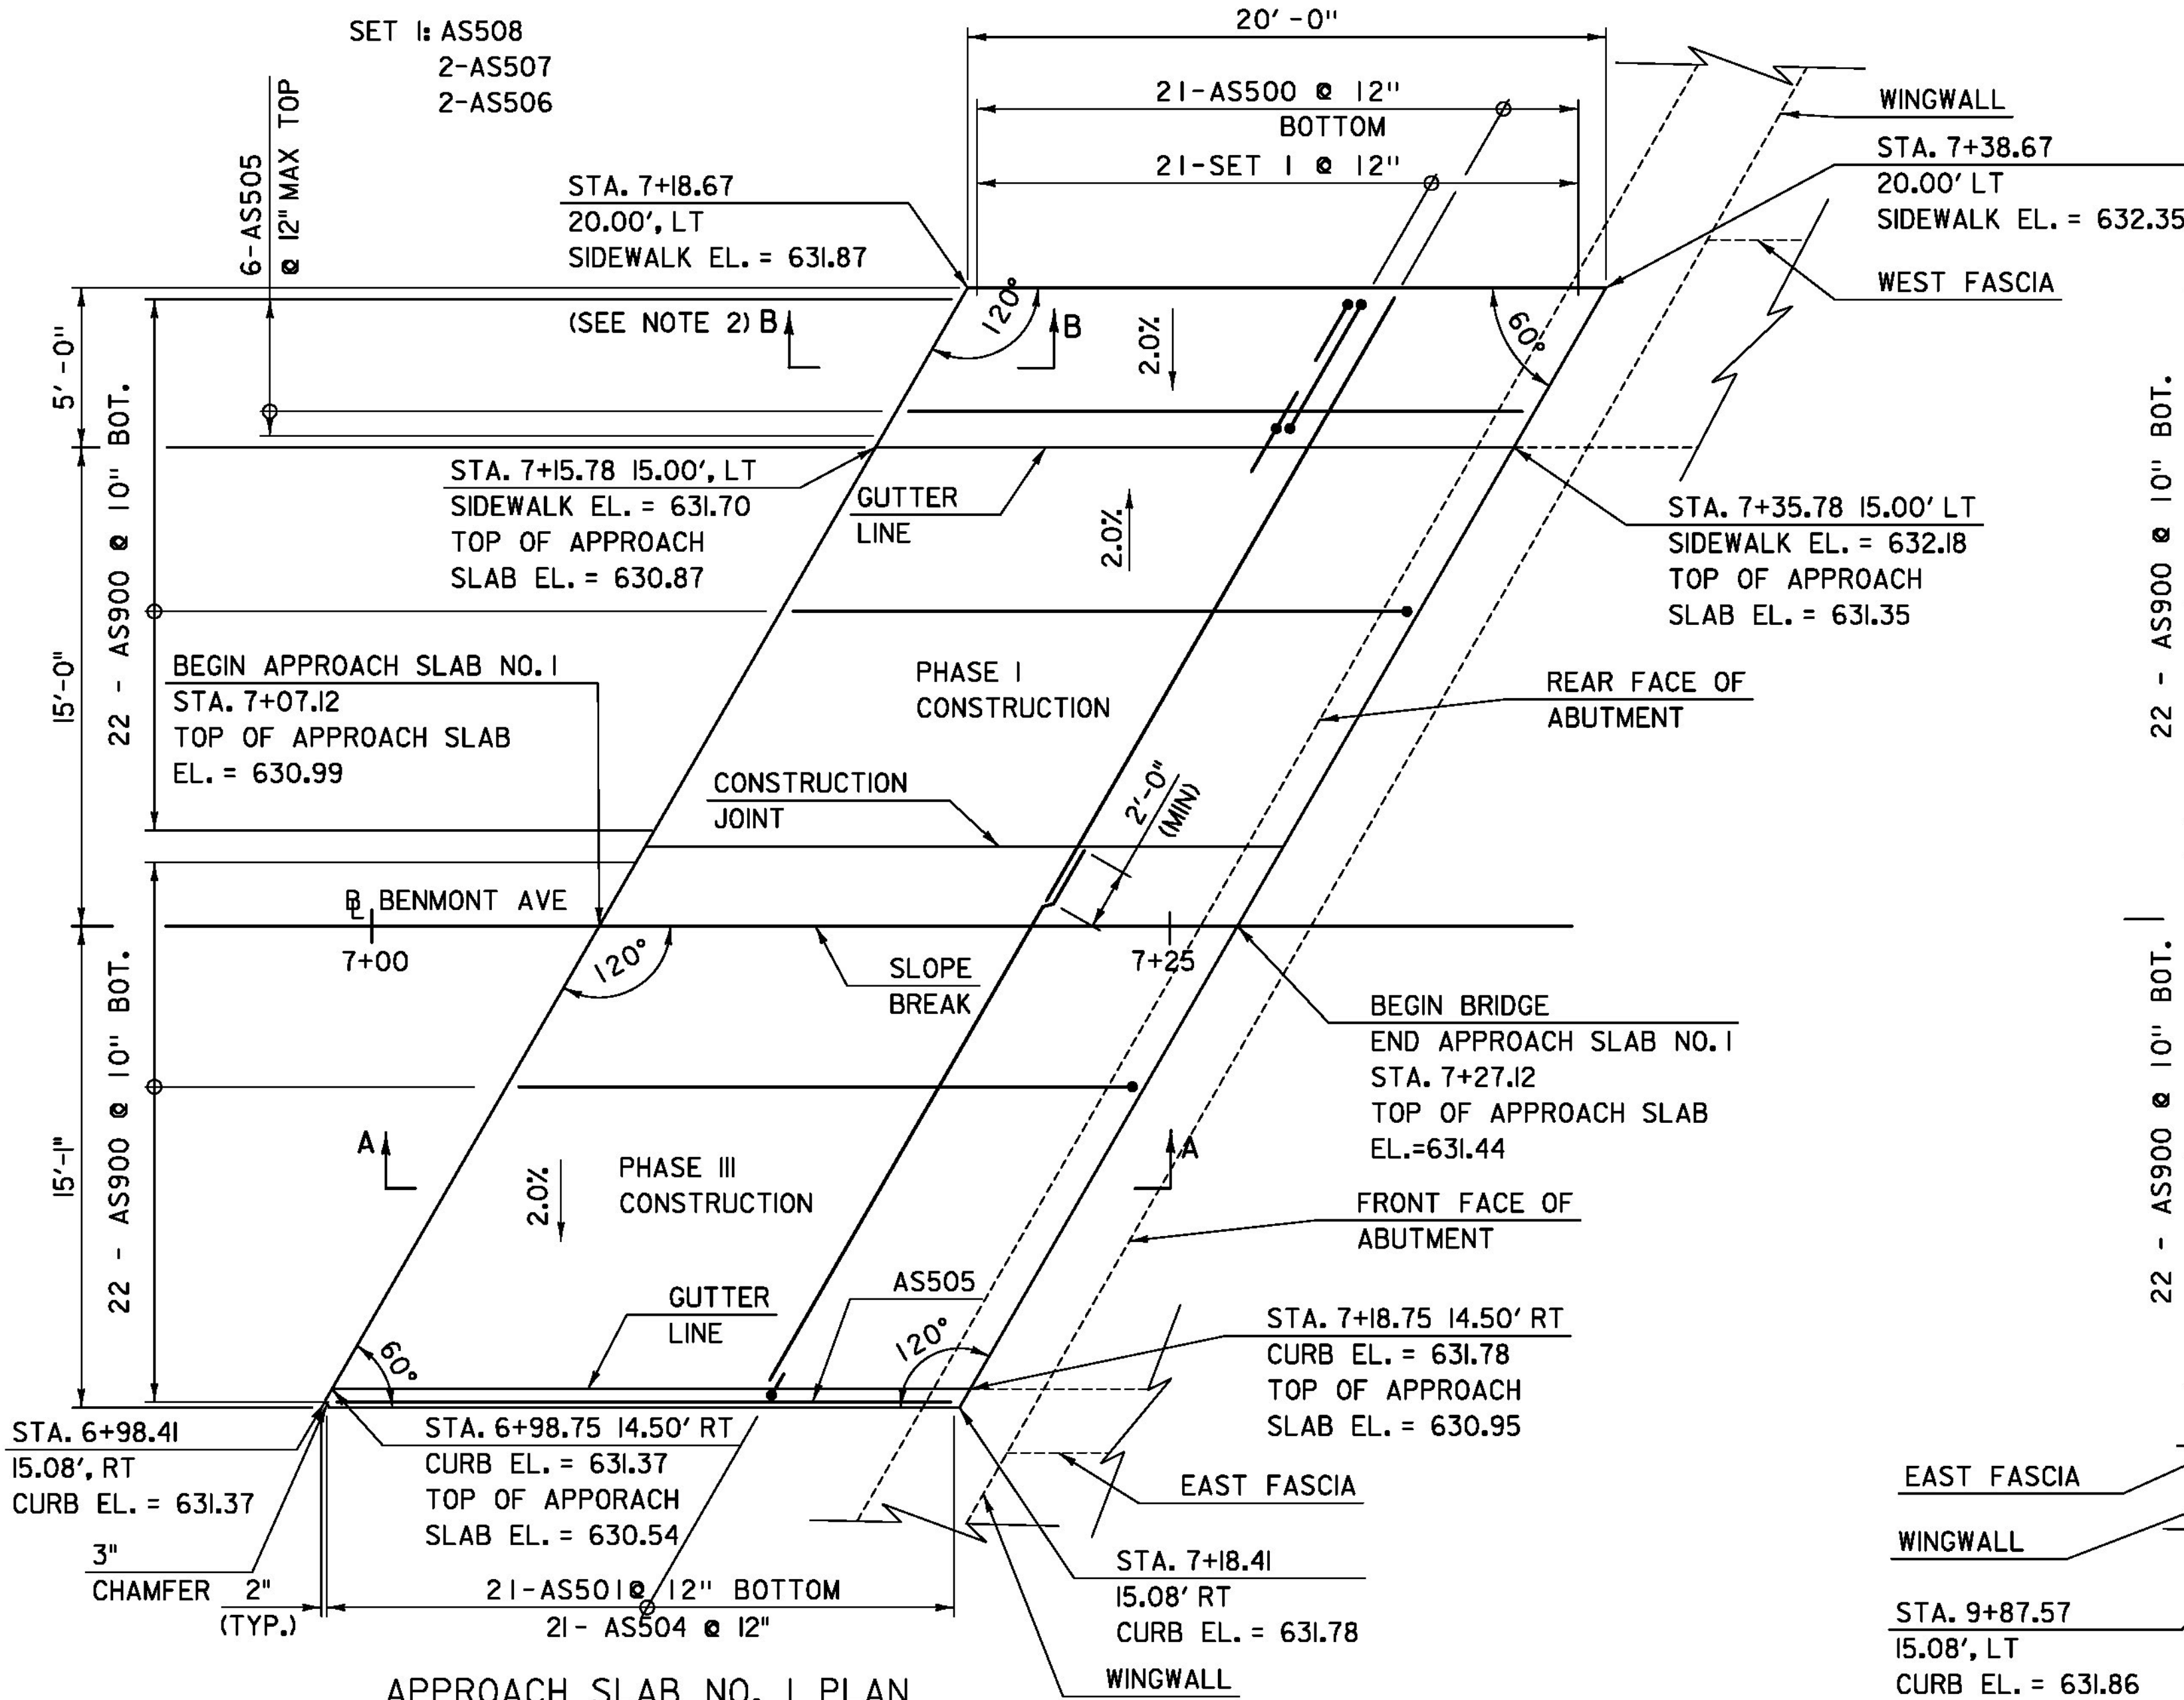

APPROACH SLAB NO. 1 PLAN

SCALE 1/4" = 1'-0"

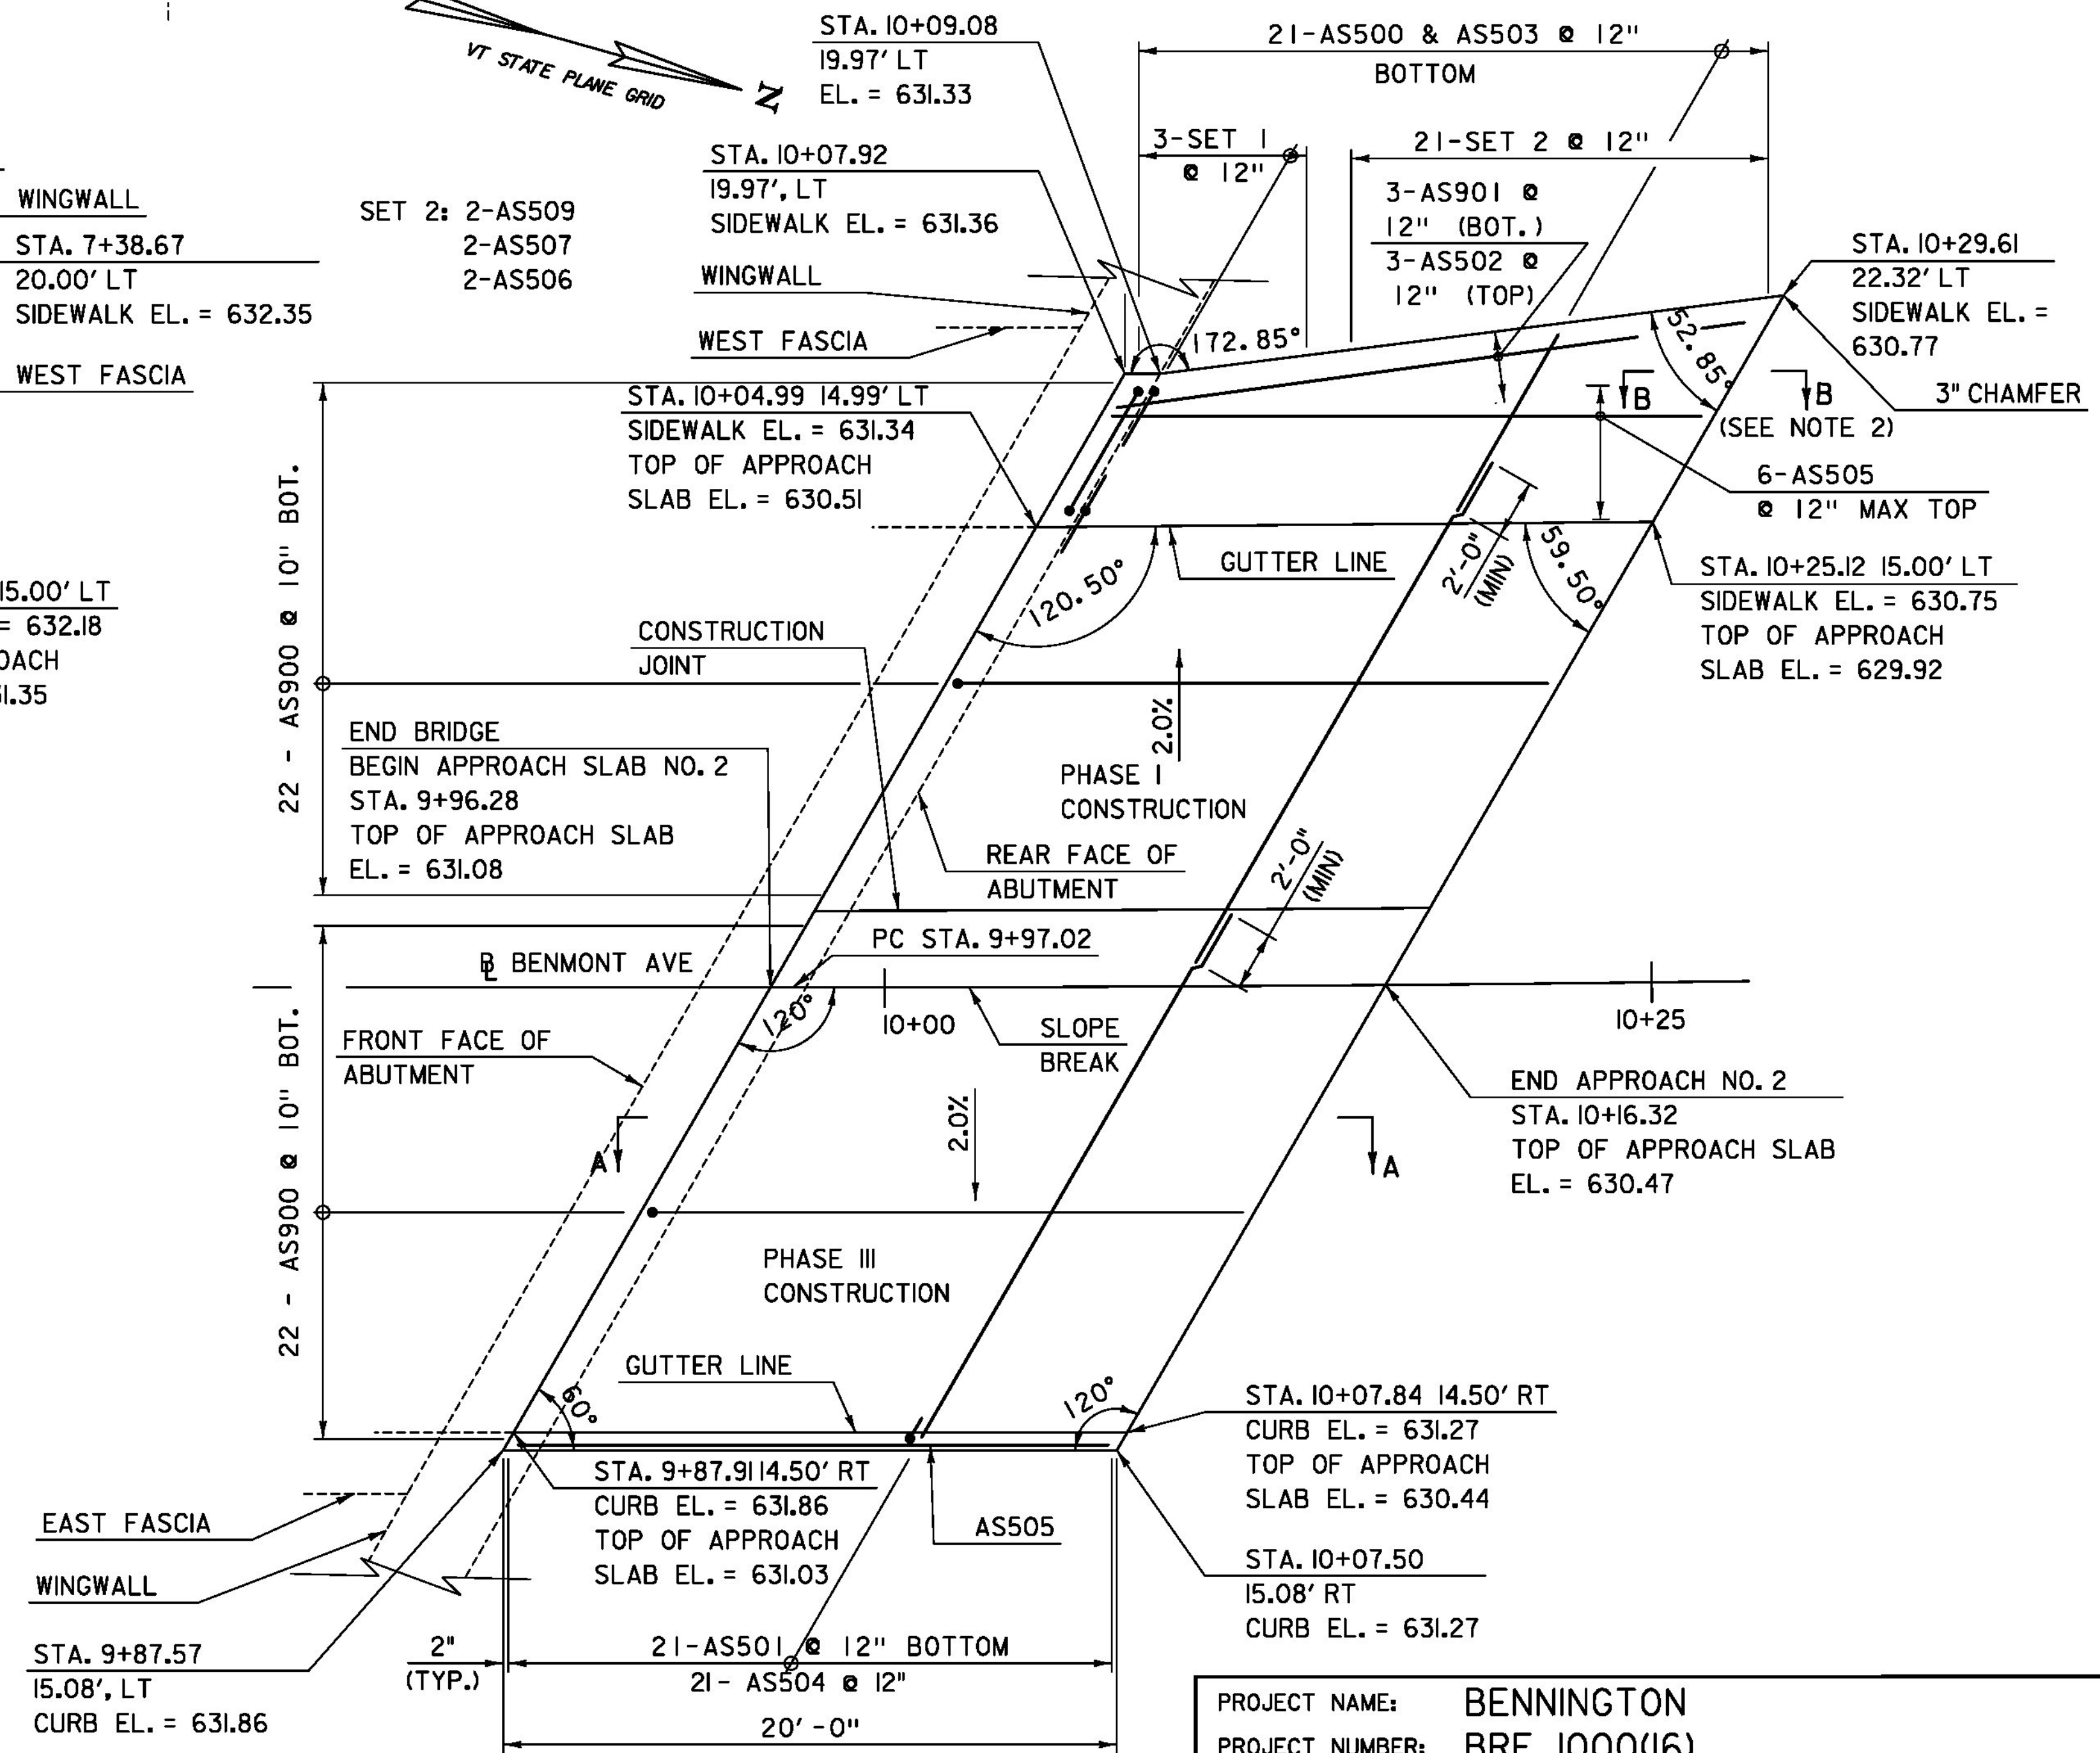

APPROACH SLAB NO. 2 PLAN

SCALE 1/4" = 1'-0"

PROJECT NAME:	BENNINGTON	FILE NAME:	z88j087bdr_apprslab.dgn	PLOT DATE:	8/8/2014
PROJECT NUMBER:	BRF 1000(16)	PROJECT LEADER:	R. HEBERT	DRAWN BY:	D. AXTELL
		DESIGNED BY:	D. MYERS	CHECKED BY:	R. HEBERT
		APPROACH SLAB DETAILS 1			SHEET 44 OF 75