



ITEM 524.II, "JOINT SEALER, HOT POURED"
SAWED PAVEMENT JOINT DETAIL
(NOT TO SCALE)

* JOINT IS TO BE LOCATED ACCURATELY BY STRING LINING, OR OTHER MEANS, PRIOR TO PAVING, SO THAT THE SAW CUTS WILL BE MADE DIRECTLY OVER THE END OF CONCRETE DECK. JOINT SHALL BE CUT DRY IN A SINGLE PASS AND BE SEALED WITHIN 24 HOURS OR PRIOR TO EXPOSURE TO TRAFFIC. JOINT SHALL BE CLEANED PRIOR TO APPLYING THE JOINT SEALER.

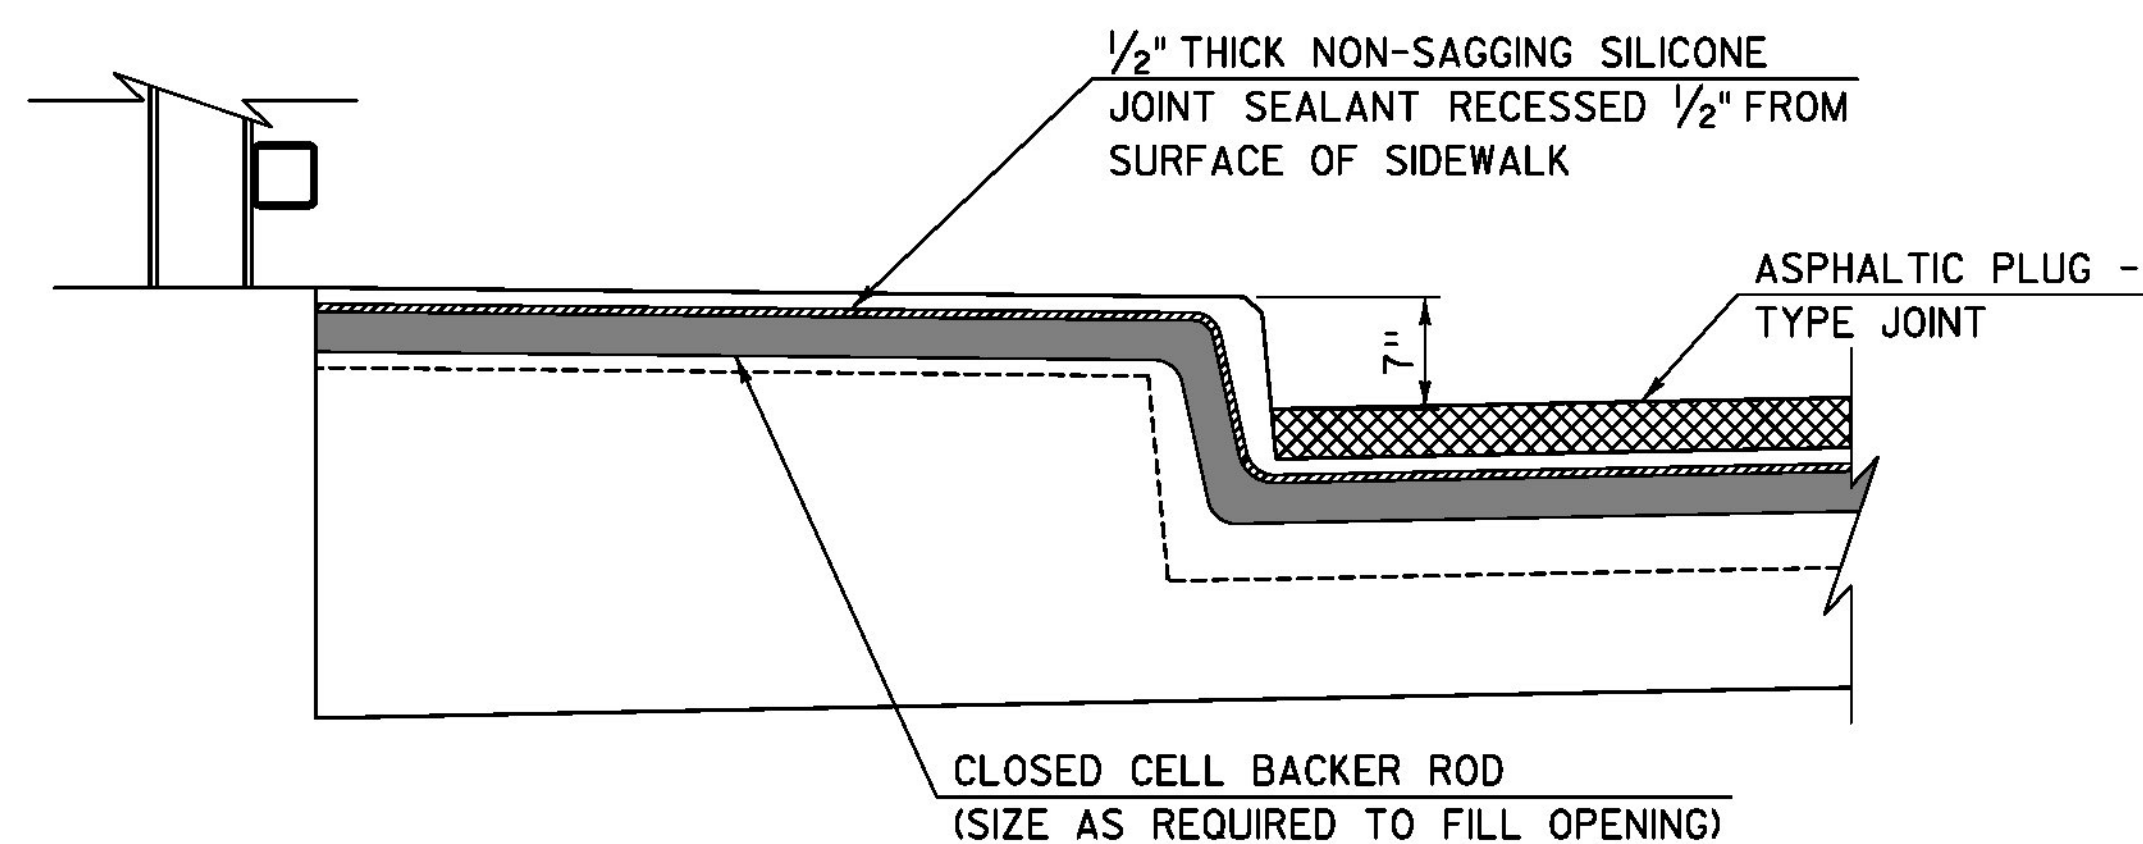


JOINT ELEVATION AT SECTION B-B
SCALE 1" = 1'-0"
(SIDEWALK SIDE SHOWN, CURB SIDE SIMILAR)

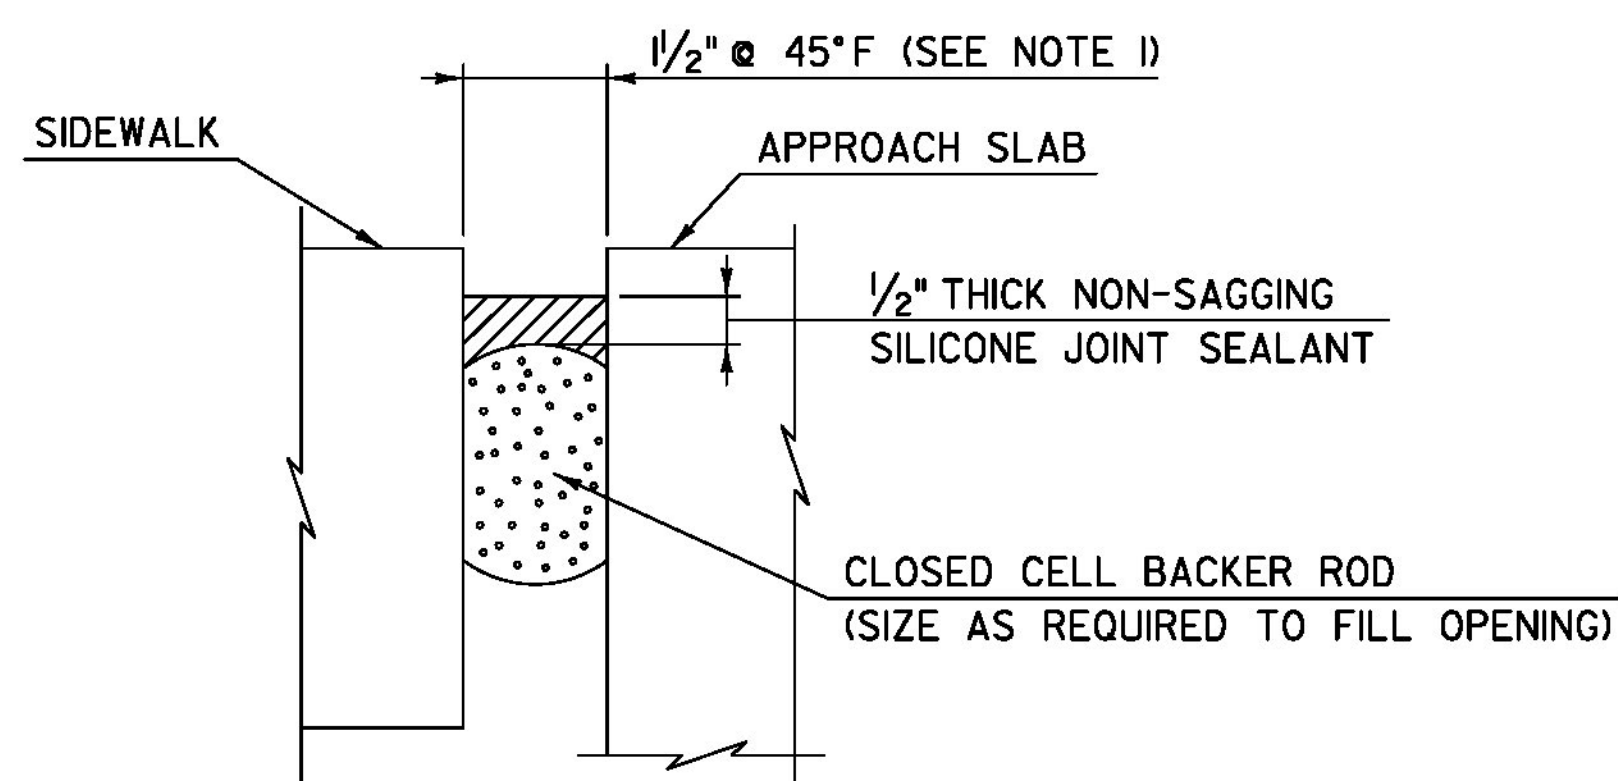


SIDEWALK JOINT SECTION B-B
SCALE 6" = 1'-0"
(SIDEWALK SIDE SHOWN, CURB SIDE SIMILAR)

NOTES:


1. +/- 0.12" PER 10°F CHANGE.
2. LOCATION OF SECTION B-B IS SHOWN ON SHEET "APPROACH SLAB DETAILS 1".
3. MATERIALS AND WORK ASSOCIATED WITH SIDEWALK AND CURB JOINT SHALL BE INCIDENTAL TO ITEM 516.10, "BRIDGE EXPANSION JOINT, ASPHALTIC PLUG".

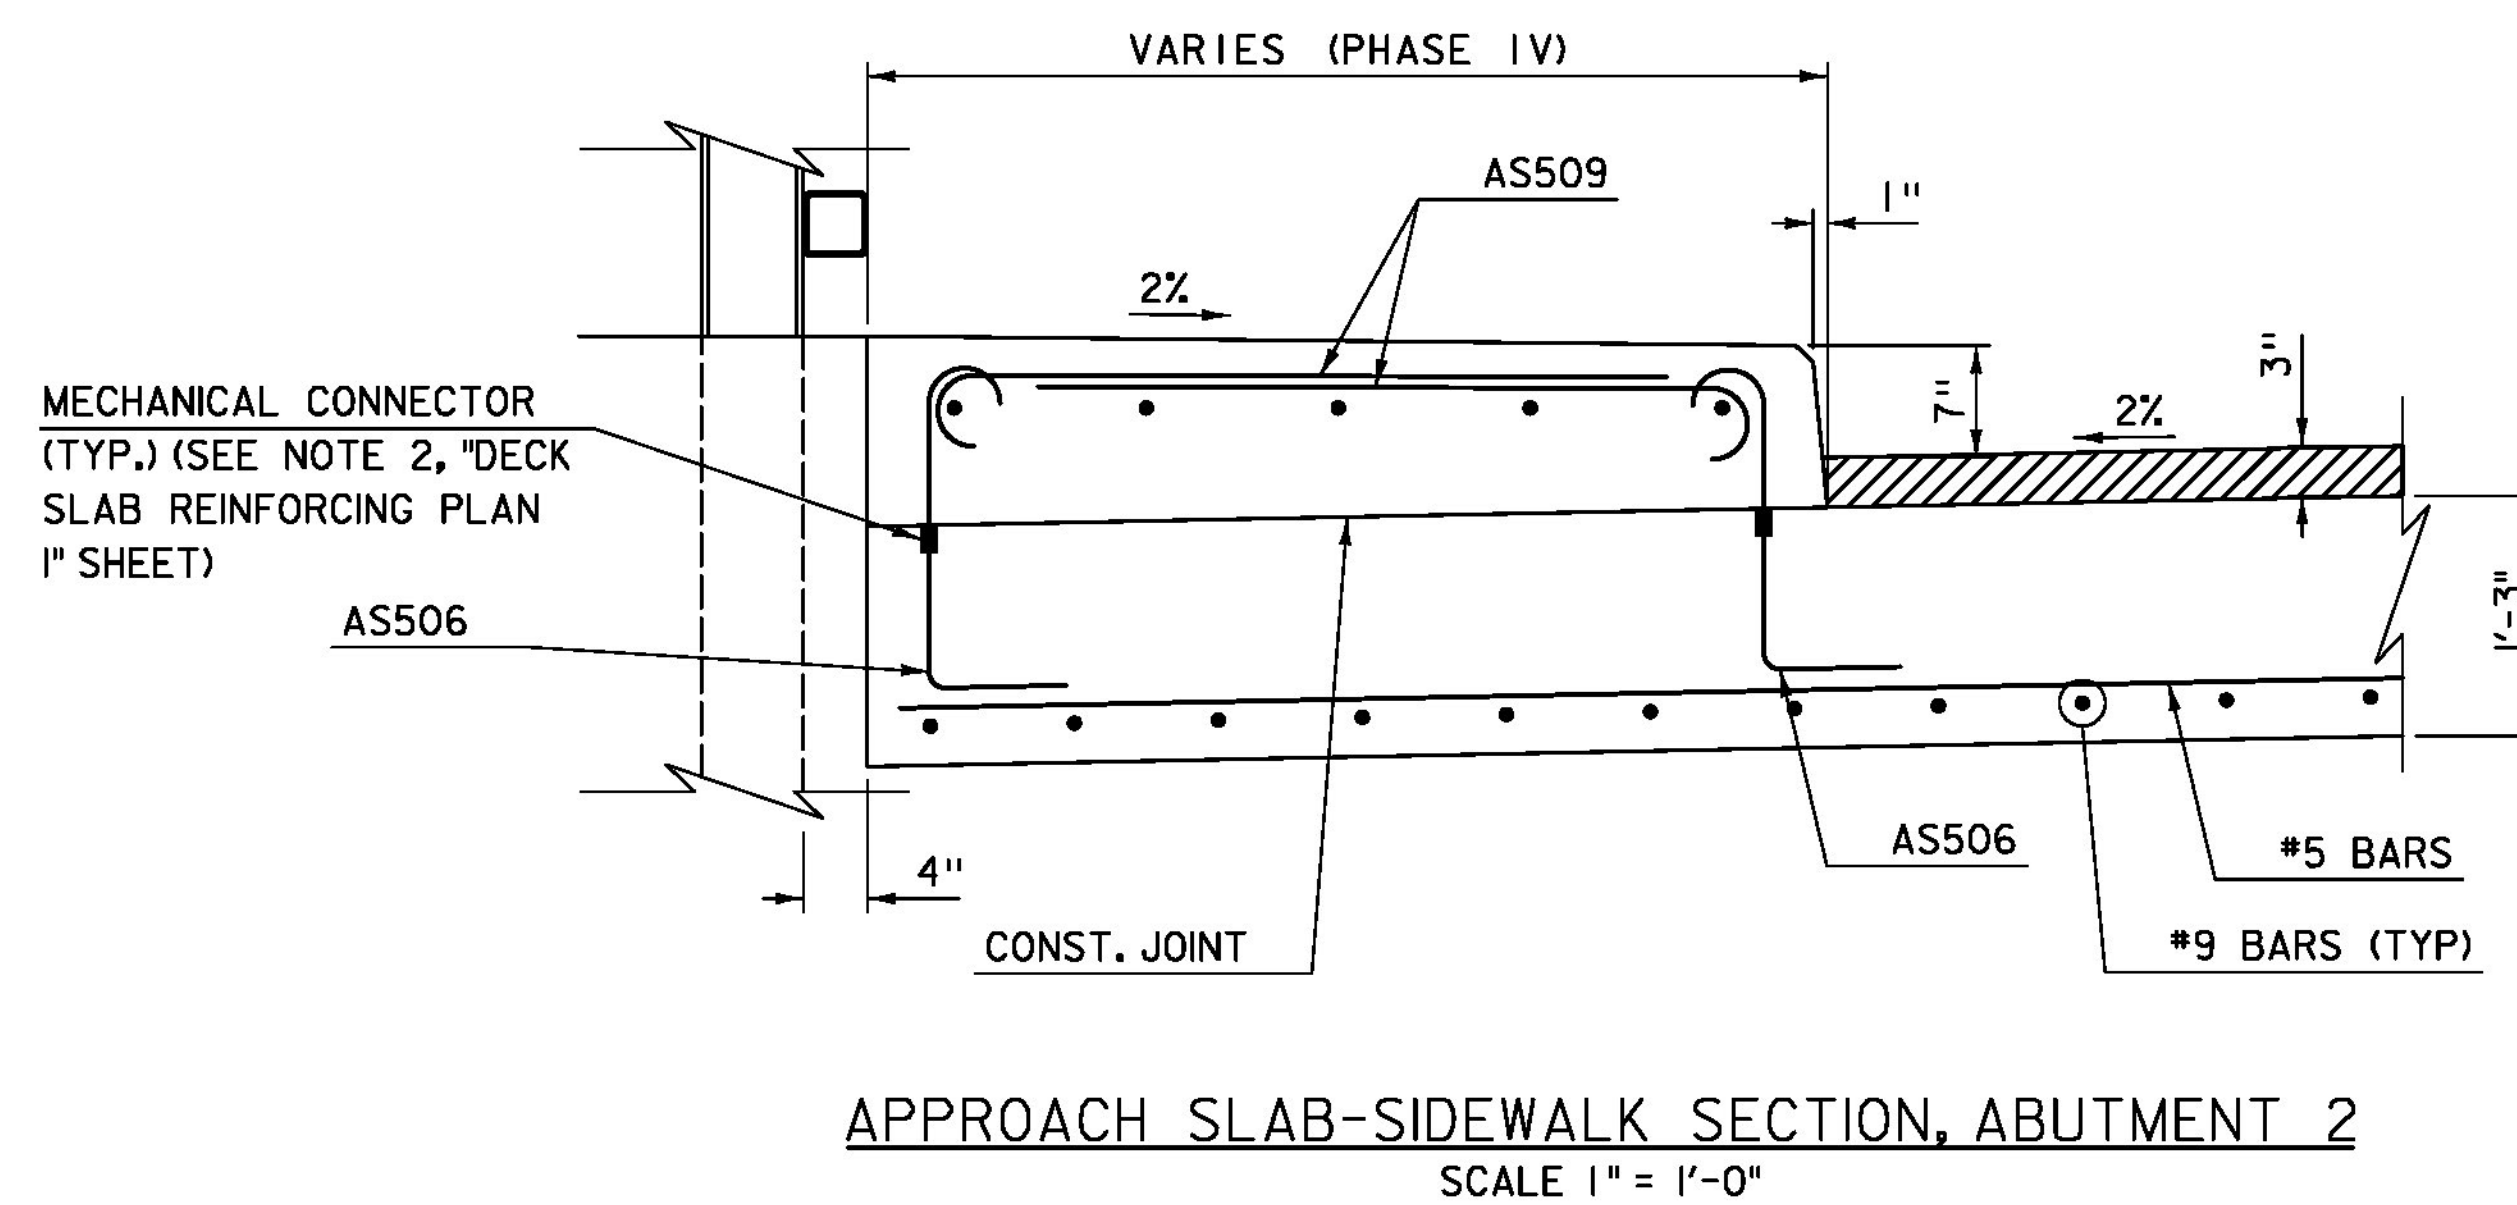

APPROACH SLAB-SIDEWALK SECTION, ABUTMENT 2
SCALE 1" = 1'-0"

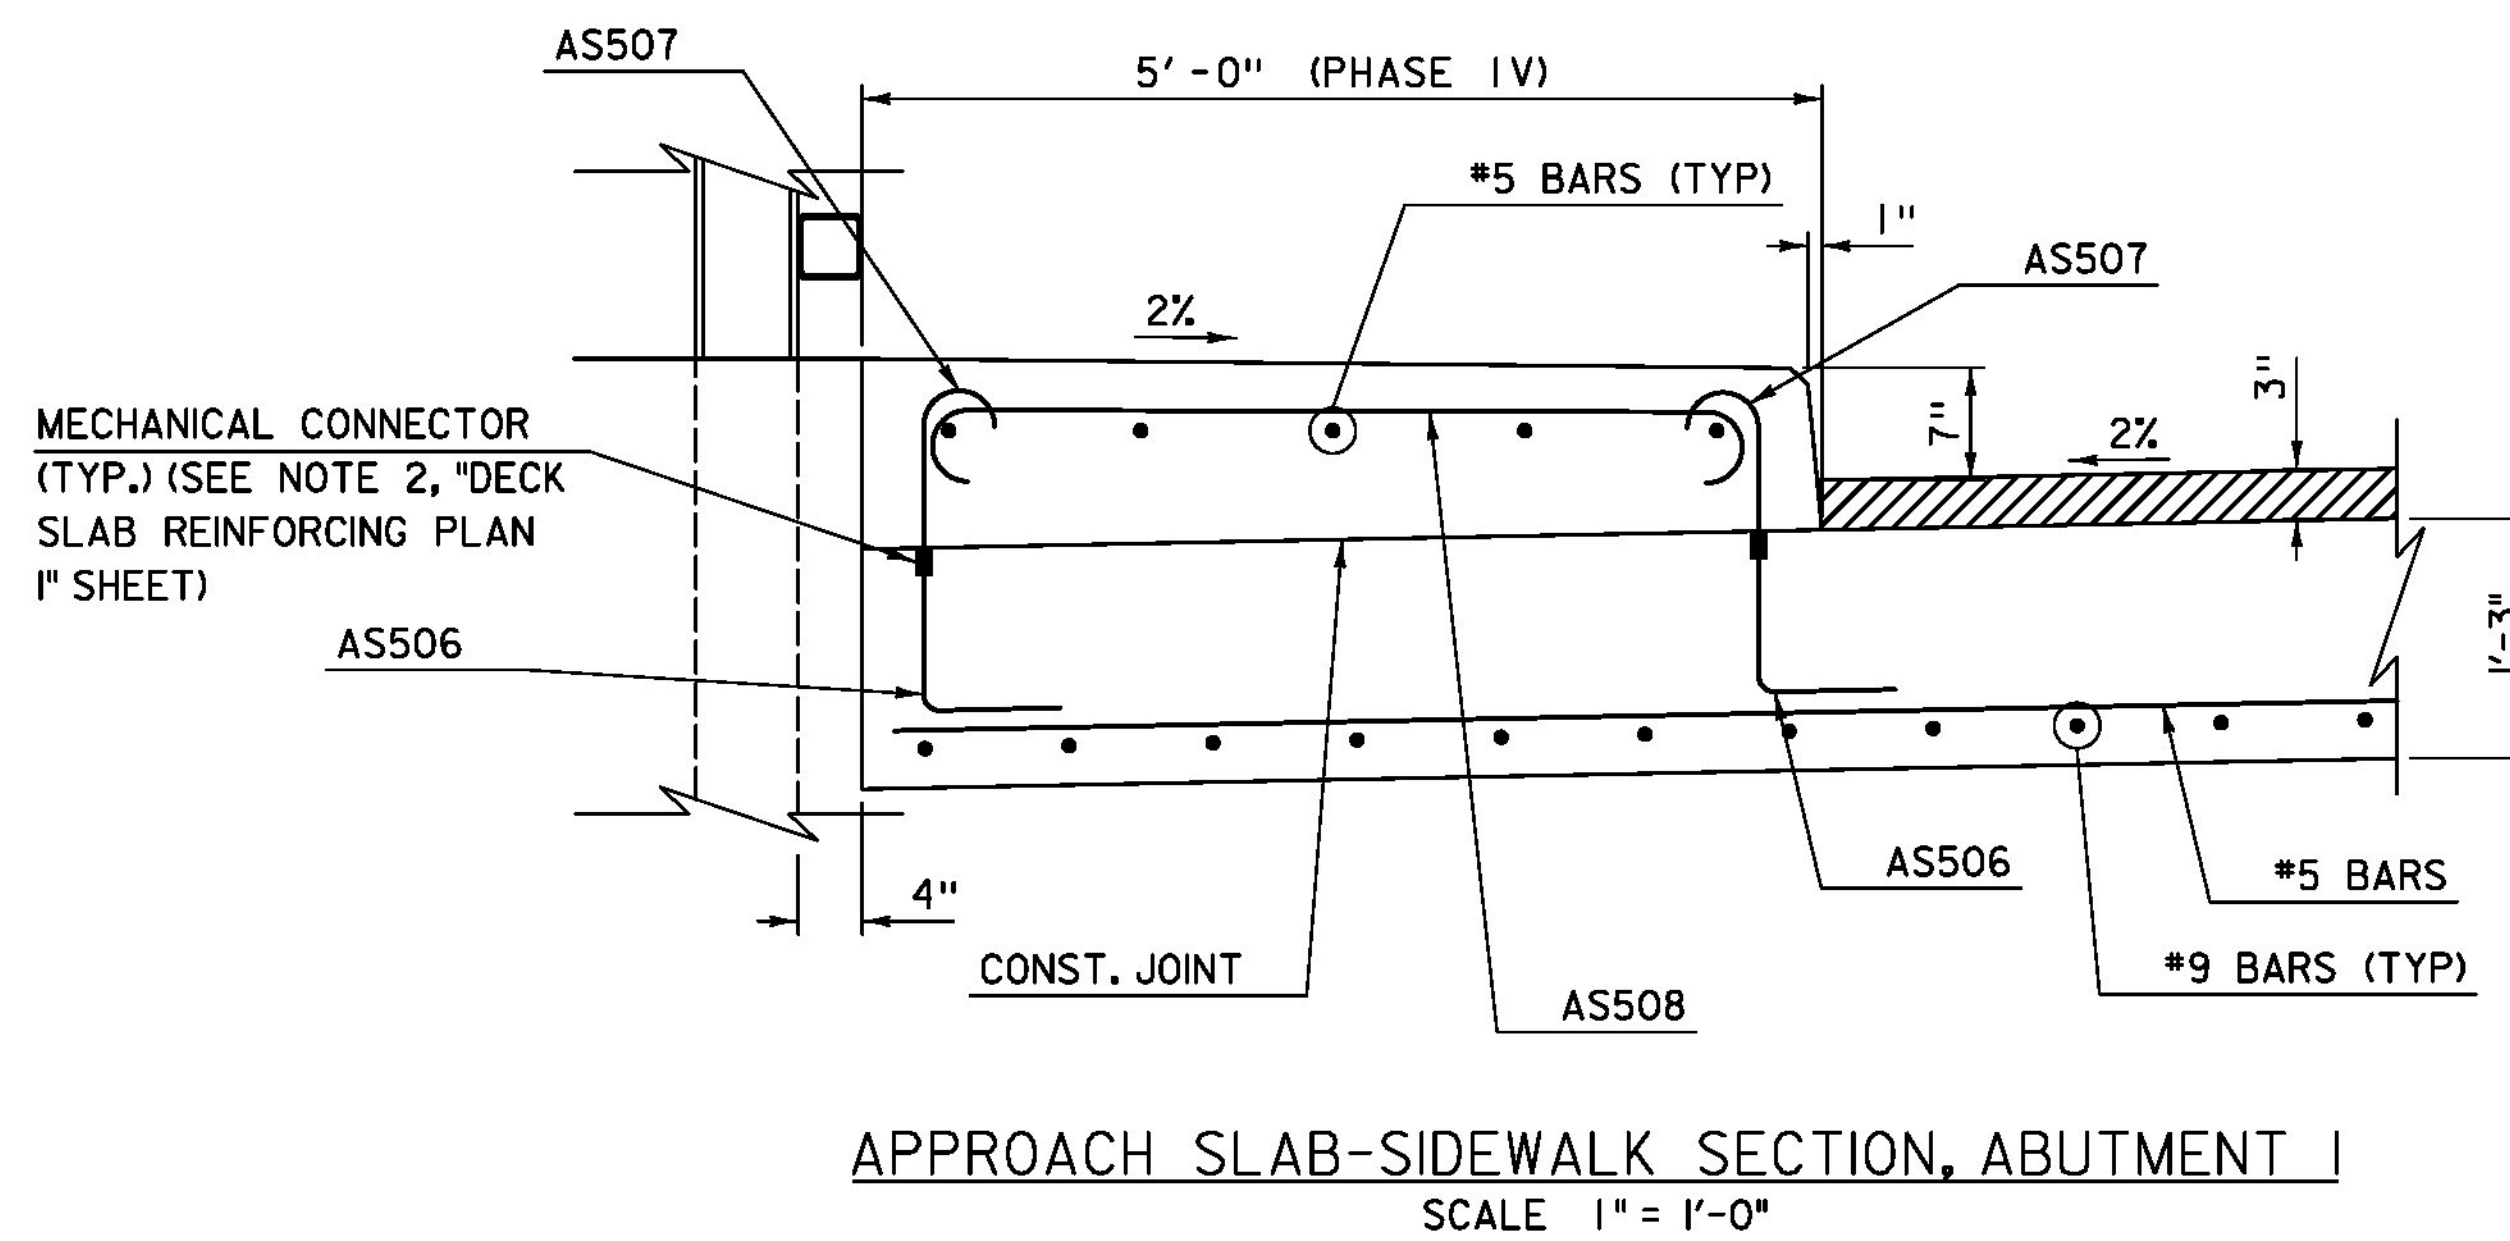

APPROACH SLAB-SIDEWALK SECTION, ABUTMENT 1
SCALE 1" = 1'-0"

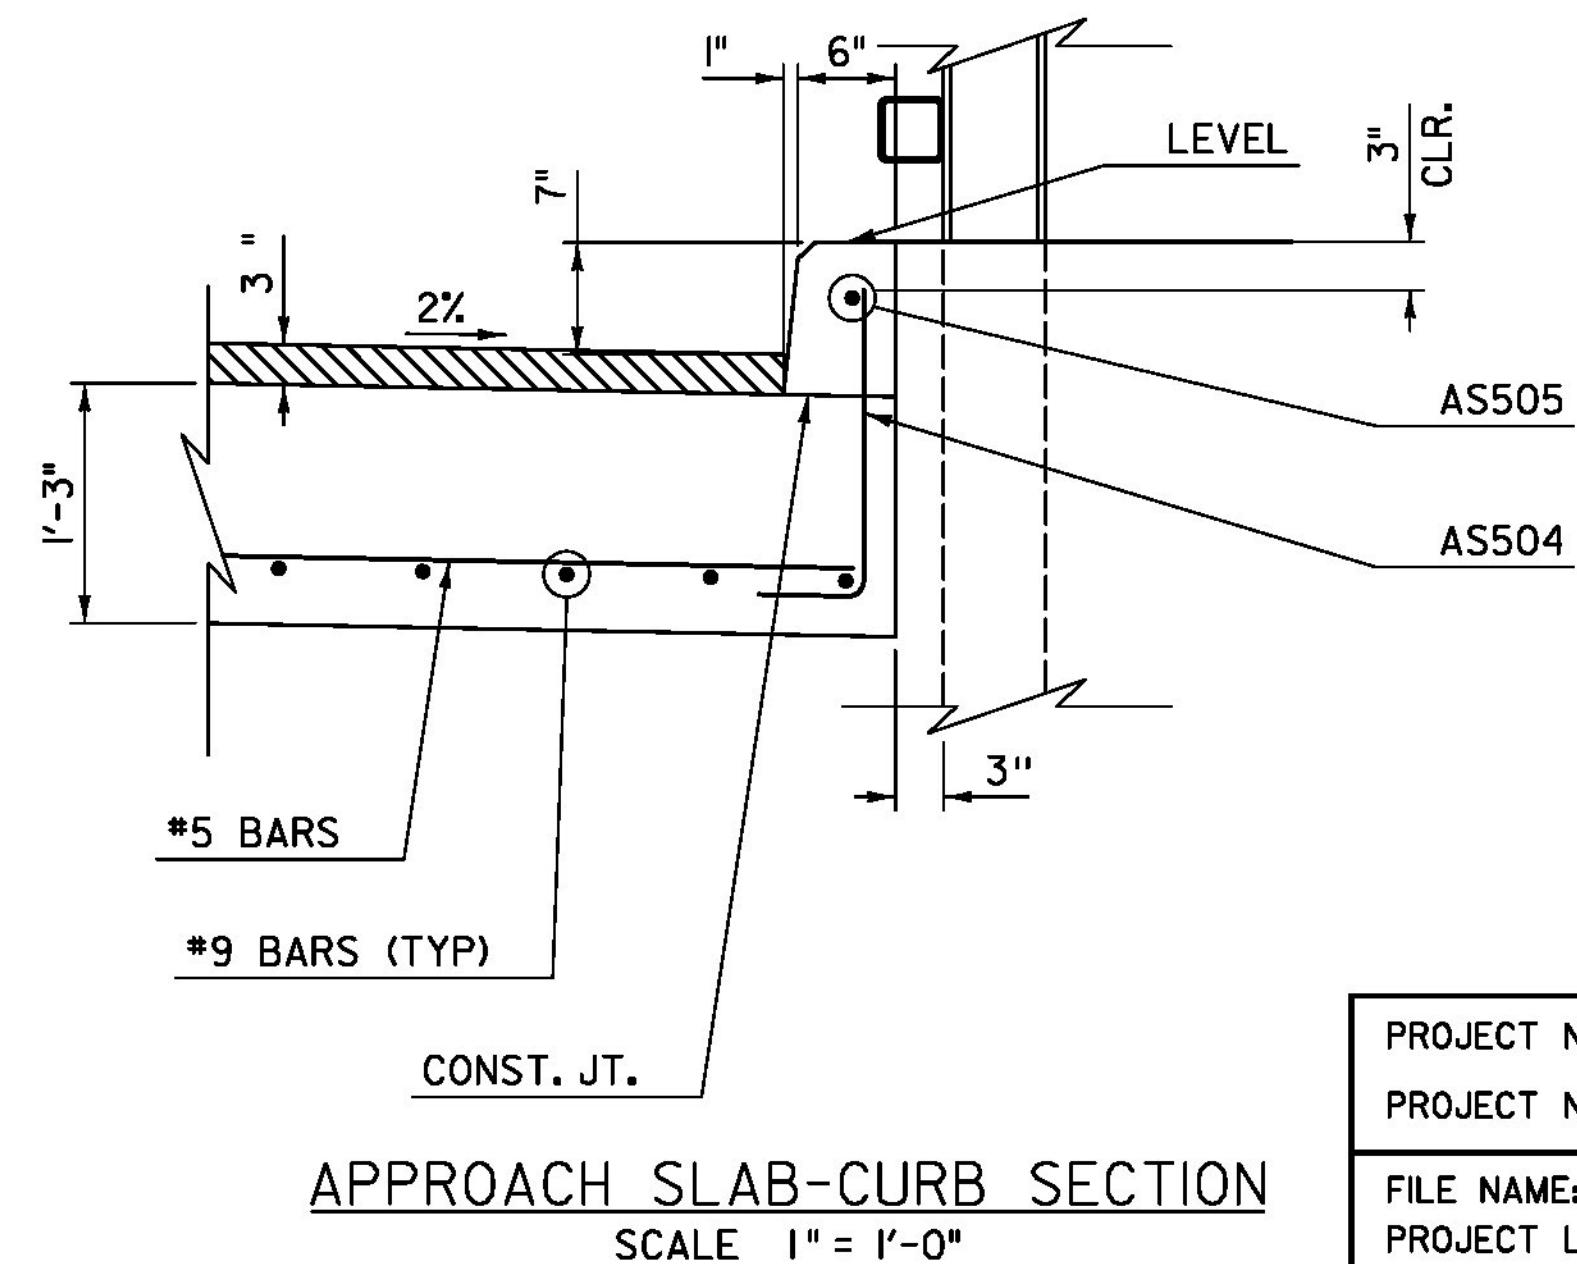

APPROACH SLAB-CURB SECTION
SCALE 1" = 1'-0"

PROJECT NAME: BENNINGTON
PROJECT NUMBER: BRF 1000(16)

FILE NAME: z88j087bdr_apprslab2.dgn
PROJECT LEADER: R. HEBERT
DESIGNED BY: D. MYERS
APPROACH SLAB DETAILS 2

PLOT DATE: 8/7/2014
DRAWN BY: D. AXTELL
CHECKED BY: R. HEBERT
SHEET 45 OF 75