



ABUTMENT NO. I REINFORCING - PHASE I
 NOT TO SCALE
 (DECK AND SIDEWALK STEEL NOT SHOWN FOR CLARITY)

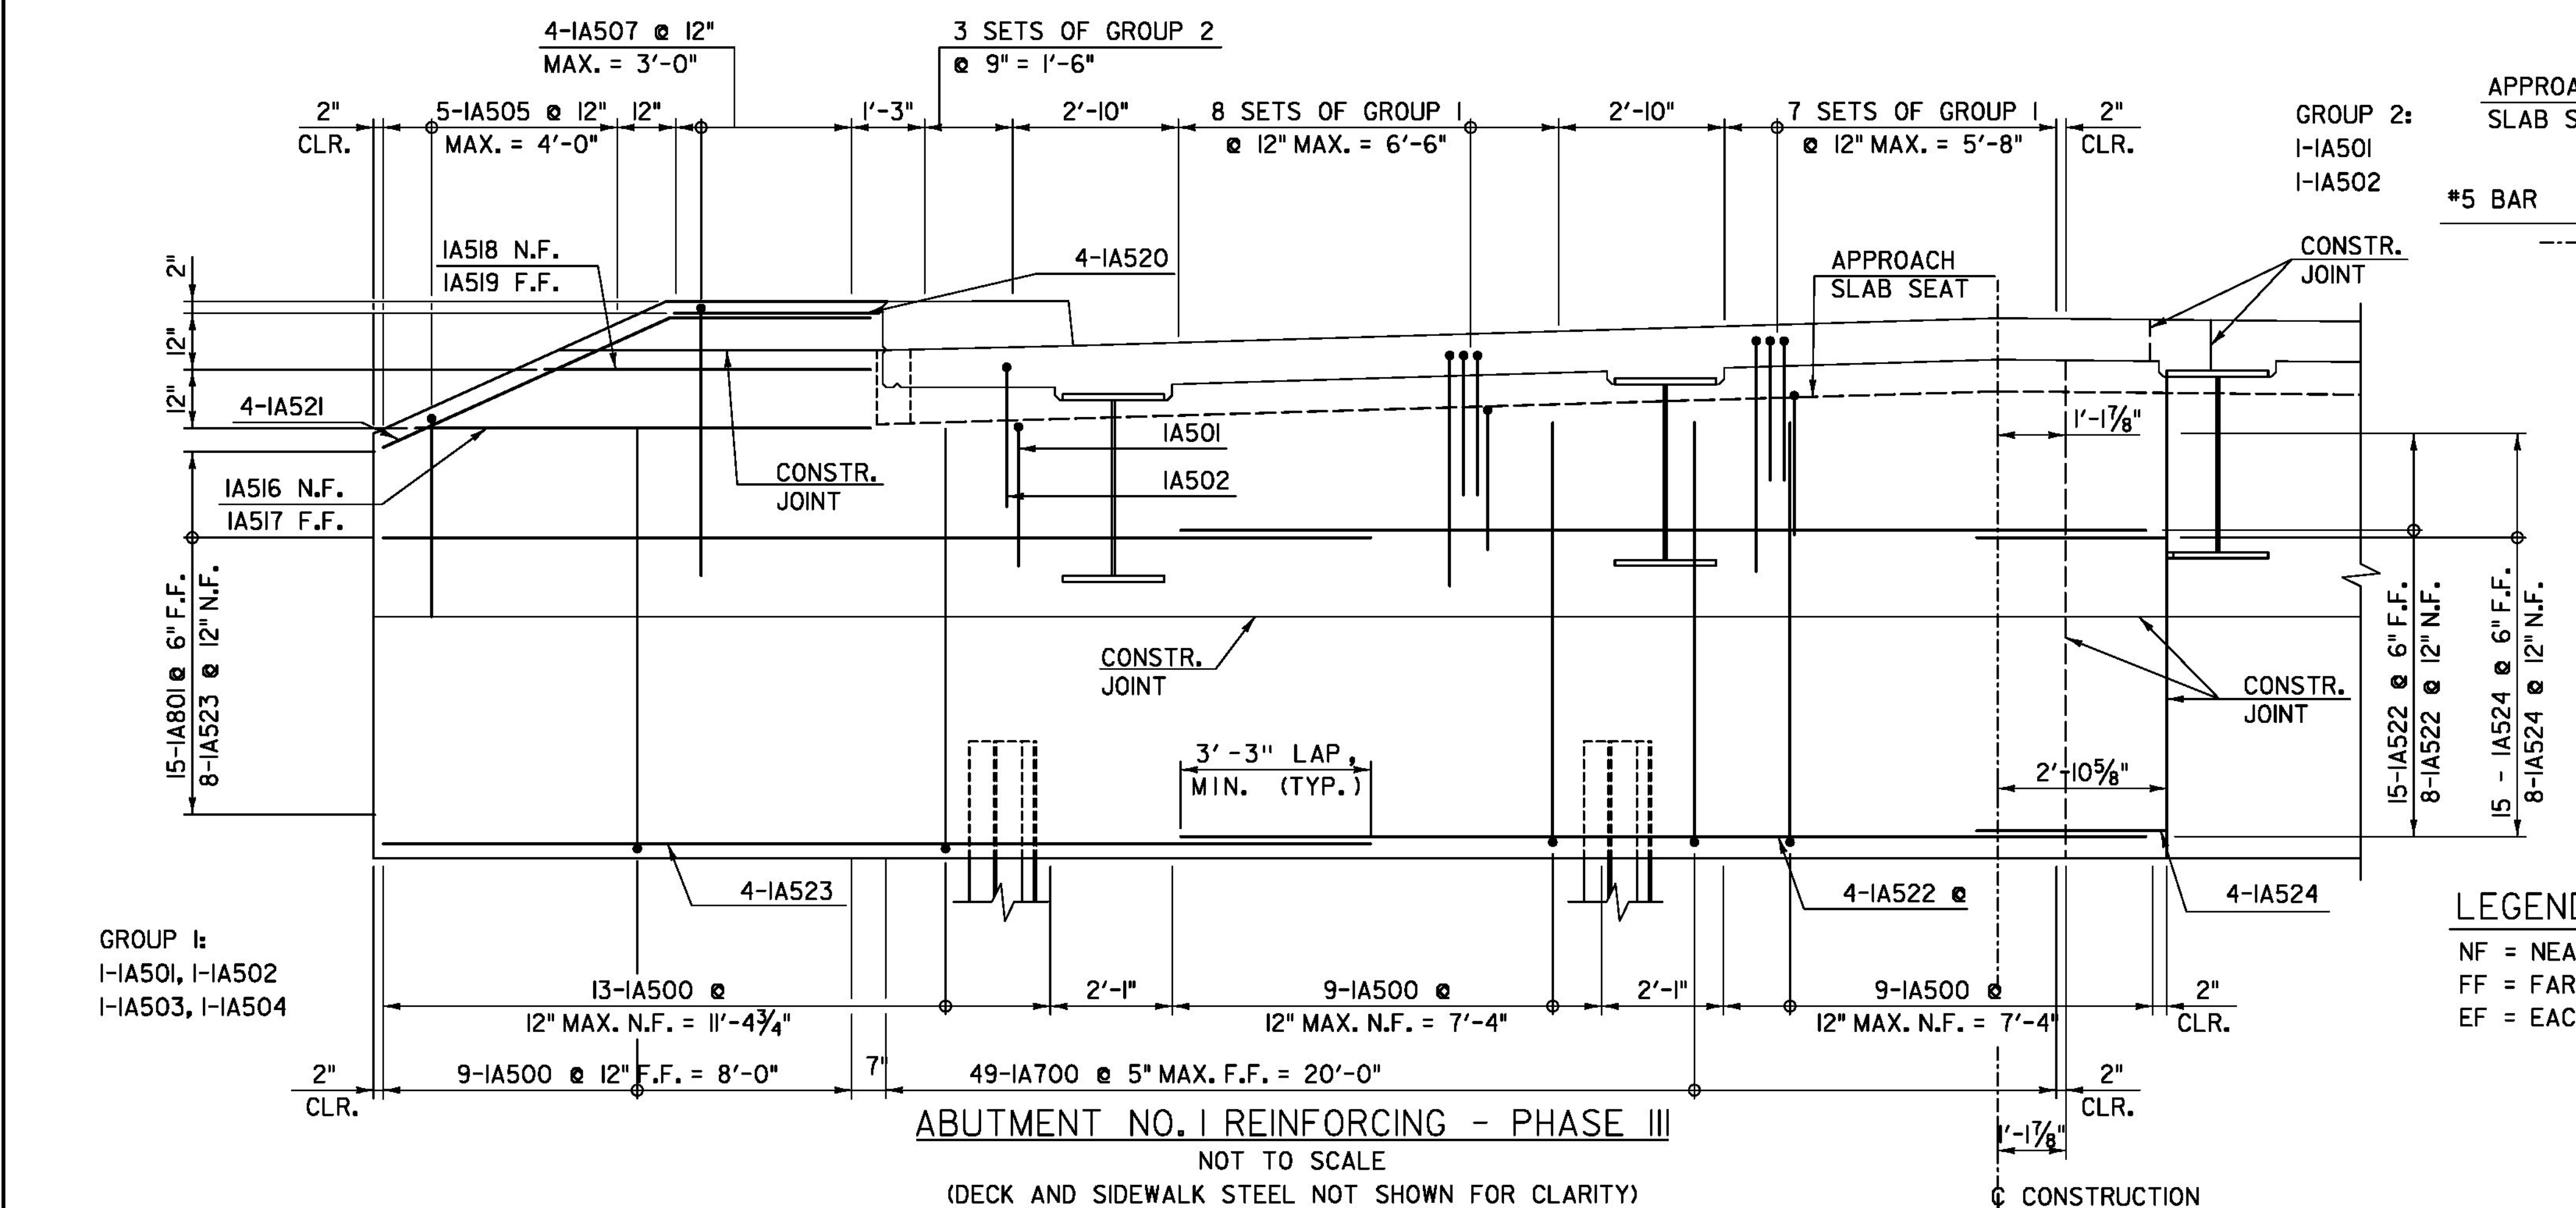

ABUTMENT NO. I REINFORCING - PHASE III
 NOT TO SCALE
 (DECK AND SIDEWALK STEEL NOT SHOWN FOR CLARITY)

NOTE:
 1. ADJUST BAR SPACING AS REQUIRED TO AVOID ABUTMENT UTILITY PENETRATIONS. TRANSVERSE BARS MAY BE CUT AS NECESSARY.

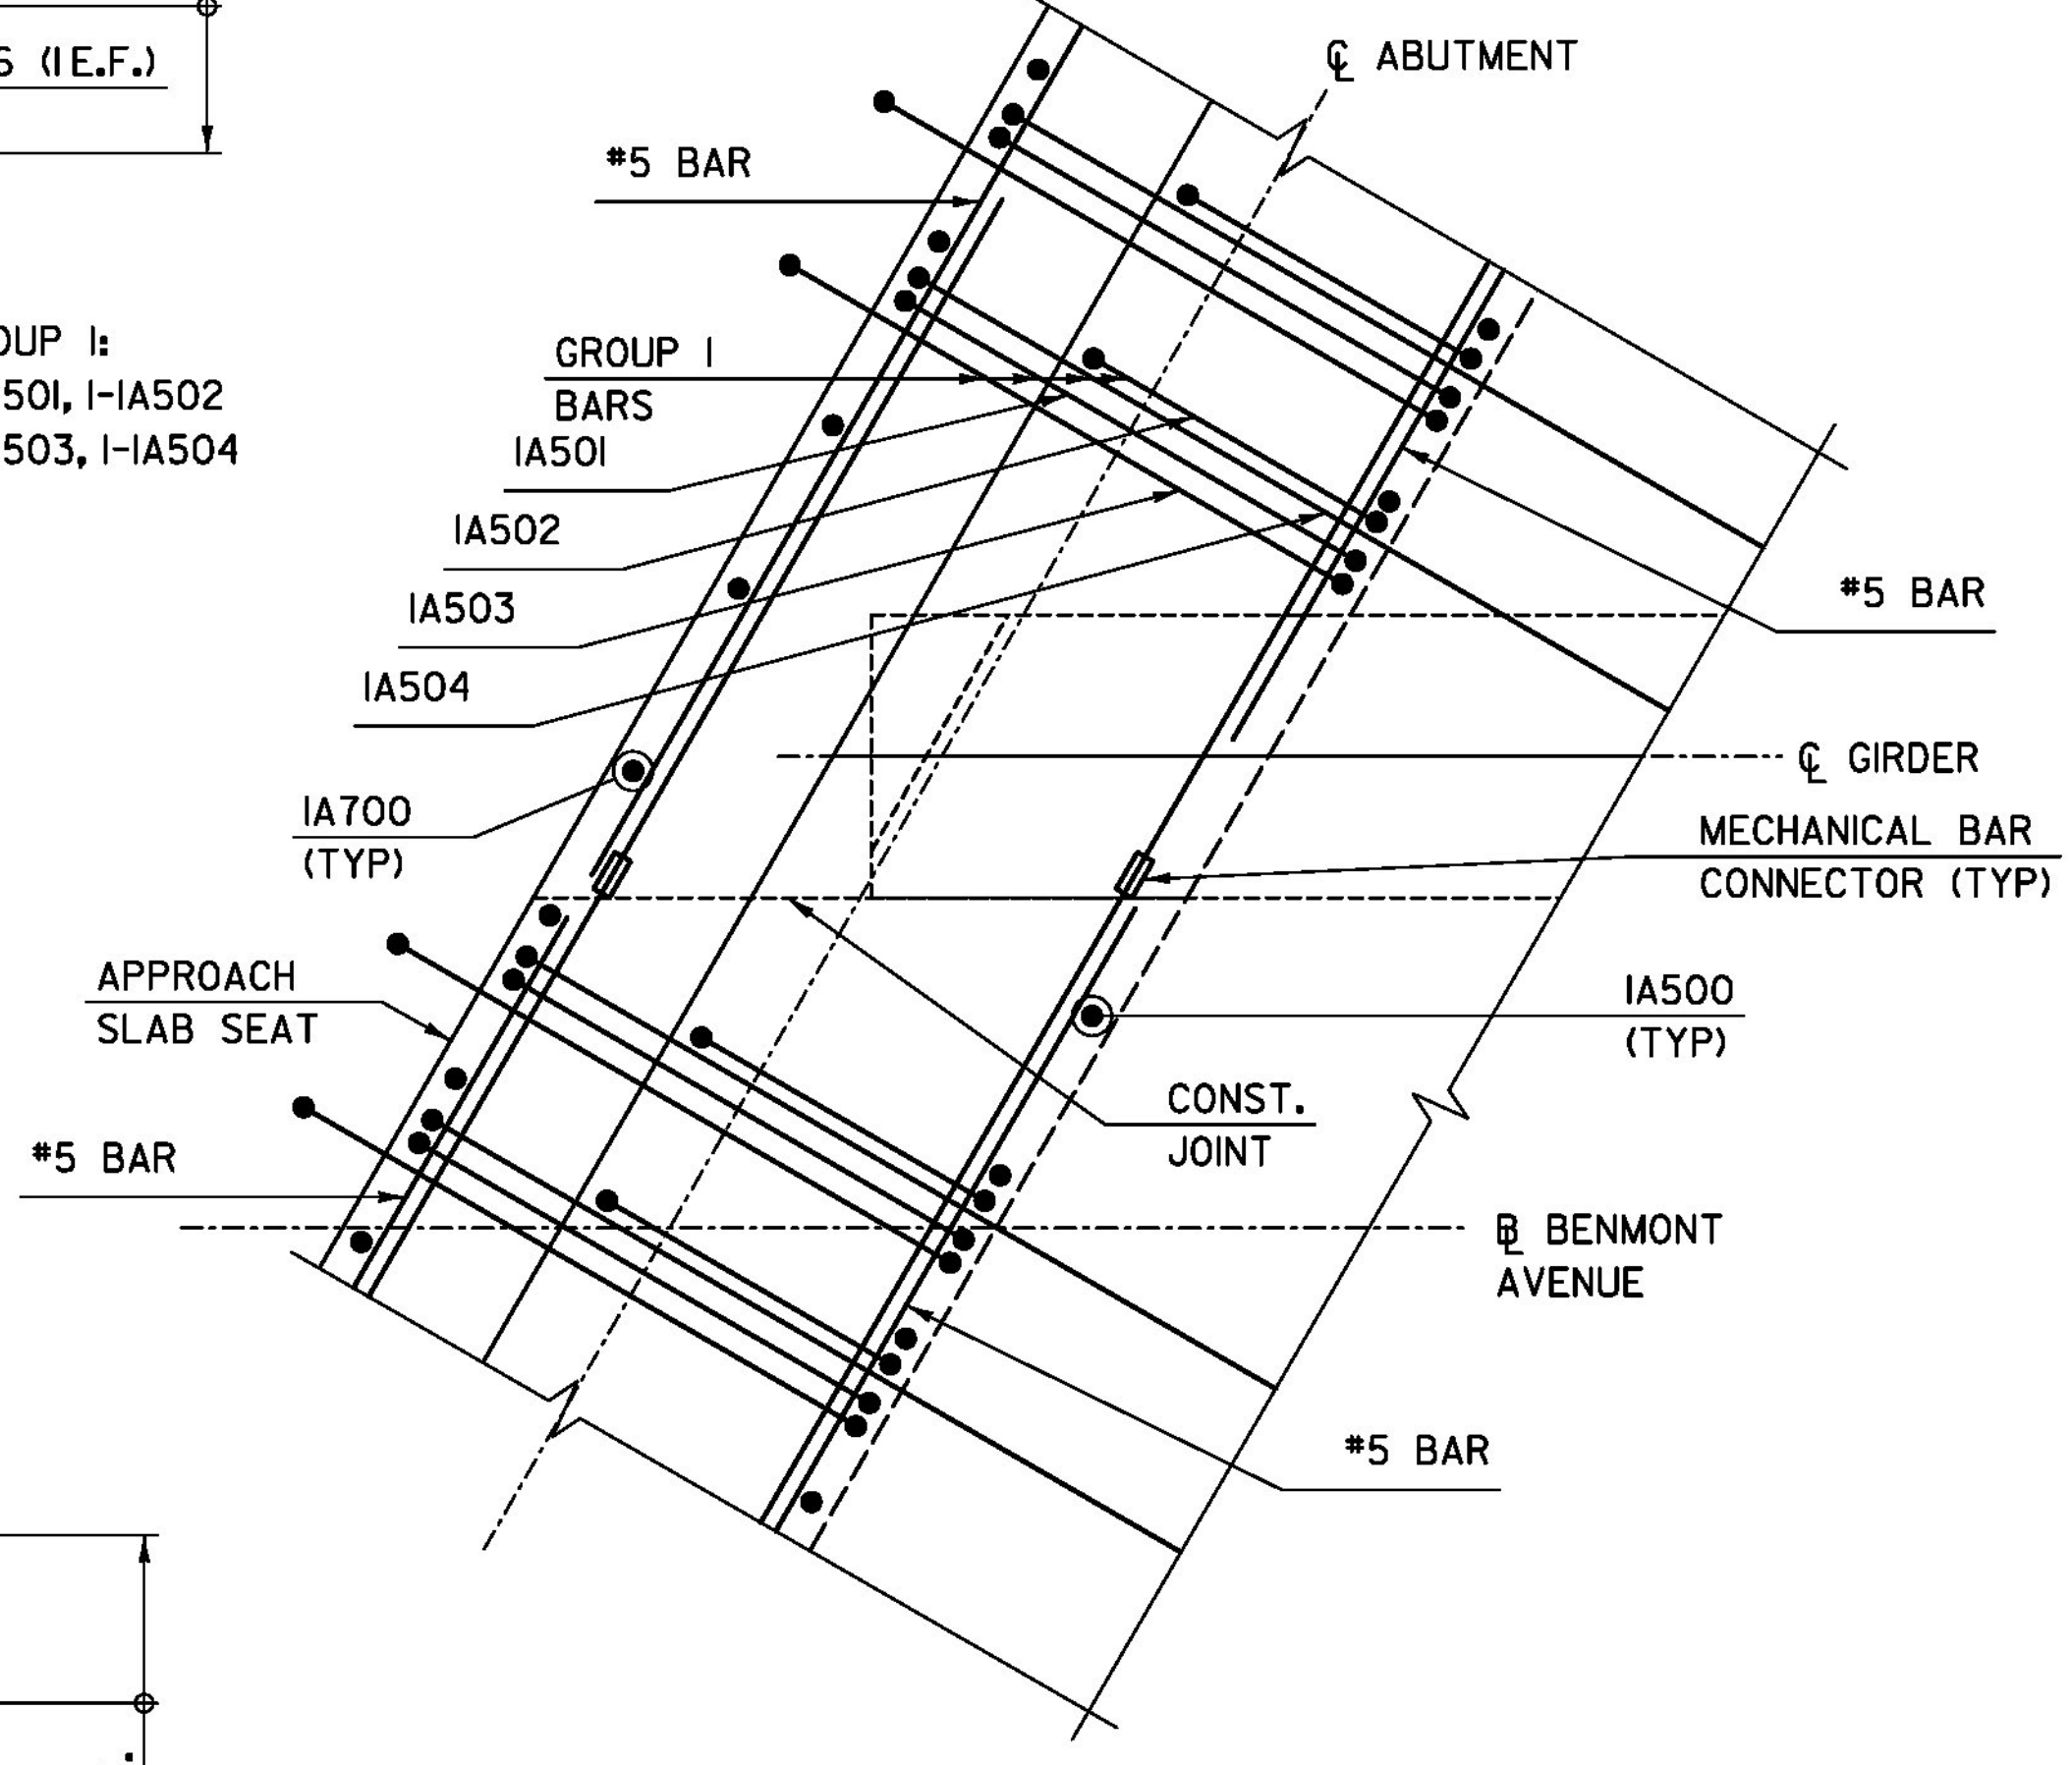

VIEW A-A
 NOT TO SCALE
 (DECK REINFORCEMENT NOT SHOWN FOR CLARITY)

LEGEND:
 NF = NEAR FACE
 FF = FAR FACE
 EF = EACH FACE

PROJECT NAME:	BENNINGTON	PLOT DATE:	8/7/2014
PROJECT NUMBER:	BRF 1000(16)	DRAWN BY:	J. TATE
FILE NAME:	z88j087bdr_abutlr.dgn	CHECKED BY:	R. HEBERT
PROJECT LEADER:	R. HEBERT	ABUTMENT NO. I - REINFORCING	SHEET 47 OF 75