


THIS SHEET REPLACES ORIGINAL CONTRACT SHEET 69

1 WATERMAIN ON BRIDGE - PLAN

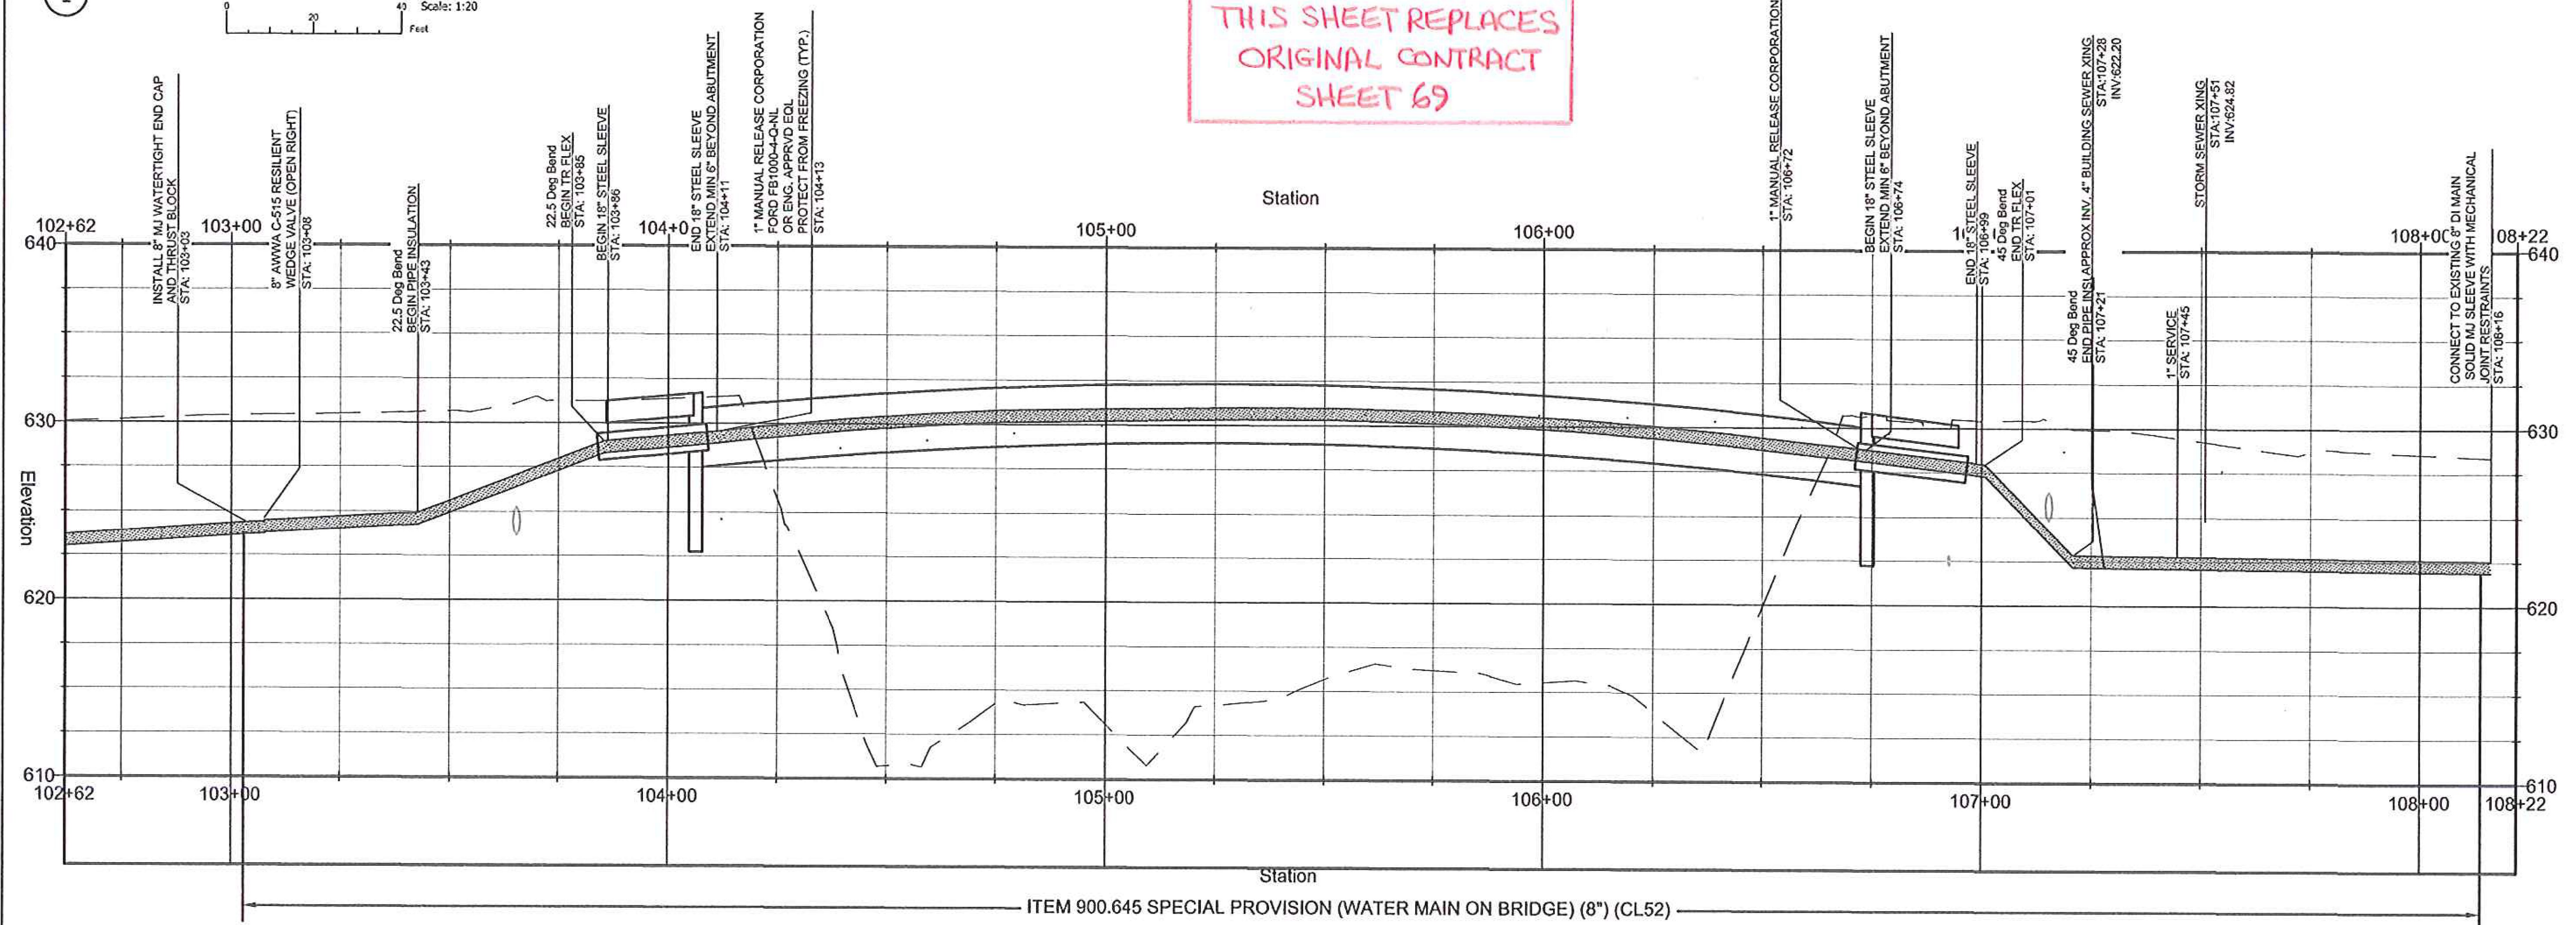

1 WATERMAIN ON BRIDGE - PROFILE

MSK ENGINEERING AND DESIGN, INC.
 P.O. BOX 10, 150 DEPOT STREET
 BENNINGTON, VERMONT 05201
 PH: (802) 447-1402 FAX: (802) 445-1251



NO.	DATE	DESCRIPTION
1	12-10-2013	REVISED FOR PERMITTING
2	01-23-2014	REVISED PER STATE COMMENTS
3	08/26/2015	REVISED FOR CONTRACTOR PRICING

BRF 1000(16)
 BENMONT AVENUE
 BENNINGTON, VT

DRAWINGS THIS SHEET
 WATERLINE
 ALIGNMENT

NUMBER	DATE
DRAWN	11-16-2013
CHECKED	
JMD	

SHEET NUMBER
69 of 75