


1 WATERMAIN ON BRIDGE - PLAN  
Scale: 1:20

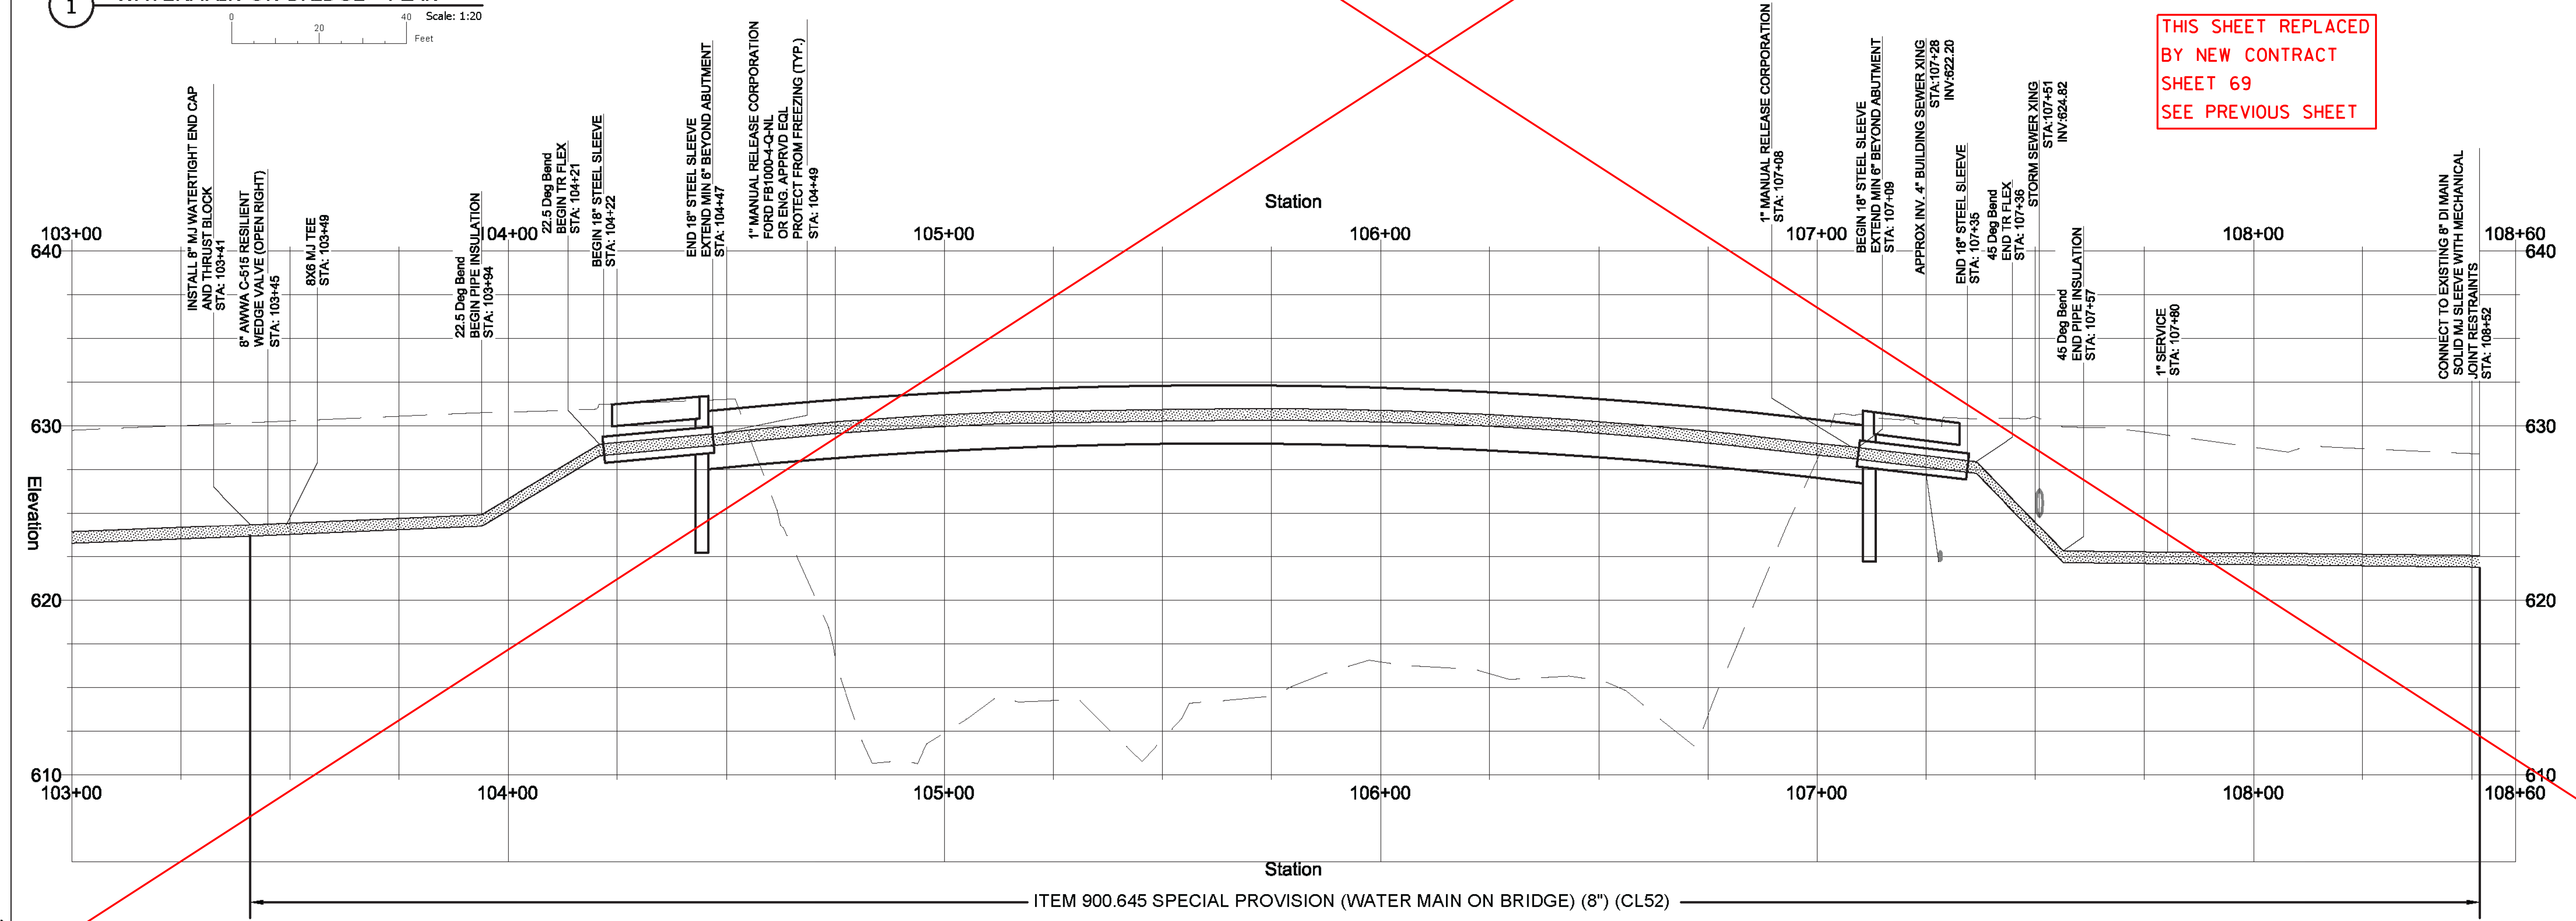

1 WATERMAIN ON BRIDGE - PROFILE  
Horizontal Scale: 1:20 - Vertical Scale: 1:4

THIS SHEET REPLACED  
BY NEW CONTRACT  
SHEET 69  
SEE PREVIOUS SHEET

**MSK ENGINEERING AND DESIGN, INC.**  
P.O. BOX 10, 150 DEPOT STREET  
BENNINGTON, VERMONT 05201  
PH: (802) 447-1462 FAX: (802) 448-1291

NO.	DATE	DESCRIPTION
1	12-10-2013	REVISED FOR PERMITTING
2	01-23-2014	REVISED PER STATE COMMENTS

BRF 1000(16)  
BENMONT AVENUE  
BENNINGTON, VT

DRAWINGS THIS SHEET  
WATERLINE  
ALIGNMENT

NUMBER	DATE
	11-16-2013
DRAWN	CHECKED
.MD	

SHEET NUMBER  
**69 of 75**