


PLAN

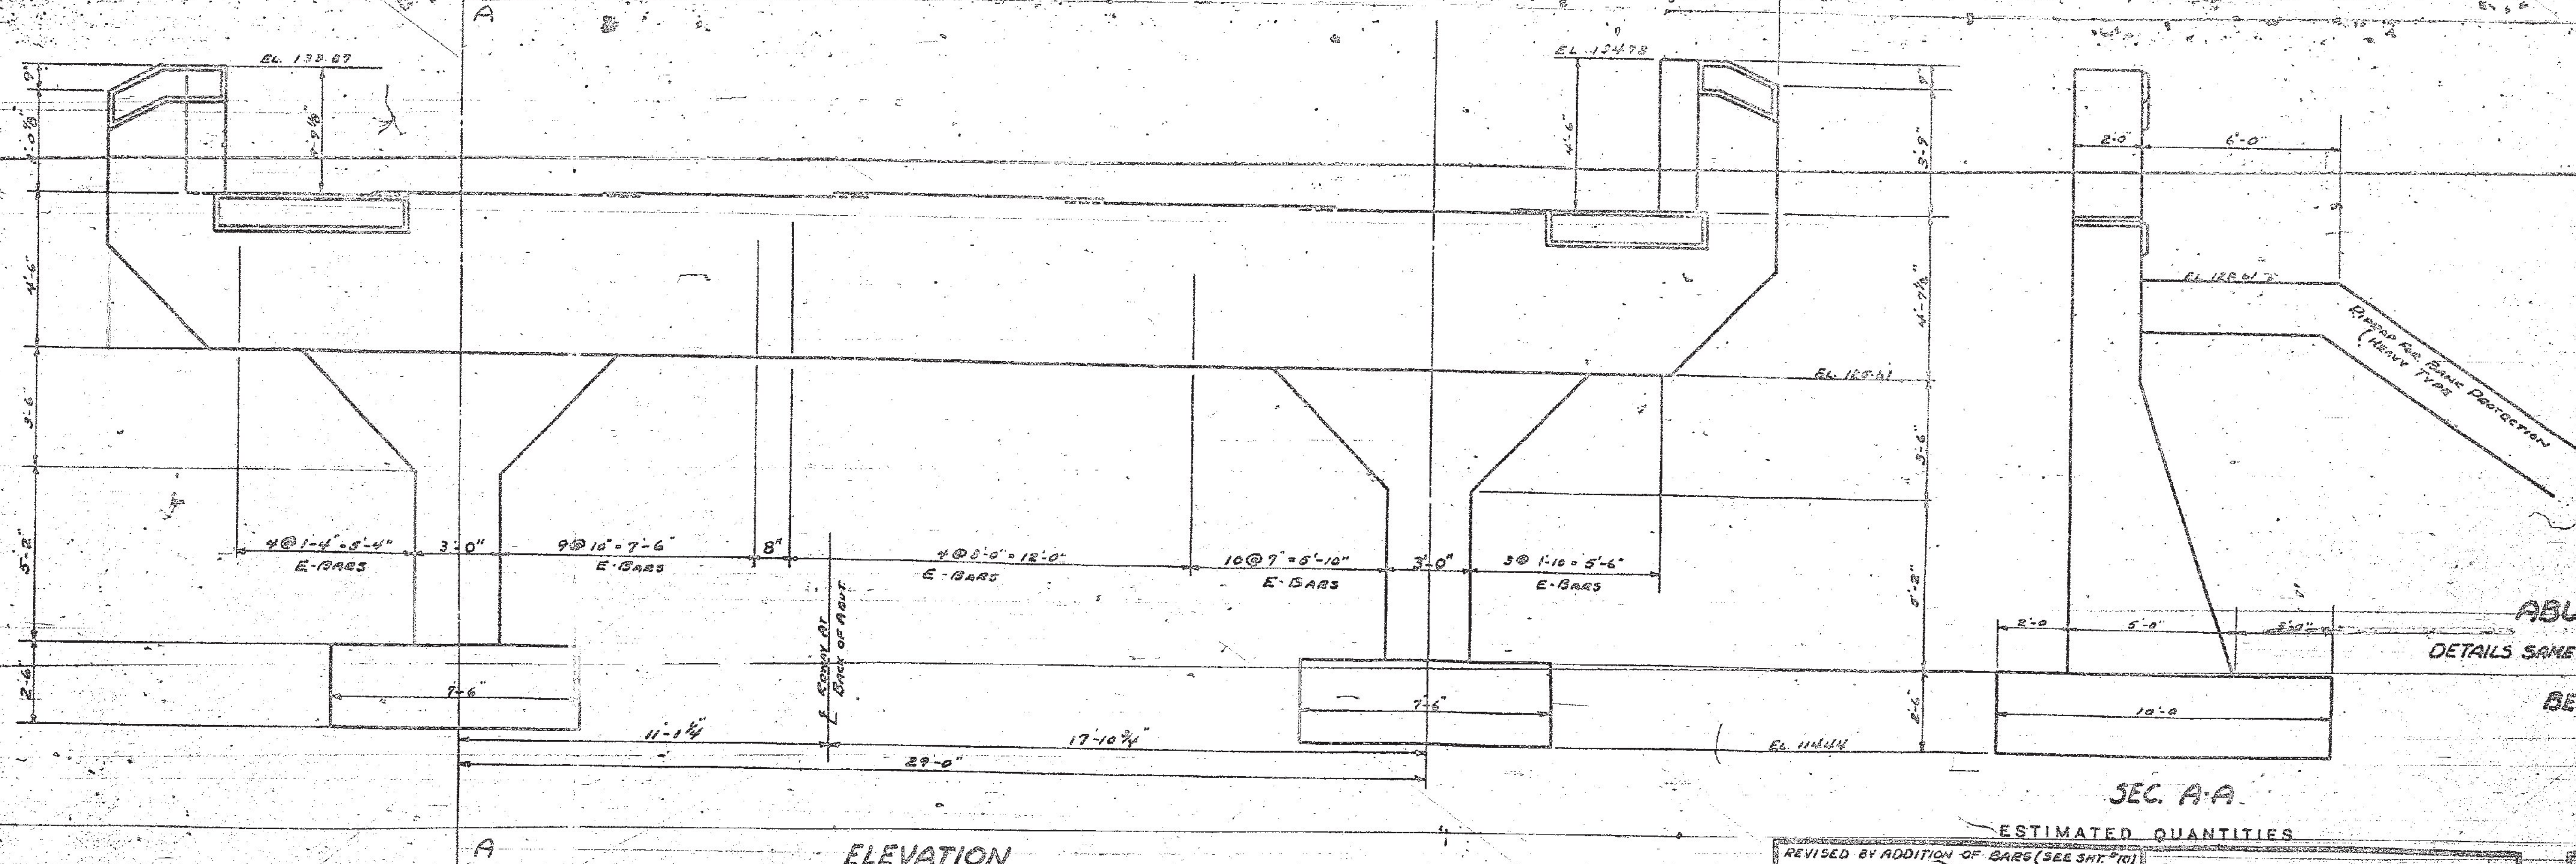

ELEVATION

ABUTMENT NO. 2

DETAILS SAME AS FOR ABUT. 1, EXCEPT AS SHOWN

BENNINGTON, VT.

F.A.P. - 23

SCALE 3/8" = 1'-0"

SEC. A-A

ESTIMATED QUANTITIES

REVISED BY ADDITION OF BARS (SEE SH. 10) MAR. 1933 J.G.G.	
STRUCTURE EXCAVATION	146 C.Y.
CONCRETE CLASS "A"	41 C.Y.
REINFORCING STEEL	8813 LBS.
RIP RAP FOR BANK PROTECT. (HEAVY TYPE)	197 C.Y.

Surveyed by	J.G.G.
Designed by	J.G.G.
Drawn by	H.W.S.
Checked by	H.W.S.
Scale	F.A.P. No. 23
Sheet	11 of 11
Sheets	11 of 11