


MK	QTY	DESCRIPTION	MATERIAL	LENGTH	REMARKS	WT*	REV
3A	12	SINGLE END ROD					13
3ar1	12	Ø1.500" X 25.000" SINGLE END ROD	M314 GR 55 (F1554)		8" THRD; M232-HDG (A153)		13
3B	24	HEX NUT					1
3hn1	24	Ø1.500" HEX NUT	M291-DH OR M292-2H (A563 OR A194) HEAVY HEX		M232-HDG (A153), DRY LUBE & DYE		1
3C	12	WASHER PLATE					2
3wp1	12	0.250" X 7.000"	M183 (A36)	4.000"	Ø1.625" HOLE CTR.; M111-HDG (A123)		2
*Approx. Gross Wt. Lbs Per Single Unit							
						1/5/15 2:37:03 PM	

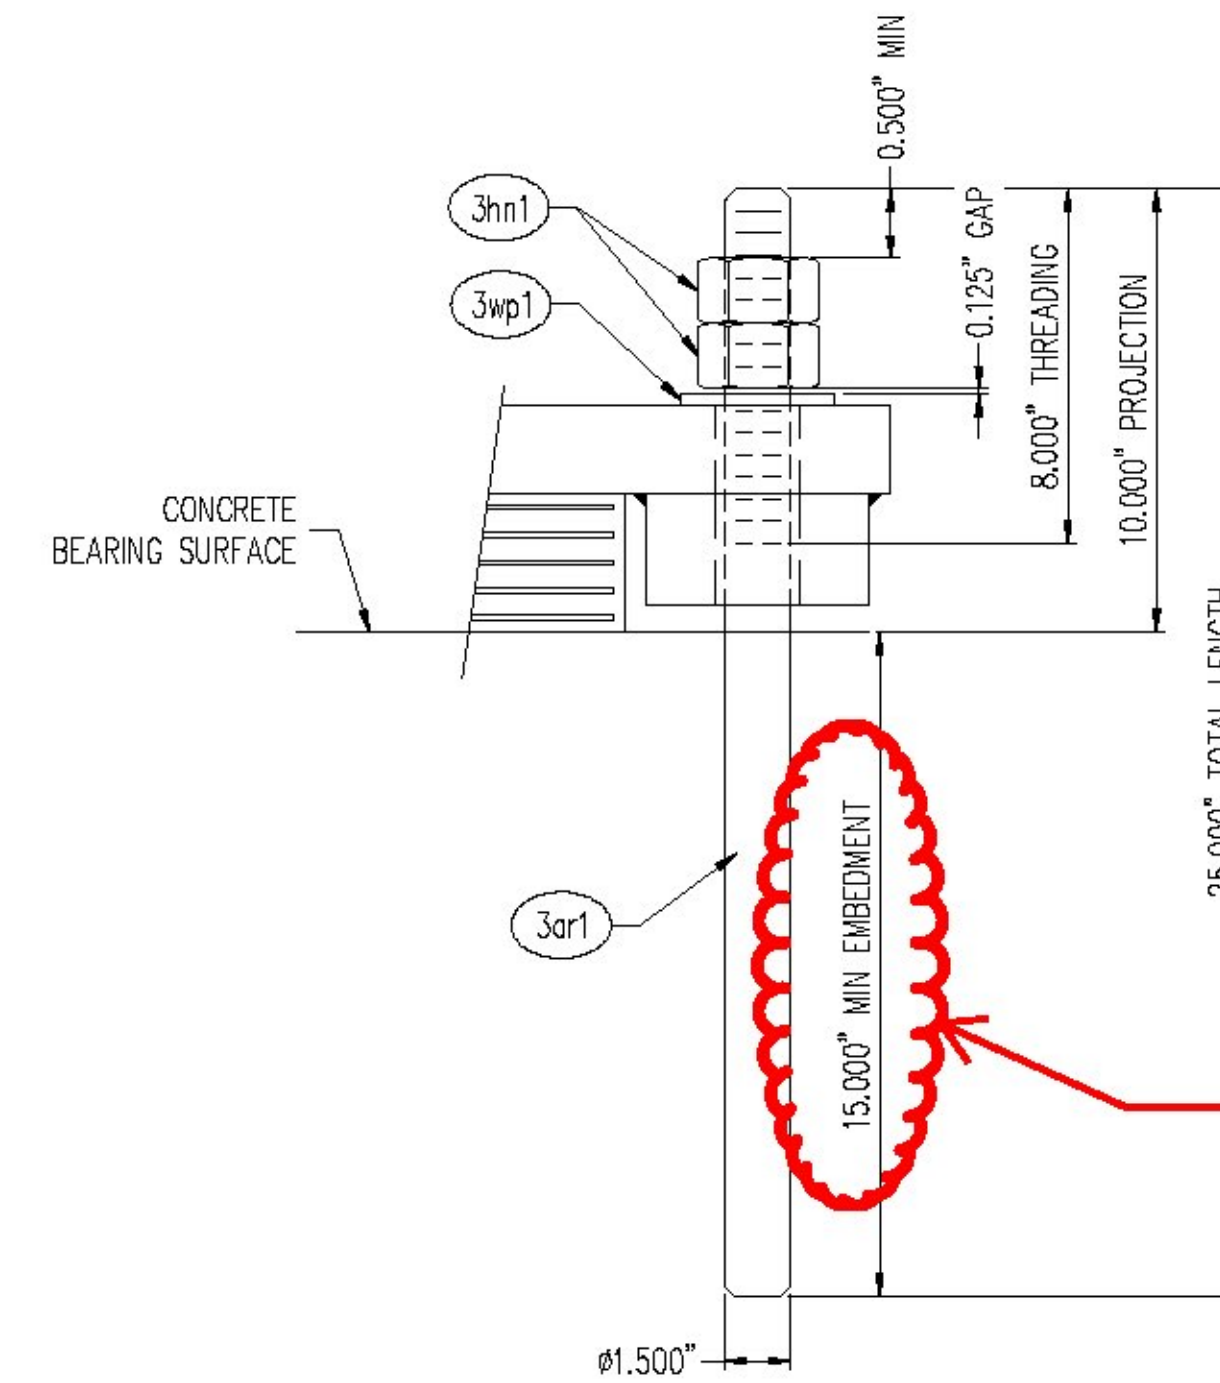

Embedded length shall be swaged or threaded.

ANCHOR ROD ASSEMBLY

- (6) REQ'D @ PIER 1; G2-G4
- (6) REQ'D @ PIER 2; G2-G4
- (12) REQ'D TOTAL

T.Y. LIN INTERNATIONAL

THE STAMPED DOCUMENTS ARE HEREBY:

- ____ APPROVED
- X APPROVED AS NOTED
- ____ REVISE AND RESUBMIT

SEE TRANSMITTAL FOR ADDITIONAL INFORMATION AS APPLICABLE.

THIS REVIEW IS FOR GENERAL CONFORMANCE WITH DESIGN CONCEPT ONLY. ANY DEVIATION FROM THE PLANS OR SPECIFICATIONS NOT CLEARLY NOTED BY THE CONTRACTOR HAS NOT BEEN REVIEWED. REVIEW BY THE ENGINEER SHALL NOT RELIEVE THE CONTRACTOR OF THE CONTRACTUAL RESPONSIBILITY FOR ANY ERRORS OR DEVIATION FROM THE CONTRACT REQUIREMENTS.

RICK HEBERT
REVIEWER

1/21/2015
DATE

SEE SHEET 45651-1104-GN1 FOR GENERAL NOTES

REV.	DESCRIPTION	DATE	DET.	CKD.

D.S. BROWN
A GIBRALTAR INDUSTRIES COMPANY
THE D.S. BROWN COMPANY
300 E. CHERRY STREET
NORTH BALTIMORE, OHIO 45872
419.257.3561
FAX: 419.257.0332
WWW.DSBROWN.COM



LOCATION	ITEM	QUANTITY
LOCATION — BENMONT AVE. (TH-7) (URBAN MINOR ARTERIAL)		
BRIDGE — 57		
PROJECT NAME — BENNINGTON		
PROJECT NO. — BRF 1000 (16)		
P.O. NO. — 2014-086-004		
DESIGNER — TY-LIN INTERNATIONAL		
CUSTOMER — ALPINE CONSTRUCTION, LLC		

DESCRIPTION	SCALE	DRAWN BY	CHECKED BY	DATE
ANCHOR ROD ASSEMBLY BENNINGTON COUNTY, VT	N.T.S.	SP	EAK	1/15
	PROJECT NUMBER	PRODUCT CODE	RELEASE	SHEET
	45651	1104	-	03