



TYP. ELEVATION

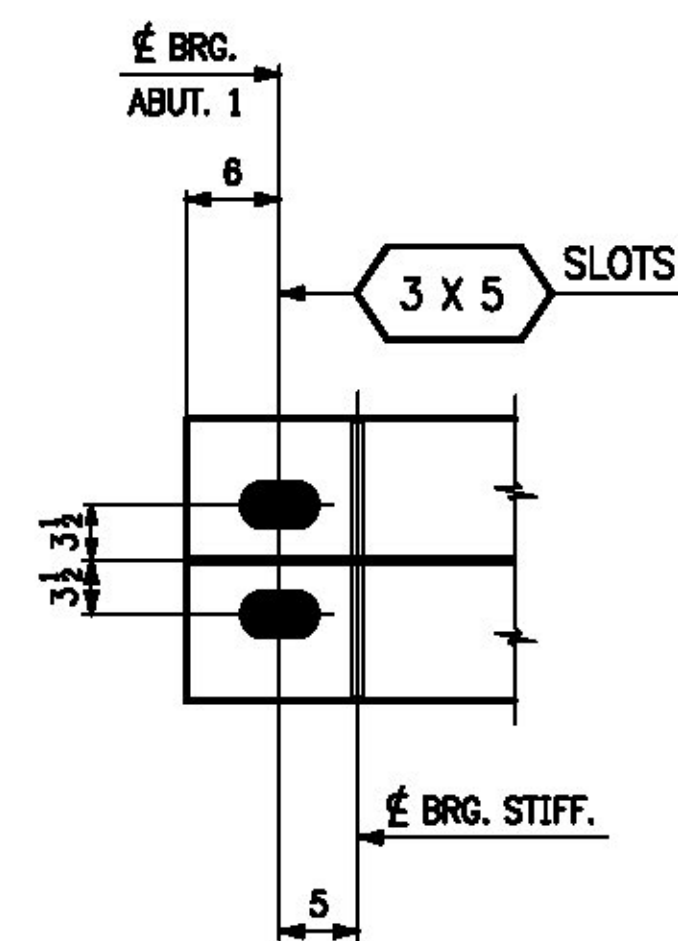

BOTTOM FLANGE DETAIL

ABUT. 1 - SHOWN
ABUT. 2 - ROT. 180°

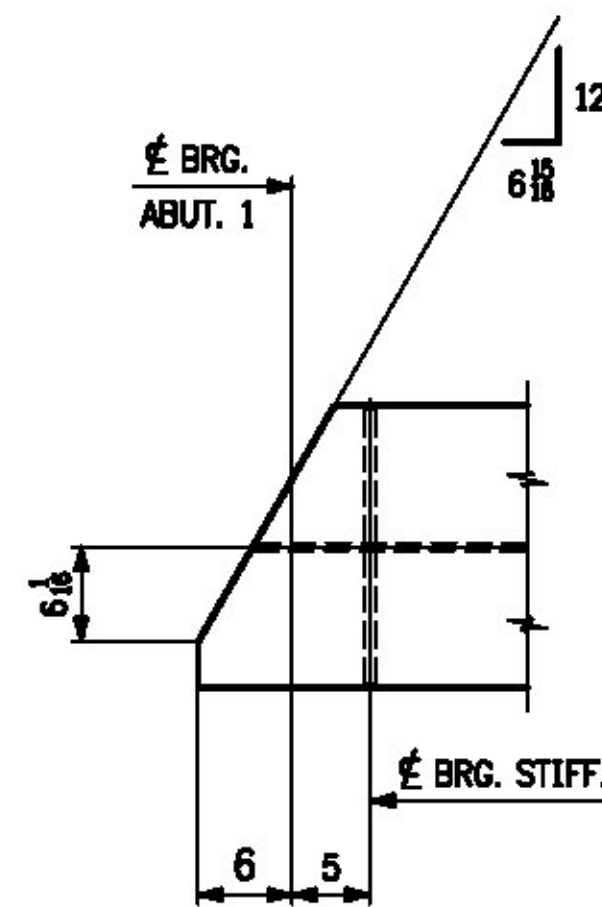

TOP FLANGE DETAIL

ABUT. 1 - SHOWN
ABUT. 2 - ROT. 180°

FINAL GRADE @ E BRGS				
LINE	ABUT 1	PIER 1	PIER 2	ABUT 2
1	.0225	.0062	-.0122	-.0311
2	.0235	.0070	-.0116	-.0301
3	.0244	.0080	-.0104	-.0291
4	.0252	.0090	-.0094	-.0281
5	.0260	.0099	-.0085	-.0271

T.Y. LIN INTERNATIONAL

THE STAMPED DOCUMENTS ARE HEREBY:

- APPROVED
- APPROVED AS NOTED
- REVISE AND RESUBMIT

SEE TRANSMITTAL FOR ADDITIONAL INFORMATION AS APPLICABLE.

THIS REVIEW IS FOR GENERAL CONFORMANCE WITH DESIGN CONCEPT ONLY. ANY DEVIATION FROM THE PLANS OR SPECIFICATIONS NOT CLEARLY NOTED BY THE CONTRACTOR HAS NOT BEEN REVIEWED. REVIEW BY THE ENGINEER SHALL NOT RELIEVE THE CONTRACTOR OF THE CONTRACTUAL RESPONSIBILITY FOR ANY ERRORS OR DEVIATION FROM THE CONTRACT REQUIREMENTS.

RICK HEBERT
REVIEWER

2/2/2015
DATE

NO.	DATE	REMARKS	BY
REVISIONS			
		CASCO BAY STEEL STRUCTURES ONE WALLACE AVENUE SOUTH PORTLAND, ME 04106 PHONE: 207-780-6722 FAX: 207-780-6726	
STRUCTURE	BENMONT AVE. (TH-7) (URBAN MINOR ARTERIAL)		
LOCATION	TOWN OF BENNINGTON, VERMONT		
PROJECT NO.	BRIDGE NO. 57 PROJECT NO. BRP 1000(16)		
ENGINEER	STATE OF VERMONT AGENCY OF TRANSPORTATION		
CUSTOMER	ALPINE CONSTRUCTION		
ITEM	CALC PLAN		
SURFACE PREP.	OPEN HOLES		
PAINT			
APPROVAL	DRAWN WCG 12-2-14	SHEET NO. WS2	JOB NO. 605
SHOP	CHECKED [Signature] 12-5-14		

THIS IS A WORK DRAWING. ITS FUNCTION IS TO PROVIDE BASIC DIMENSIONS AND CONCEPTS FOR USE IN THE PREPARATION OF THE SHOP DETAILS. IT IS NOT INTENDED TO BE USED FOR ERECTION OR FABRICATION.