

# T.Y. LIN INTERNATIONAL

THE STAMPED DOCUMENTS ARE HEREBY:


- APPROVED
- APPROVED AS NOTED
- REVISE AND RESUBMIT

SEE TRANSMITTAL FOR ADDITIONAL INFORMATION AS APPLICABLE.


THIS REVIEW IS FOR GENERAL CONFORMANCE WITH DESIGN CONCEPT ONLY. ANY DEVIATION FROM THE PLANS OR SPECIFICATIONS NOT CLEARLY NOTED BY THE CONTRACTOR HAS NOT BEEN REVIEWED. REVIEW BY THE ENGINEER SHALL NOT RELIEVE THE CONTRACTOR OF THE CONTRACTUAL RESPONSIBILITY FOR ANY ERRORS OR DEVIATION FROM THE CONTRACT REQUIREMENTS.

RICK HEBERT  
REVIEWER

2/2/2015  
DATE

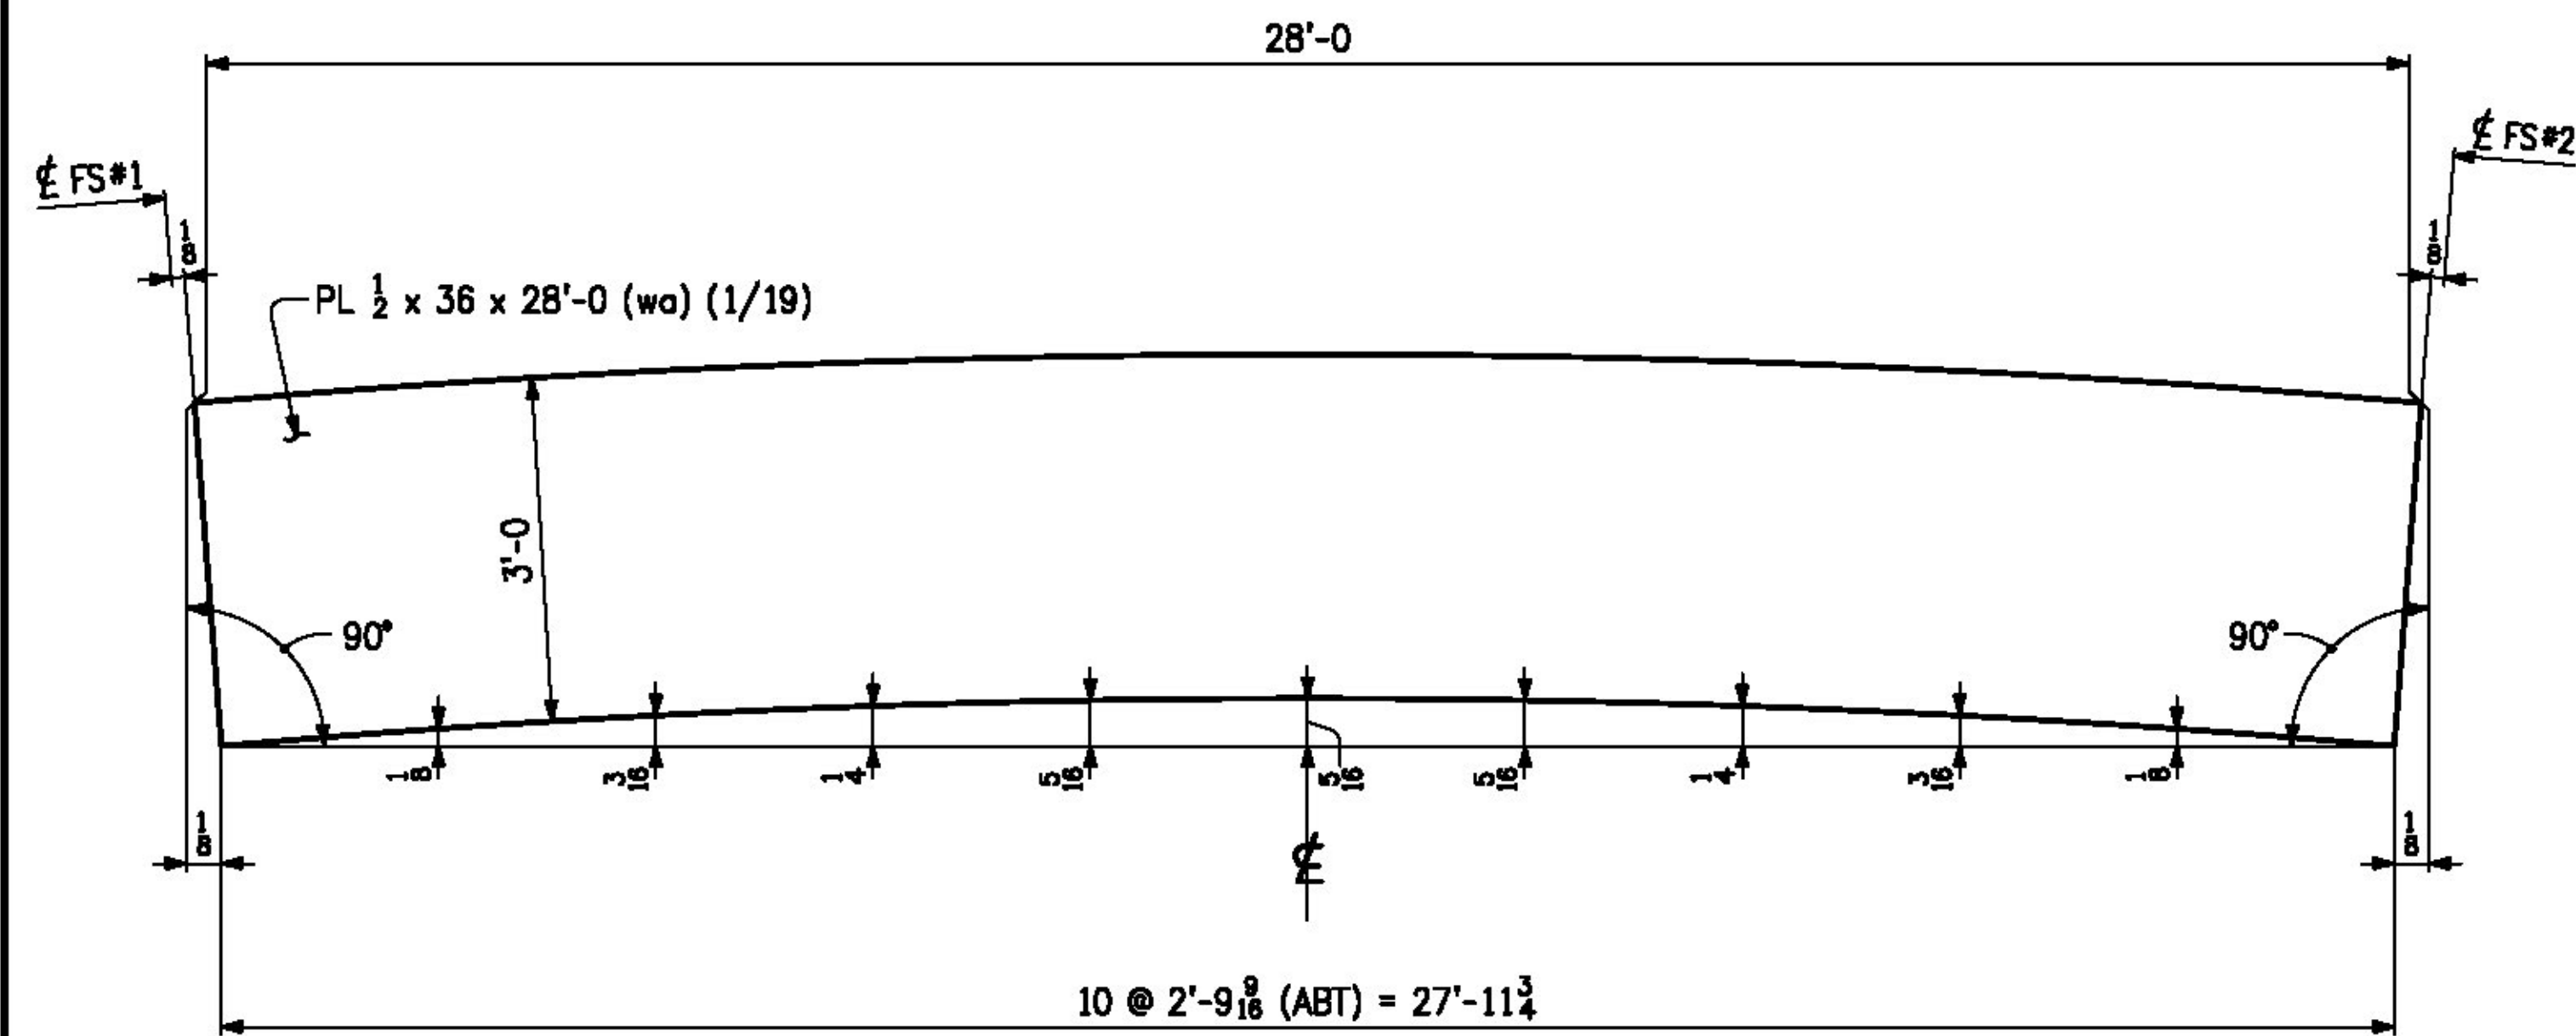

**CAMBER DIAGRAM FOR 6G1B, 7G2B, 8G3B, 9G4B & 10G5B**

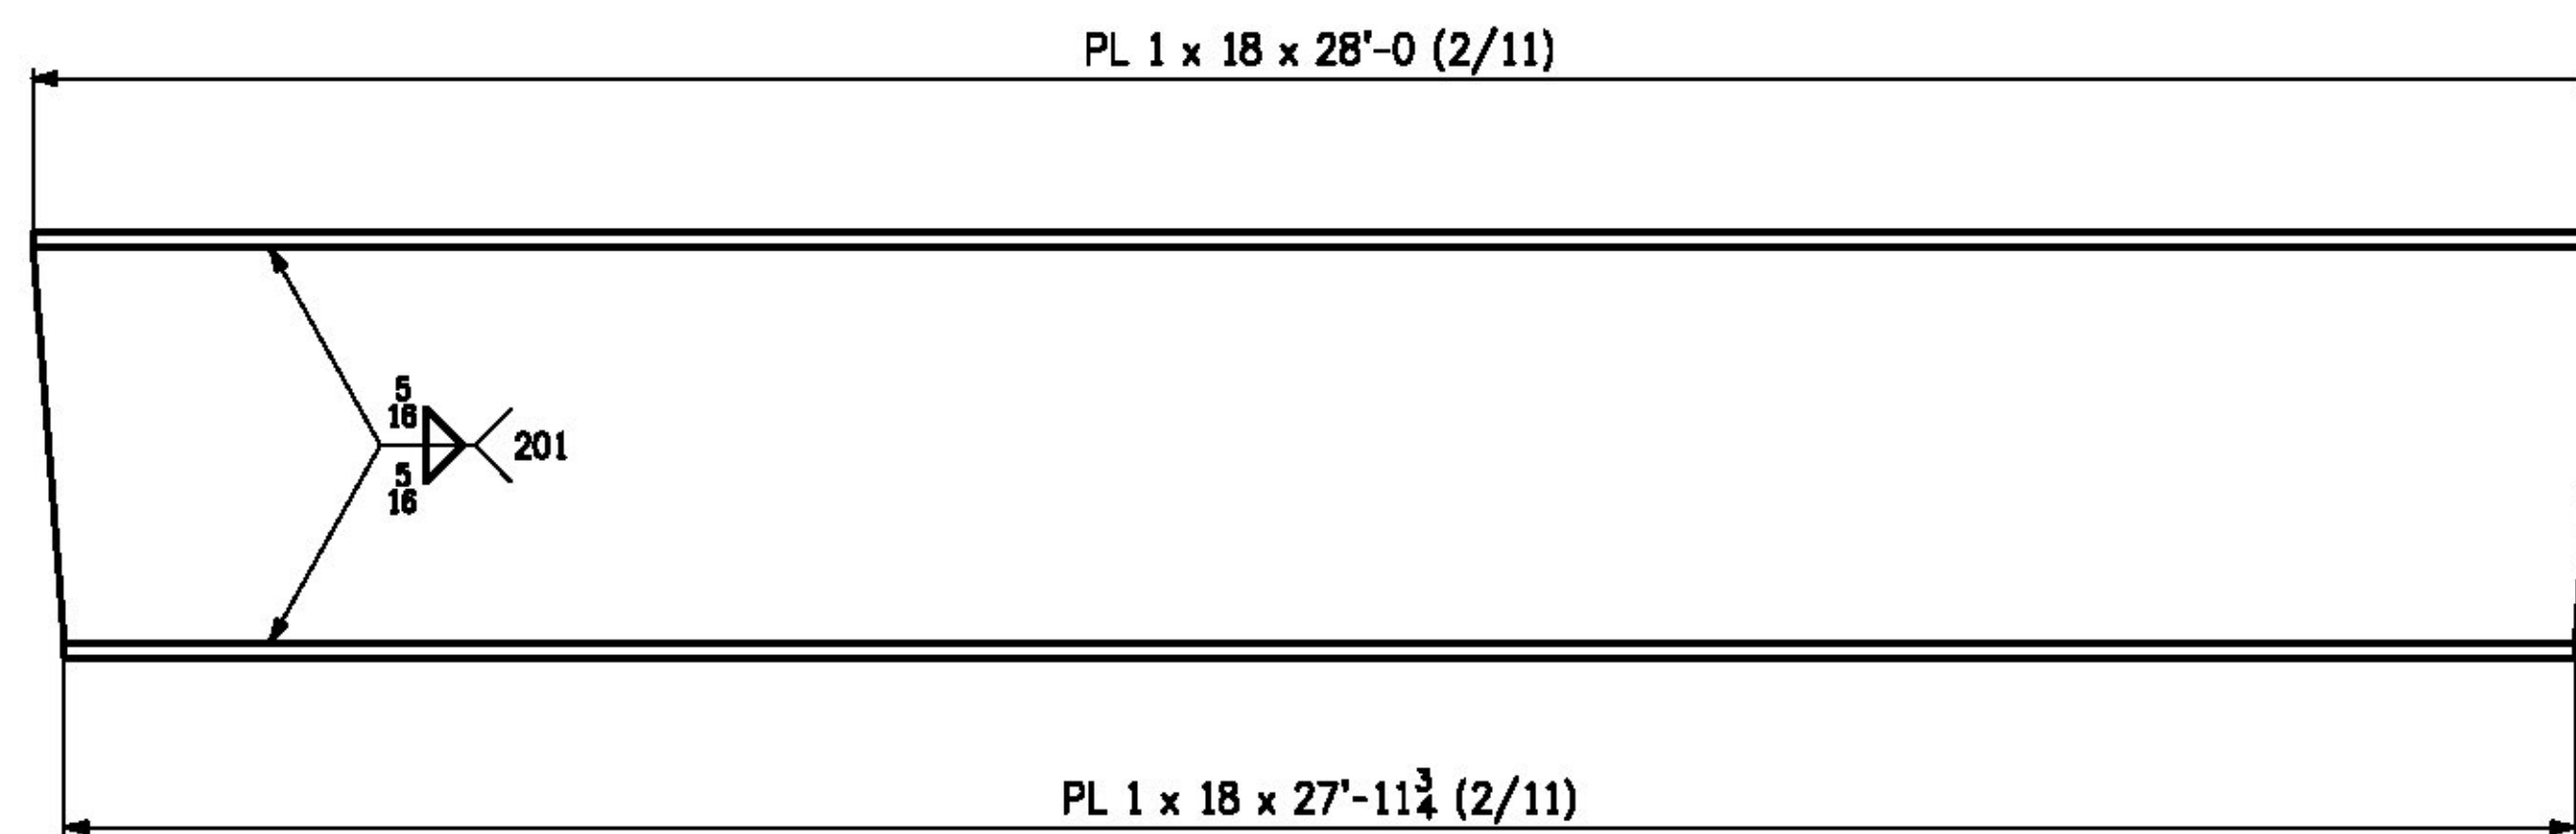

**FLANGE DIAGRAM FOR 6G1B, 7G2B, 8G3B, 9G4B & 10G5B**

**NOTES:**

- MAT'L: M270-50WT2
- FOR GENERAL NOTES SEE SHT. GN1.

NO.	DATE	REMARKS	BY
REVISIONS			
		<b>CASCO BAY STEEL STRUCTURES</b> ONE WALLACE AVENUE      PHONE: 207-780-6722 SOUTH PORTLAND, ME 04106      FAX: 207-780-6726	
STRUCTURE <u>BENMONT AVE. (TH-7) (URBAN MINOR ARTERIAL)</u>			
LOCATION <u>TOWN OF BENNINGTON, VERMONT</u>			
PROJECT NO. <u>BRIDGE NO. 57</u> PROJECT NO. <u>BRF 1000(16)</u>			
ENGINEER <u>STATE OF VERMONT AGENCY OF TRANSPORTATION</u>			
CUSTOMER <u>ALPINE CONSTRUCTION</u>			
ITEM <u>WEB &amp; FLANGE CUTTING DIAGRAMS</u>			
SURFACE PREP. _____ OPEN HOLES _____			
PAINT _____			
APPROVAL	DRAWN	DMM	12-8-14
SHOP	CHECKED	FM	1-2-15
SHEET NO. <b>C3</b>		JOB NO. <b>605</b>	