

# T.Y. LIN INTERNATIONAL

THE STAMPED DOCUMENTS ARE HEREBY:


- X   APPROVED
- APPROVED AS NOTED
- REVISE AND RESUBMIT

SEE TRANSMITTAL FOR ADDITIONAL INFORMATION AS APPLICABLE.

THIS REVIEW IS FOR GENERAL CONFORMANCE WITH DESIGN CONCEPT ONLY. ANY DEVIATION FROM THE PLANS OR SPECIFICATIONS NOT CLEARLY NOTED BY THE CONTRACTOR HAS NOT BEEN REVIEWED. REVIEW BY THE ENGINEER SHALL NOT RELIEVE THE CONTRACTOR OF THE CONTRACTUAL RESPONSIBILITY FOR ANY ERRORS OR DEVIATION FROM THE CONTRACT REQUIREMENTS.

\_\_\_\_\_  
RICK HEBERT  
REVIEWER

\_\_\_\_\_  
2/2/2015  
DATE

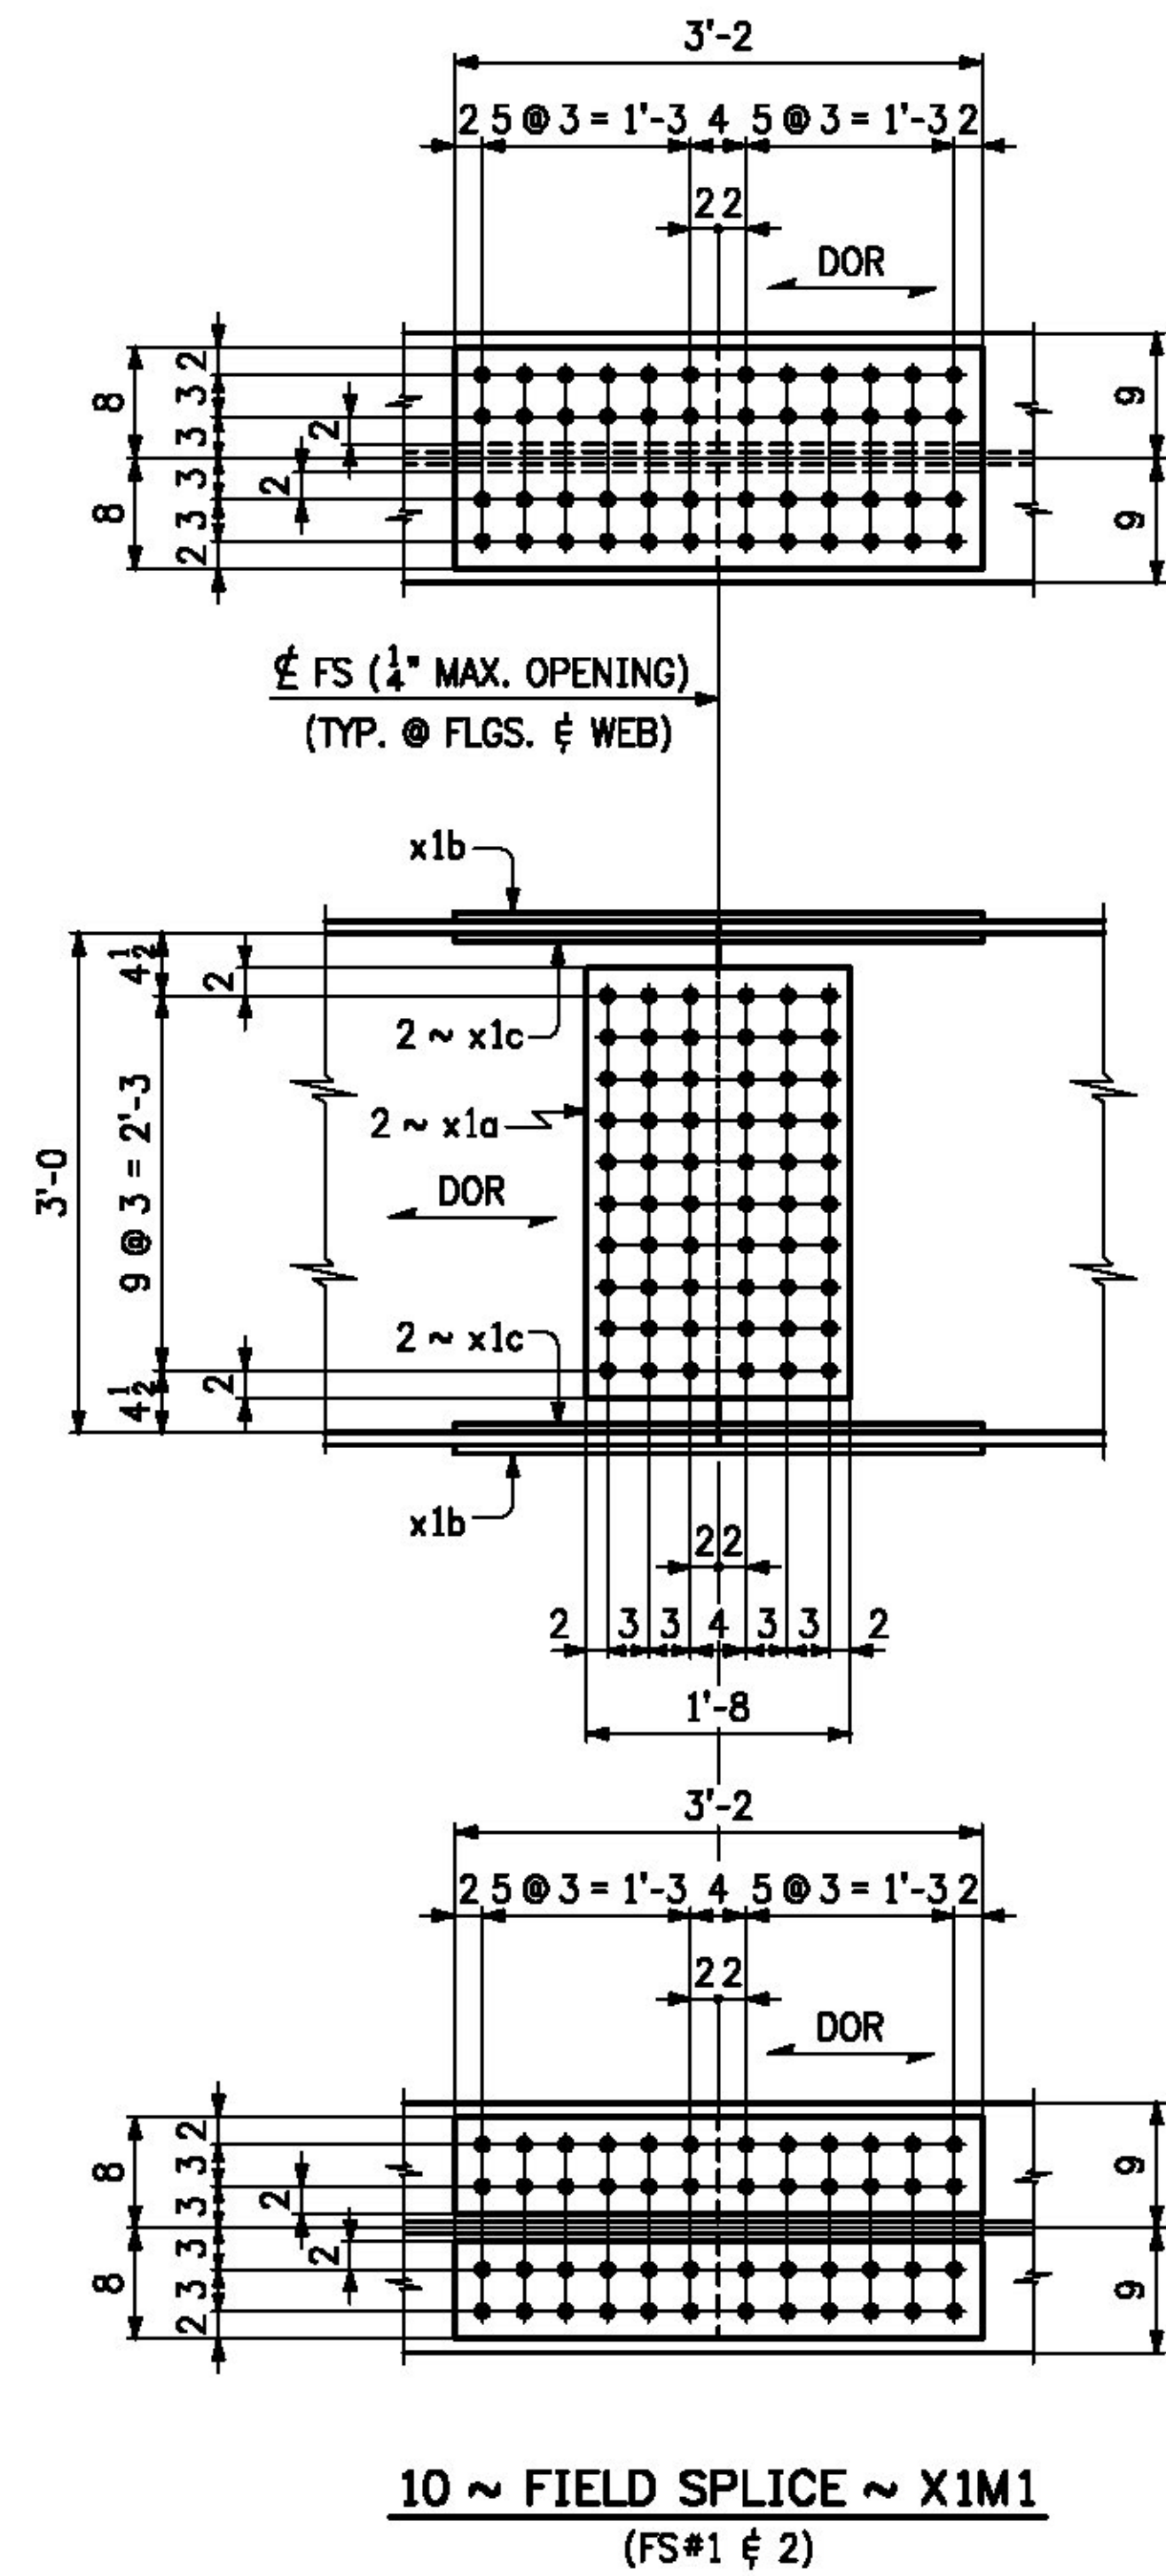

LINE	NO. OF PCS.	SHIP MARK	ASSY MARK	MATERIAL				REMARKS		
				SHAPE	SECTION	LENGTH FT.	IN.		MATERIAL SPEC.	ITEM NO.
1	10	X1M1		FIELD SPLICE				6807 lbs.		
2	20		x1a	PL	1/2 x 31	1	8	M270-50WT2	3 2	1758 lbs.
3	20		x1b	PL	3/4 x 16	3	2	M270-50WT2	3 4	2586 lbs.
4	40		x1c	PL	3/4 x 7	3	2	M270-50WT2	3 6	2263 lbs.
5										
6										
**NOTES:**

- FOR GENERAL NOTES, SEE SHT. GN1.
- HOLES IN SPLICE PLATES ARE PRE-DRILLED. ENDS OF GIRDERS ARE DRILLED FROM SOLID USING SPLICE PLATES AS A TEMPLATE.
- DOR DENOTES DIRECTION OF MILL ROLLING.

NO.		DATE		REMARKS		BY
REVISIONS						
			<b>CASCO BAY STEEL STRUCTURES</b> ONE WALLACE AVENUE      PHONE: 207-780-6722 SOUTH PORTLAND, ME 04106      FAX: 207-780-6726			
STRUCTURE <u>BENMONT AVE. (TH-7) (URBAN MINOR ARTERIAL)</u>						
LOCATION <u>TOWN OF BENNINGTON, VERMONT</u>						
PROJECT NO. <u>BRIDGE NO. 57 PROJECT NO. BRJ 1000(16)</u>						
ENGINEER <u>STATE OF VERMONT AGENCY OF TRANSPORTATION</u>						
CUSTOMER <u>ALPINE CONSTRUCTION</u>						
ITEM <u>FIELD SPLICE DETAILS</u>						
SURFACE PREP. <u>SEE SHT. GN1</u> OPEN HOLES <u>15/16"</u>						
PAINT <u>NONE</u>						
APPROVAL	DRAWN	GDC	12-5-14	SHEET NO.	JOB NO.	
SHOP	CHECKED	FM	12-30-14	<b>X1</b>	<b>605</b>	