
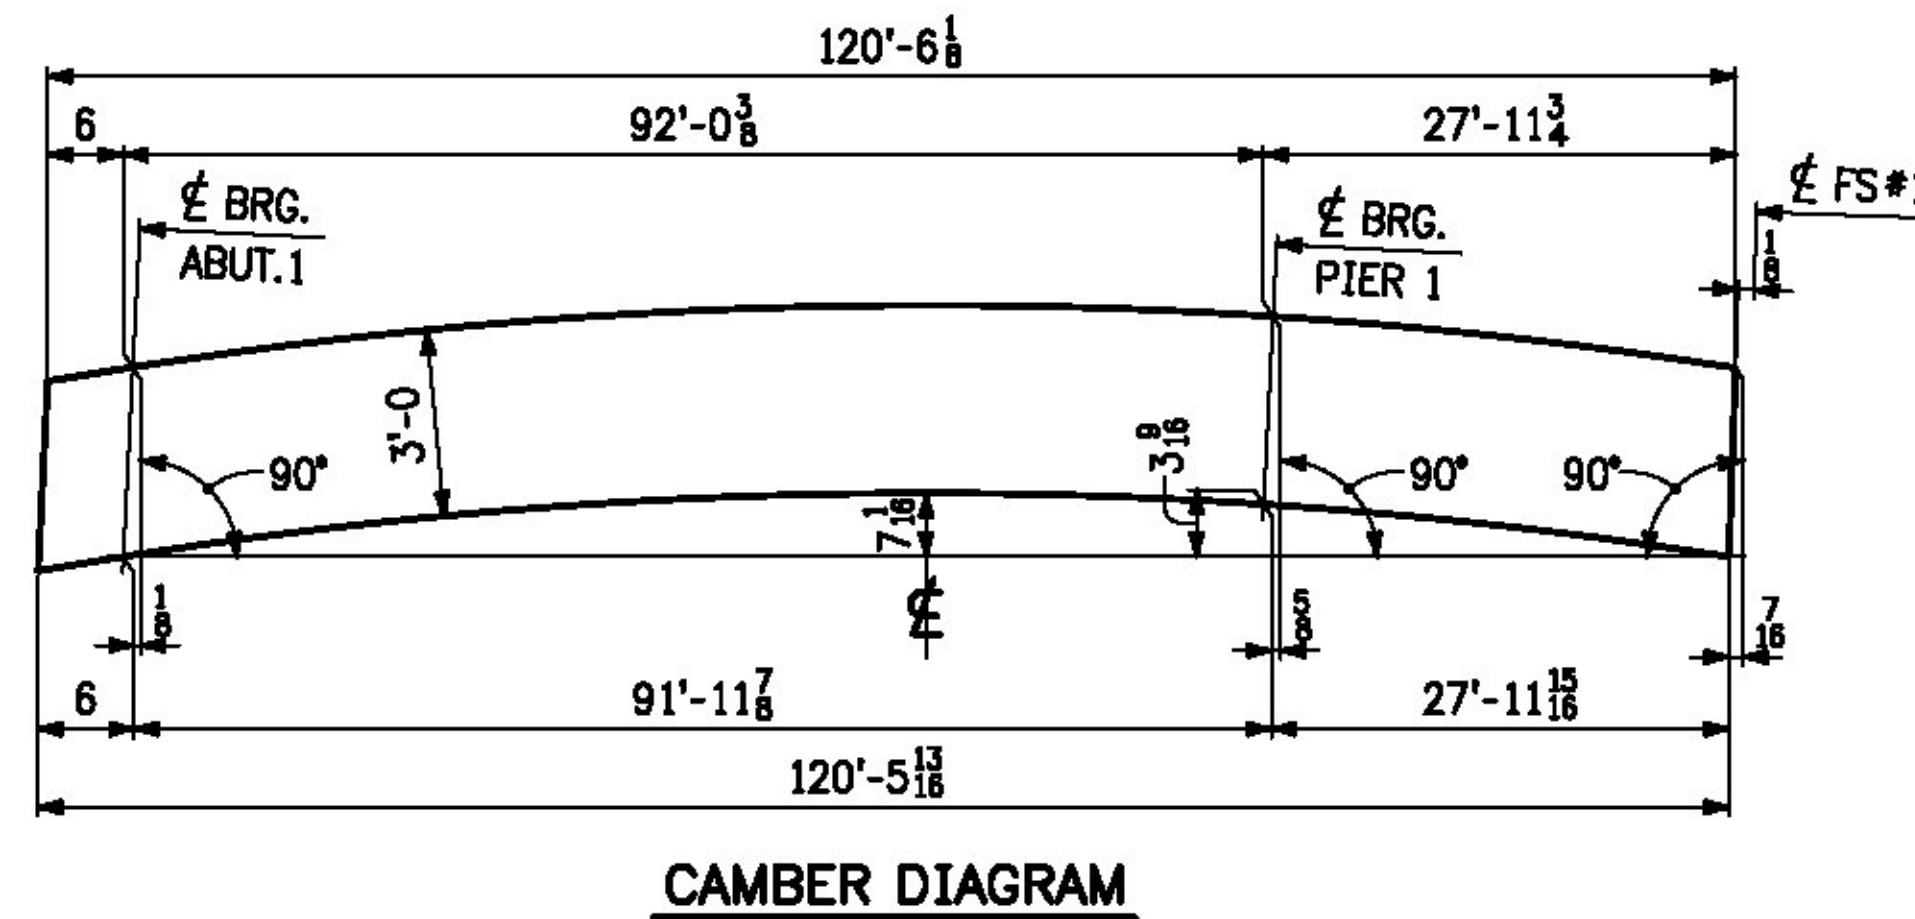


Spacing of waterline support beams are not all at 9'-0" spaces as shown on Contract Drawing Sheet 39 of 75. Maximum variation appears to be 9". The increase in span is acceptable, however the Contractor should refer to the Special Provision (Water Main on Bridge) to ensure compliance with the hanger distance to pipe joint requirements are also met.

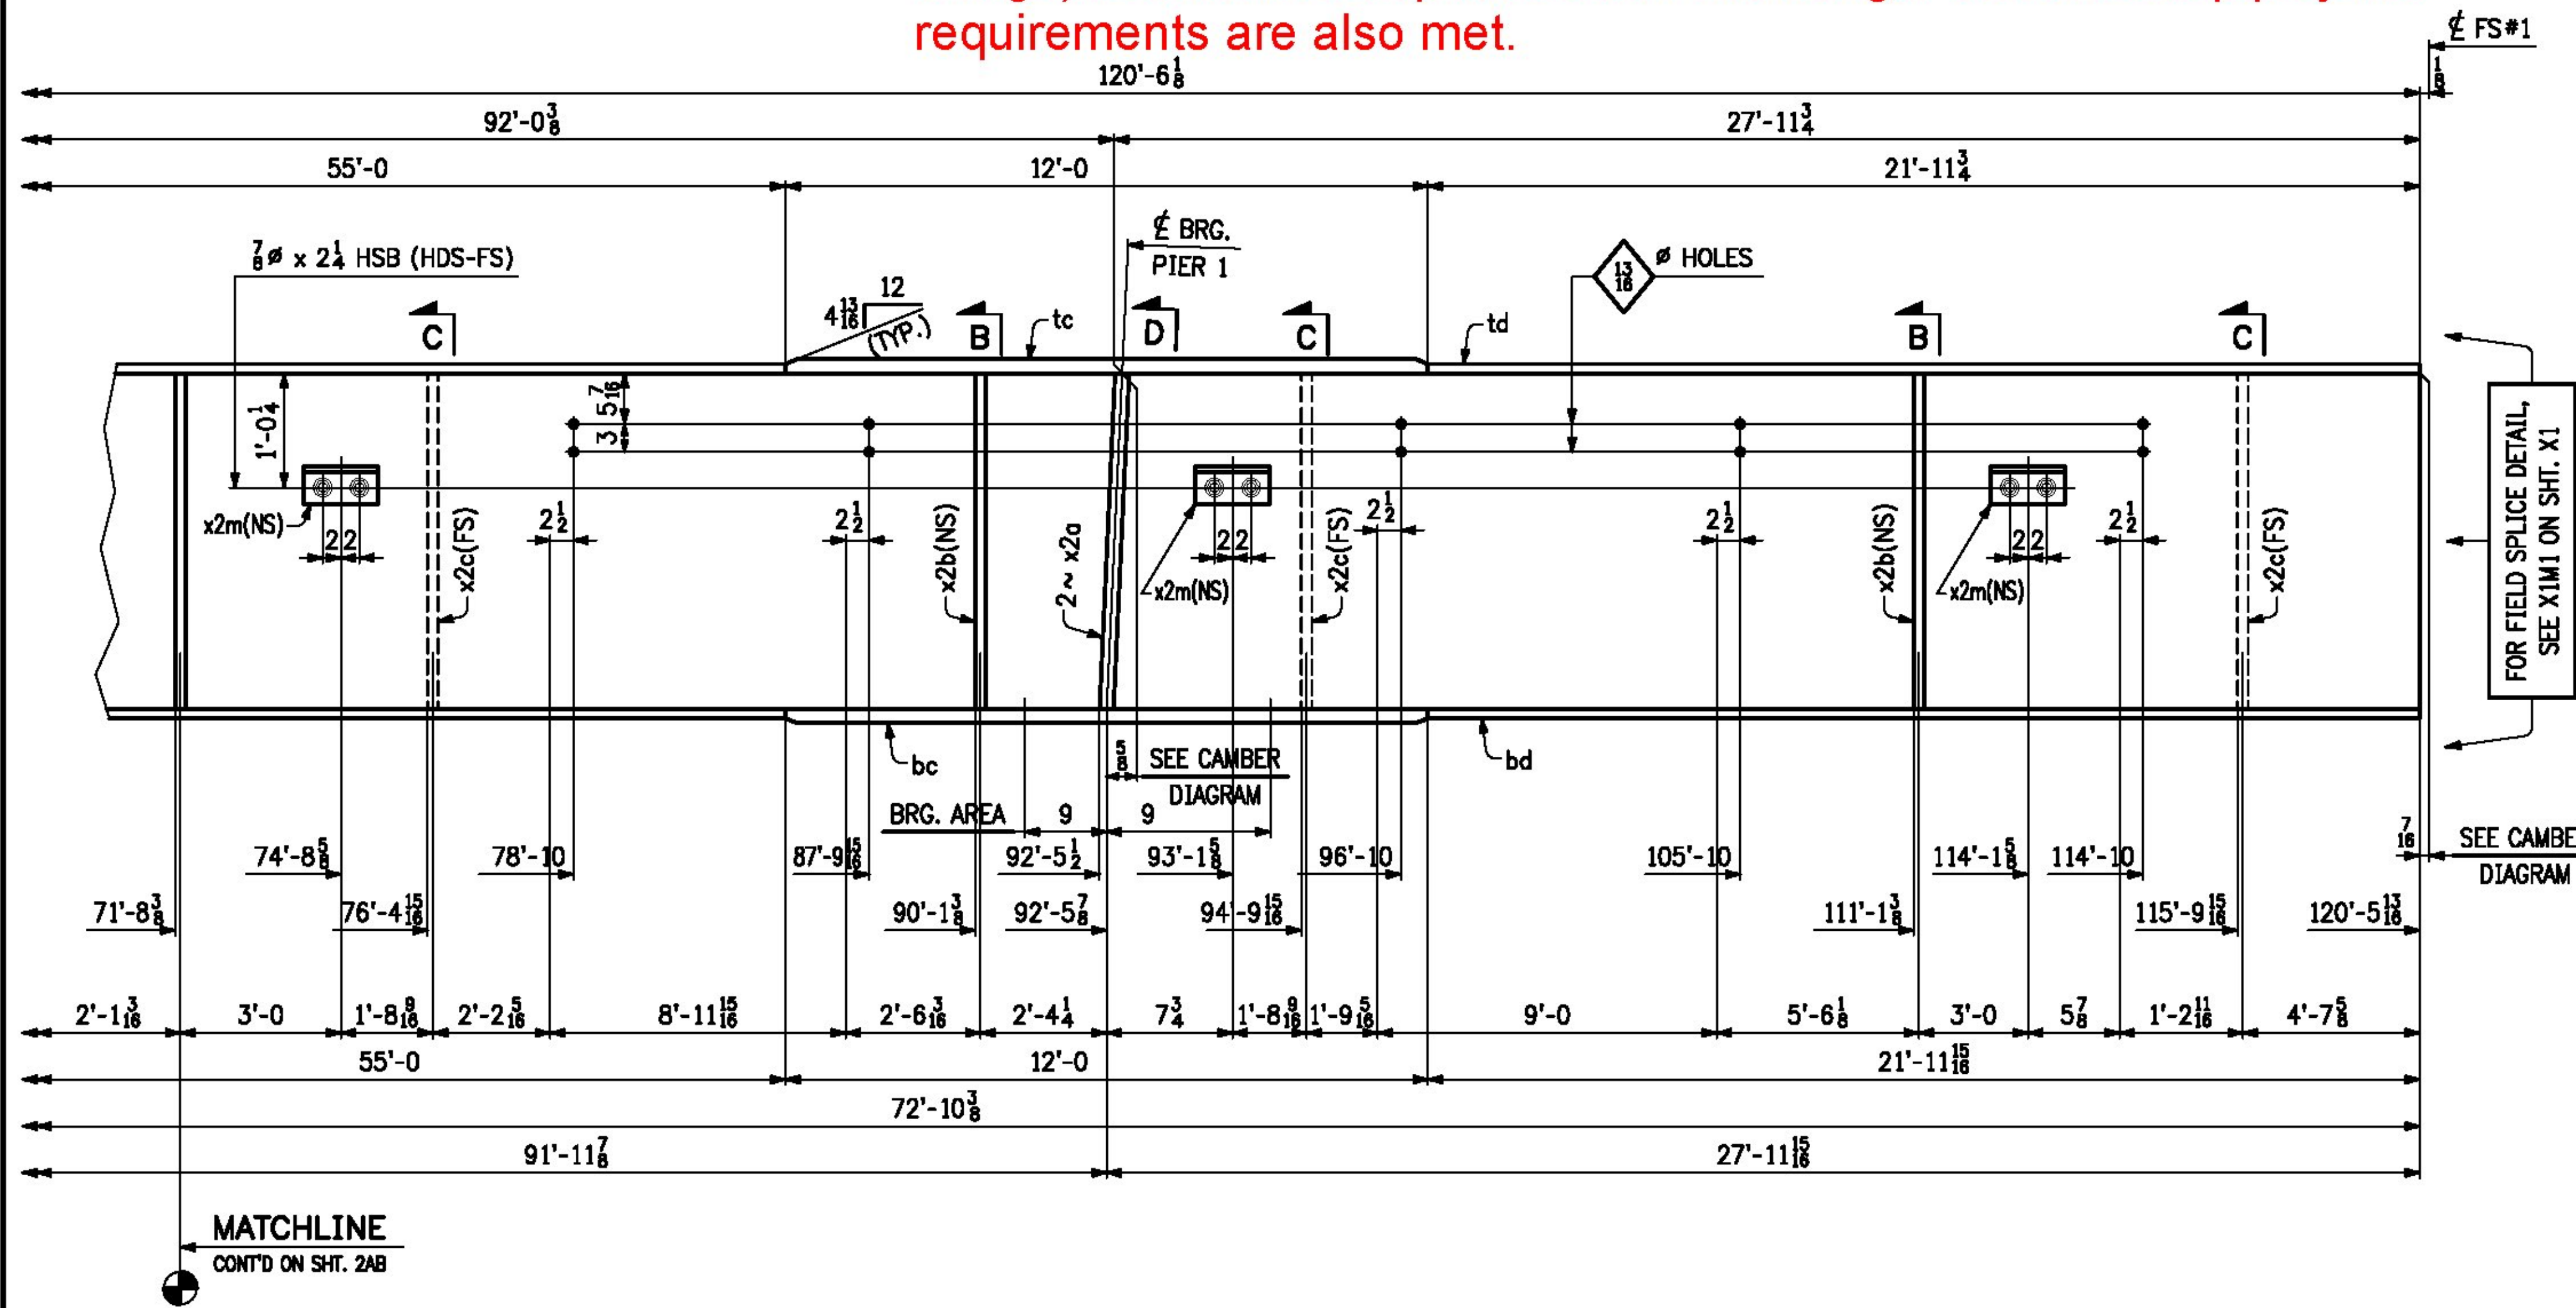

LINE NO.	NO. OF PCS.	SHIP MARK	ASSY MARK	MATERIAL					REMARKS	
				SHAPE	SECTION	LENGTH FT.	IN.	MATERIAL SPEC.		ITEM NO.
1	1	2G2A		GIRDER					23,405 lbs.	
2	1		wa	PL	1/2 x 36	47	7 1/8	M270-50WT2	1/18	2919 lbs.
3	1		wb	PL	1/2 x 36	72	10 1/8	M270-50WT2	2/13	4486 lbs.
4	1		ta	PL	1 x 18	31	6 3/8	M270-50WT2	2/8	1931 lbs.
5	1		tb	PL	1 x 18	55	0	M270-50WT2	2/6	3369 lbs.
6	1		tc	PL	1 1/2 x 18	12	0	M270-50WT2	2/2	1011 lbs.
7	1		td	PL	1 x 18	21	11 3/4	M270-50WT2	2/9	1346 lbs.
8	1		ba	PL	1 x 18	31	5 1/8	M270-50WT2	2/7	1929 lbs.
9	1		bb	PL	1 x 18	55	0	M270-50WT2	2/6	3369 lbs.
10	1		bc	PL	1 1/2 x 18	12	0	M270-50WT2	2/4	919 lbs.
11	1		bd	PL	1 x 18	21	11 3/8	M270-50WT2	2/9	1347 lbs.
12										
13	4		x2a	PL	3/4 x 8 1/2	3	0	M270-50W	3/10	G1E 280 lbs.
14	7		x2b	PL	1/2 x 7	3	0	M270-50W	3/11	250 lbs.
15	7		x2c	PL	1/2 x 7	3	0	M270-50W	3/11	250 lbs.
16	6		x2m	L	4 x 4 x 3/8	0	8	M270-50W	3/15	39 lbs.
17										
18	12				7/8\" HSB	0	2 1/2	M164 TYPE 3	6/2	
19	12				7/8\" WASHER			M293-3	6/6	
20										
21										
22										
23										
24										
25										

### T.Y. LIN INTERNATIONAL

THE STAMPED DOCUMENTS ARE HEREBY:

- APPROVED
- APPROVED AS NOTED
- REVISE AND RESUBMIT

SEE TRANSMITTAL FOR ADDITIONAL INFORMATION AS APPLICABLE.

THIS REVIEW IS FOR GENERAL CONFORMANCE WITH DESIGN CONCEPT ONLY. ANY DEVIATION FROM THE PLANS OR SPECIFICATIONS NOT CLEARLY NOTED BY THE CONTRACTOR HAS NOT BEEN REVIEWED. REVIEW BY THE ENGINEER SHALL NOT RELIEVE THE CONTRACTOR OF THE CONTRACTUAL RESPONSIBILITY FOR ANY ERRORS OR DEVIATION FROM THE CONTRACT REQUIREMENTS.

RICK HEBERT  
REVIEWER

2/2/2015  
DATE

NO.	DATE	REVISIONS	BY
<div style="display: flex; justify-content: space-between;"> <div style="text-align: center;"> <p><b>CASCO BAY STEEL STRUCTURES</b> ONE WALLACE AVENUE SOUTH PORTLAND, ME 04106 PHONE: 207-780-8722 FAX: 207-780-8726</p> </div> <div> <p>STRUCTURE <u>BENMONT AVE. (TH-7) (URBAN MINOR ARTERIAL)</u></p> <p>LOCATION <u>TOWN OF BENNINGTON, VERMONT</u></p> <p>PROJECT NO. <u>BRIDGE NO. 57 PROJECT NO. BRF 1000(16)</u></p> <p>ENGINEER <u>STATE OF VERMONT AGENCY OF TRANSPORTATION</u></p> <p>CUSTOMER <u>ALPINE CONSTRUCTION</u></p> <p>ITEM <u>GIRDER ~ 2G2A</u></p> <p>SURFACE PREP. <u>SSPC-SP10</u> OPEN HOLES <u>1 1/8\" (UN)</u></p> <p>PAINT <u>NONE</u></p> </div> </div>			
APPROVAL	DRAWN	GDC	12-8-14
SHOP	CHECKED	PH	1-3-15
SHEET NO. <b>2B</b>		JOB NO. <b>605</b>	