


B.I.N. 57  
 TYPICAL RAILING ELEVATION  
 LOOKING AT FACE OF RAIL FROM CENTERLINE OF ROAD

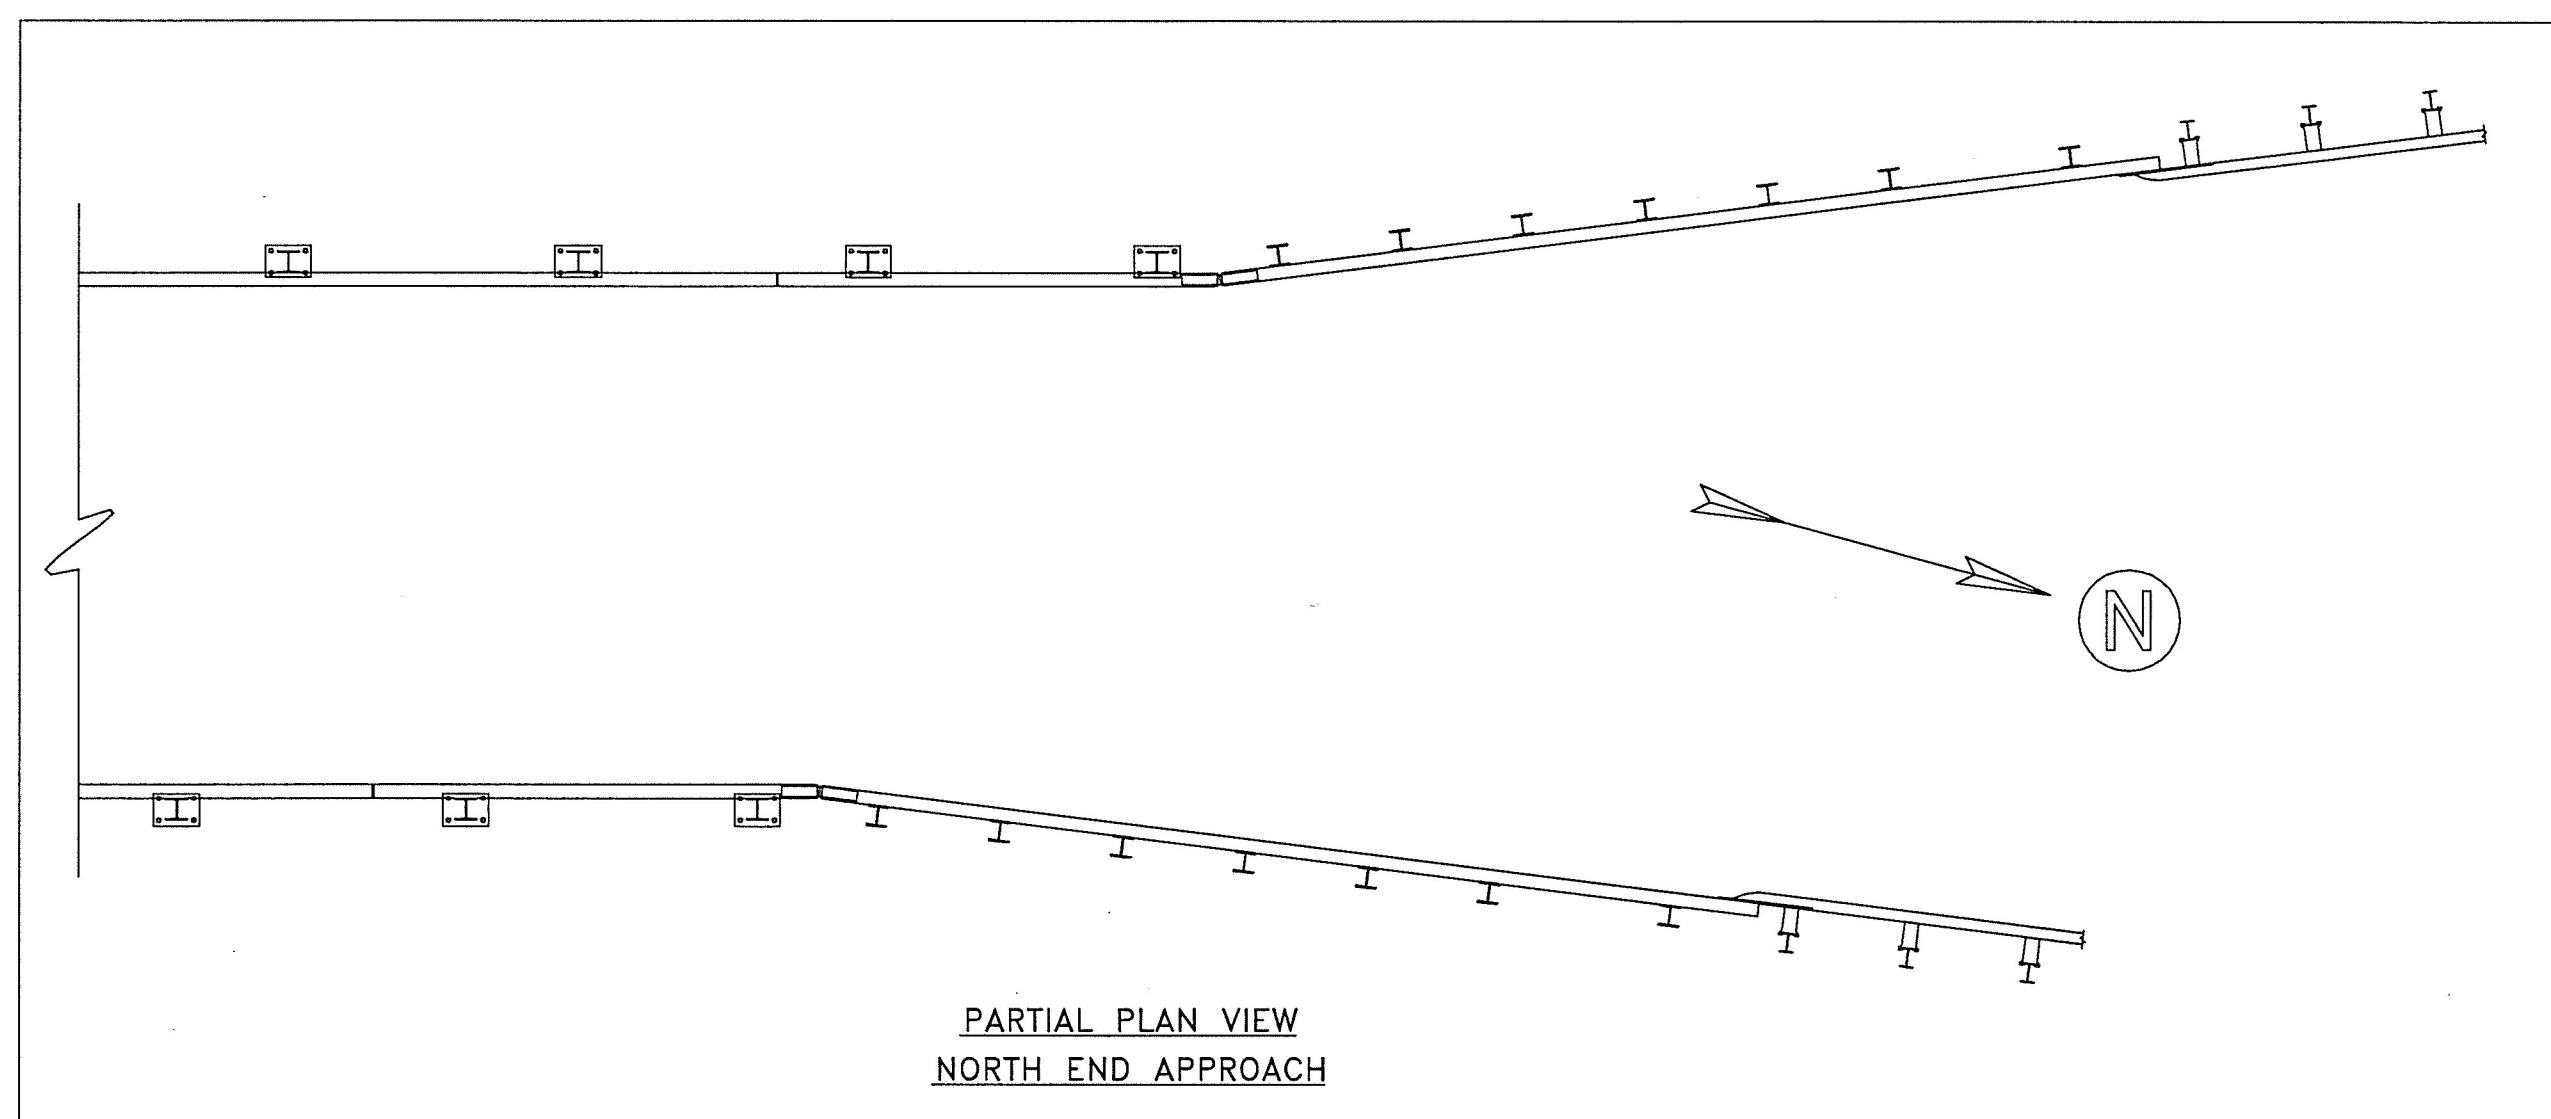

**T.Y. LIN INTERNATIONAL**

THE STAMPED DOCUMENTS ARE HEREBY:

APPROVED  
 APPROVED AS NOTED  
 REVISE AND RESUBMIT

SEE TRANSMITTAL FOR ADDITIONAL INFORMATION AS APPLICABLE.

THIS REVIEW IS FOR GENERAL CONFORMANCE WITH DESIGN CONCEPT ONLY. ANY DEVIATION FROM THE PLANS OR SPECIFICATIONS NOT CLEARLY NOTED BY THE CONTRACTOR HAS NOT BEEN REVIEWED. REVIEW BY THE ENGINEER SHALL NOT RELIEVE THE CONTRACTOR OF THE CONTRACTUAL RESPONSIBILITY FOR ANY ERRORS OR DEVIATION FROM THE CONTRACT REQUIREMENTS.

RICK HEBERT  
 REVIEWER

3/30/2015  
 DATE

REVISIONS		
No.	Remarks	Date
RevA	Notation Corrections	3/2/15
0	Initial submittal	3/2/15

**HIGHWAY SAFETY CORP**  
 GLASTONBURY, CT  
 860-633-9445

ITEM 525.34 4-BAR BRIDGE RAIL  
 BRIDGE IMPROVEMENT  
 BENMONT AVE. (TH-7) (URBAN MINOR ARTERIAL)  
 B.I.N. 57 P.I.N. BR 1000 (16)  
 TOWN OF BENNINGTON, BENNINGTON COUNTY

GENERAL CONTRACTOR  
 SUB CONTRACTOR LAFAYETTE

SCALE NONE SIZE D

DATE 2-17-15

DATE 3/2/15

MISC JOB NO. 2026  
 SHEET NO. 1 of 6

CERTIFIED FABRICATOR