


CONSTRUCT 14' FIELD DRIVE
REV. 44+25 LT.

REV. 44+32 RT.
END STONE FILL, TYPE II
REV. 44+28 RT.
END RIPRAP, HEAVY TYPE

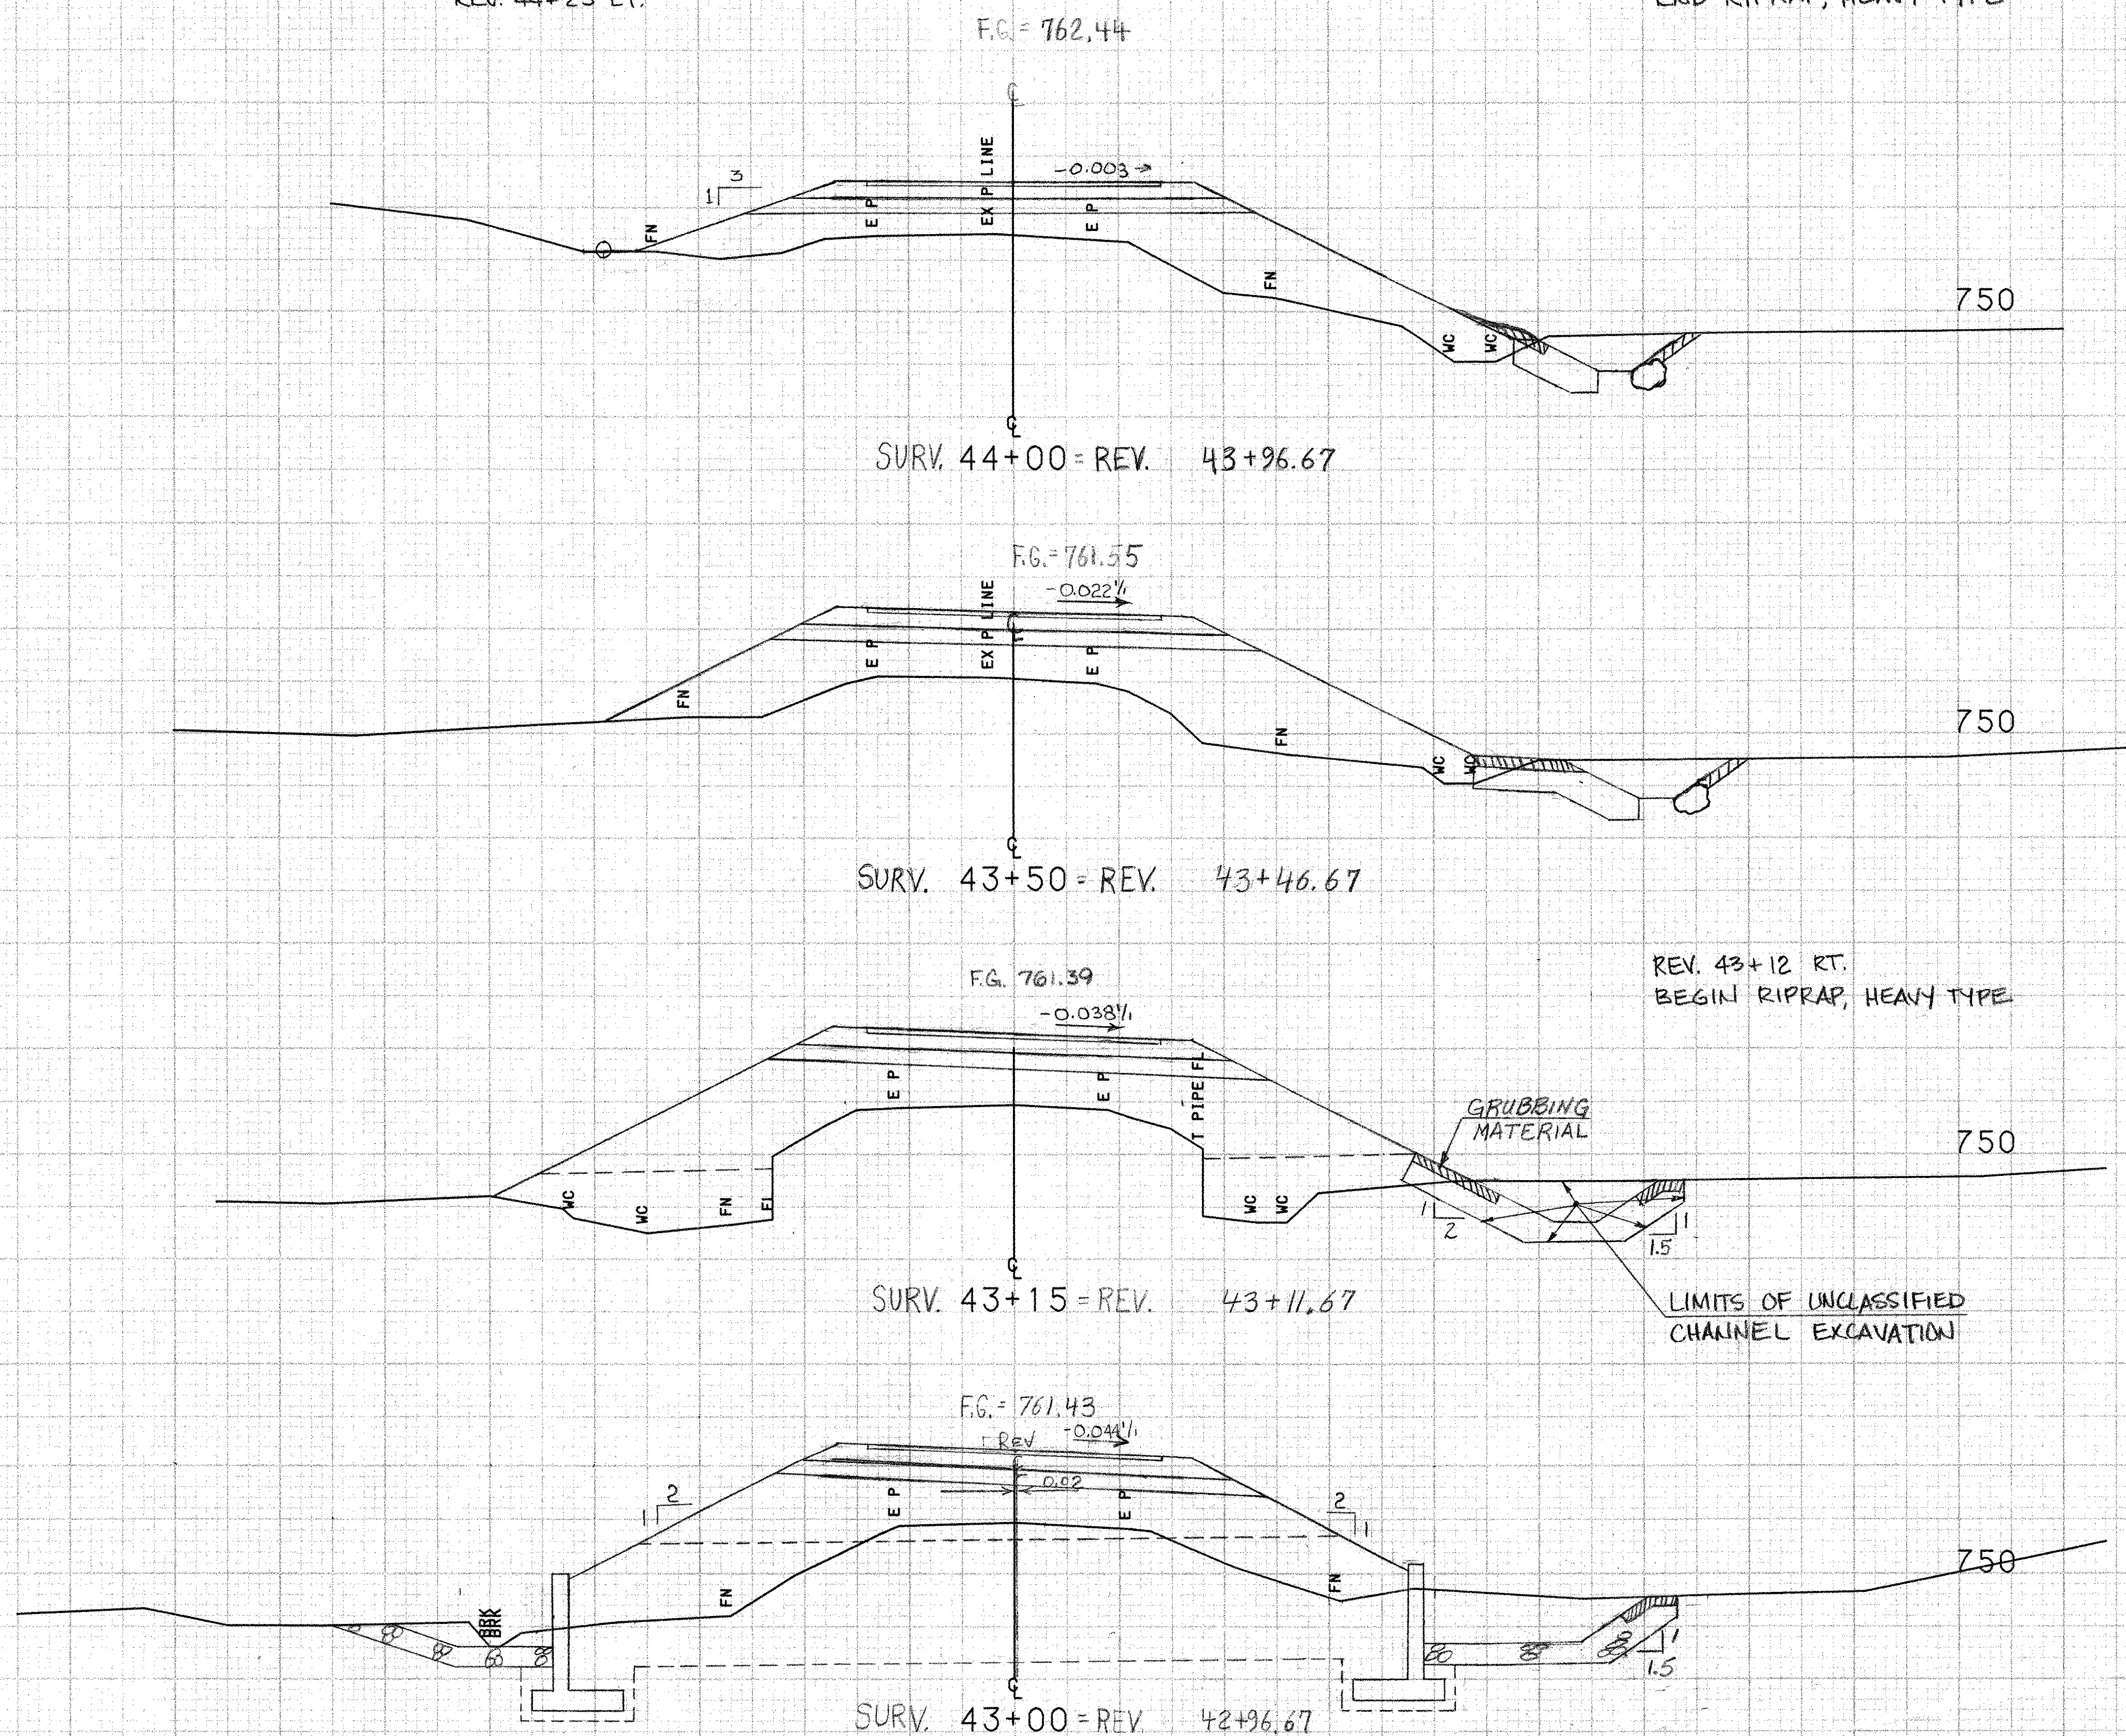

FROM STA.	43+00	TO STA.	44+00
PROJECT NAME	DERBY M1		
NO.	TH28910		PLOTTED 05/16/89
SURVEYED BY	L. NOYES		03/89 0219
SHEET	20	OF	29 SHEETS

SCALE 10 FEET