
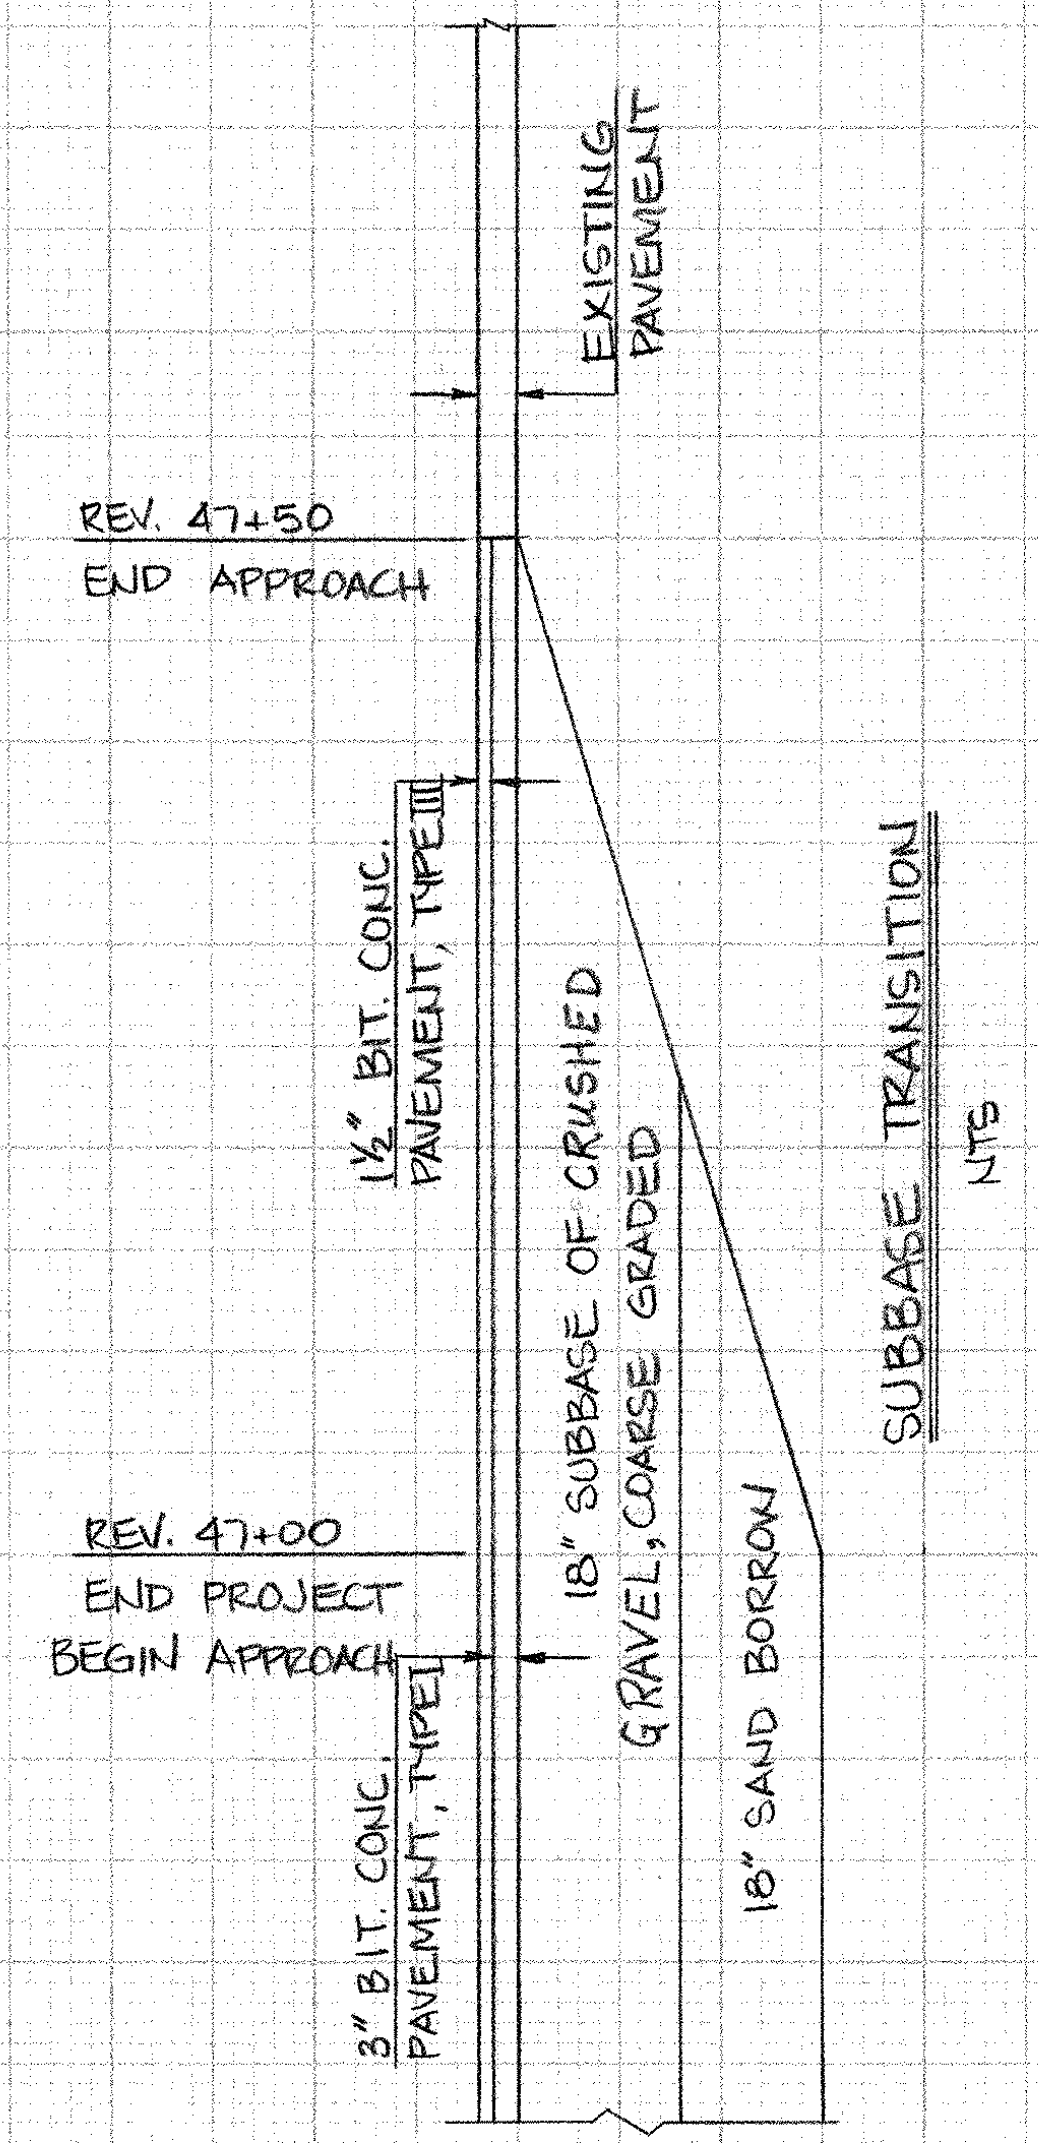


REV. 46+94 LT.  
 END STONE FILL, TYPE II  
 END GRUBBING MATERIAL

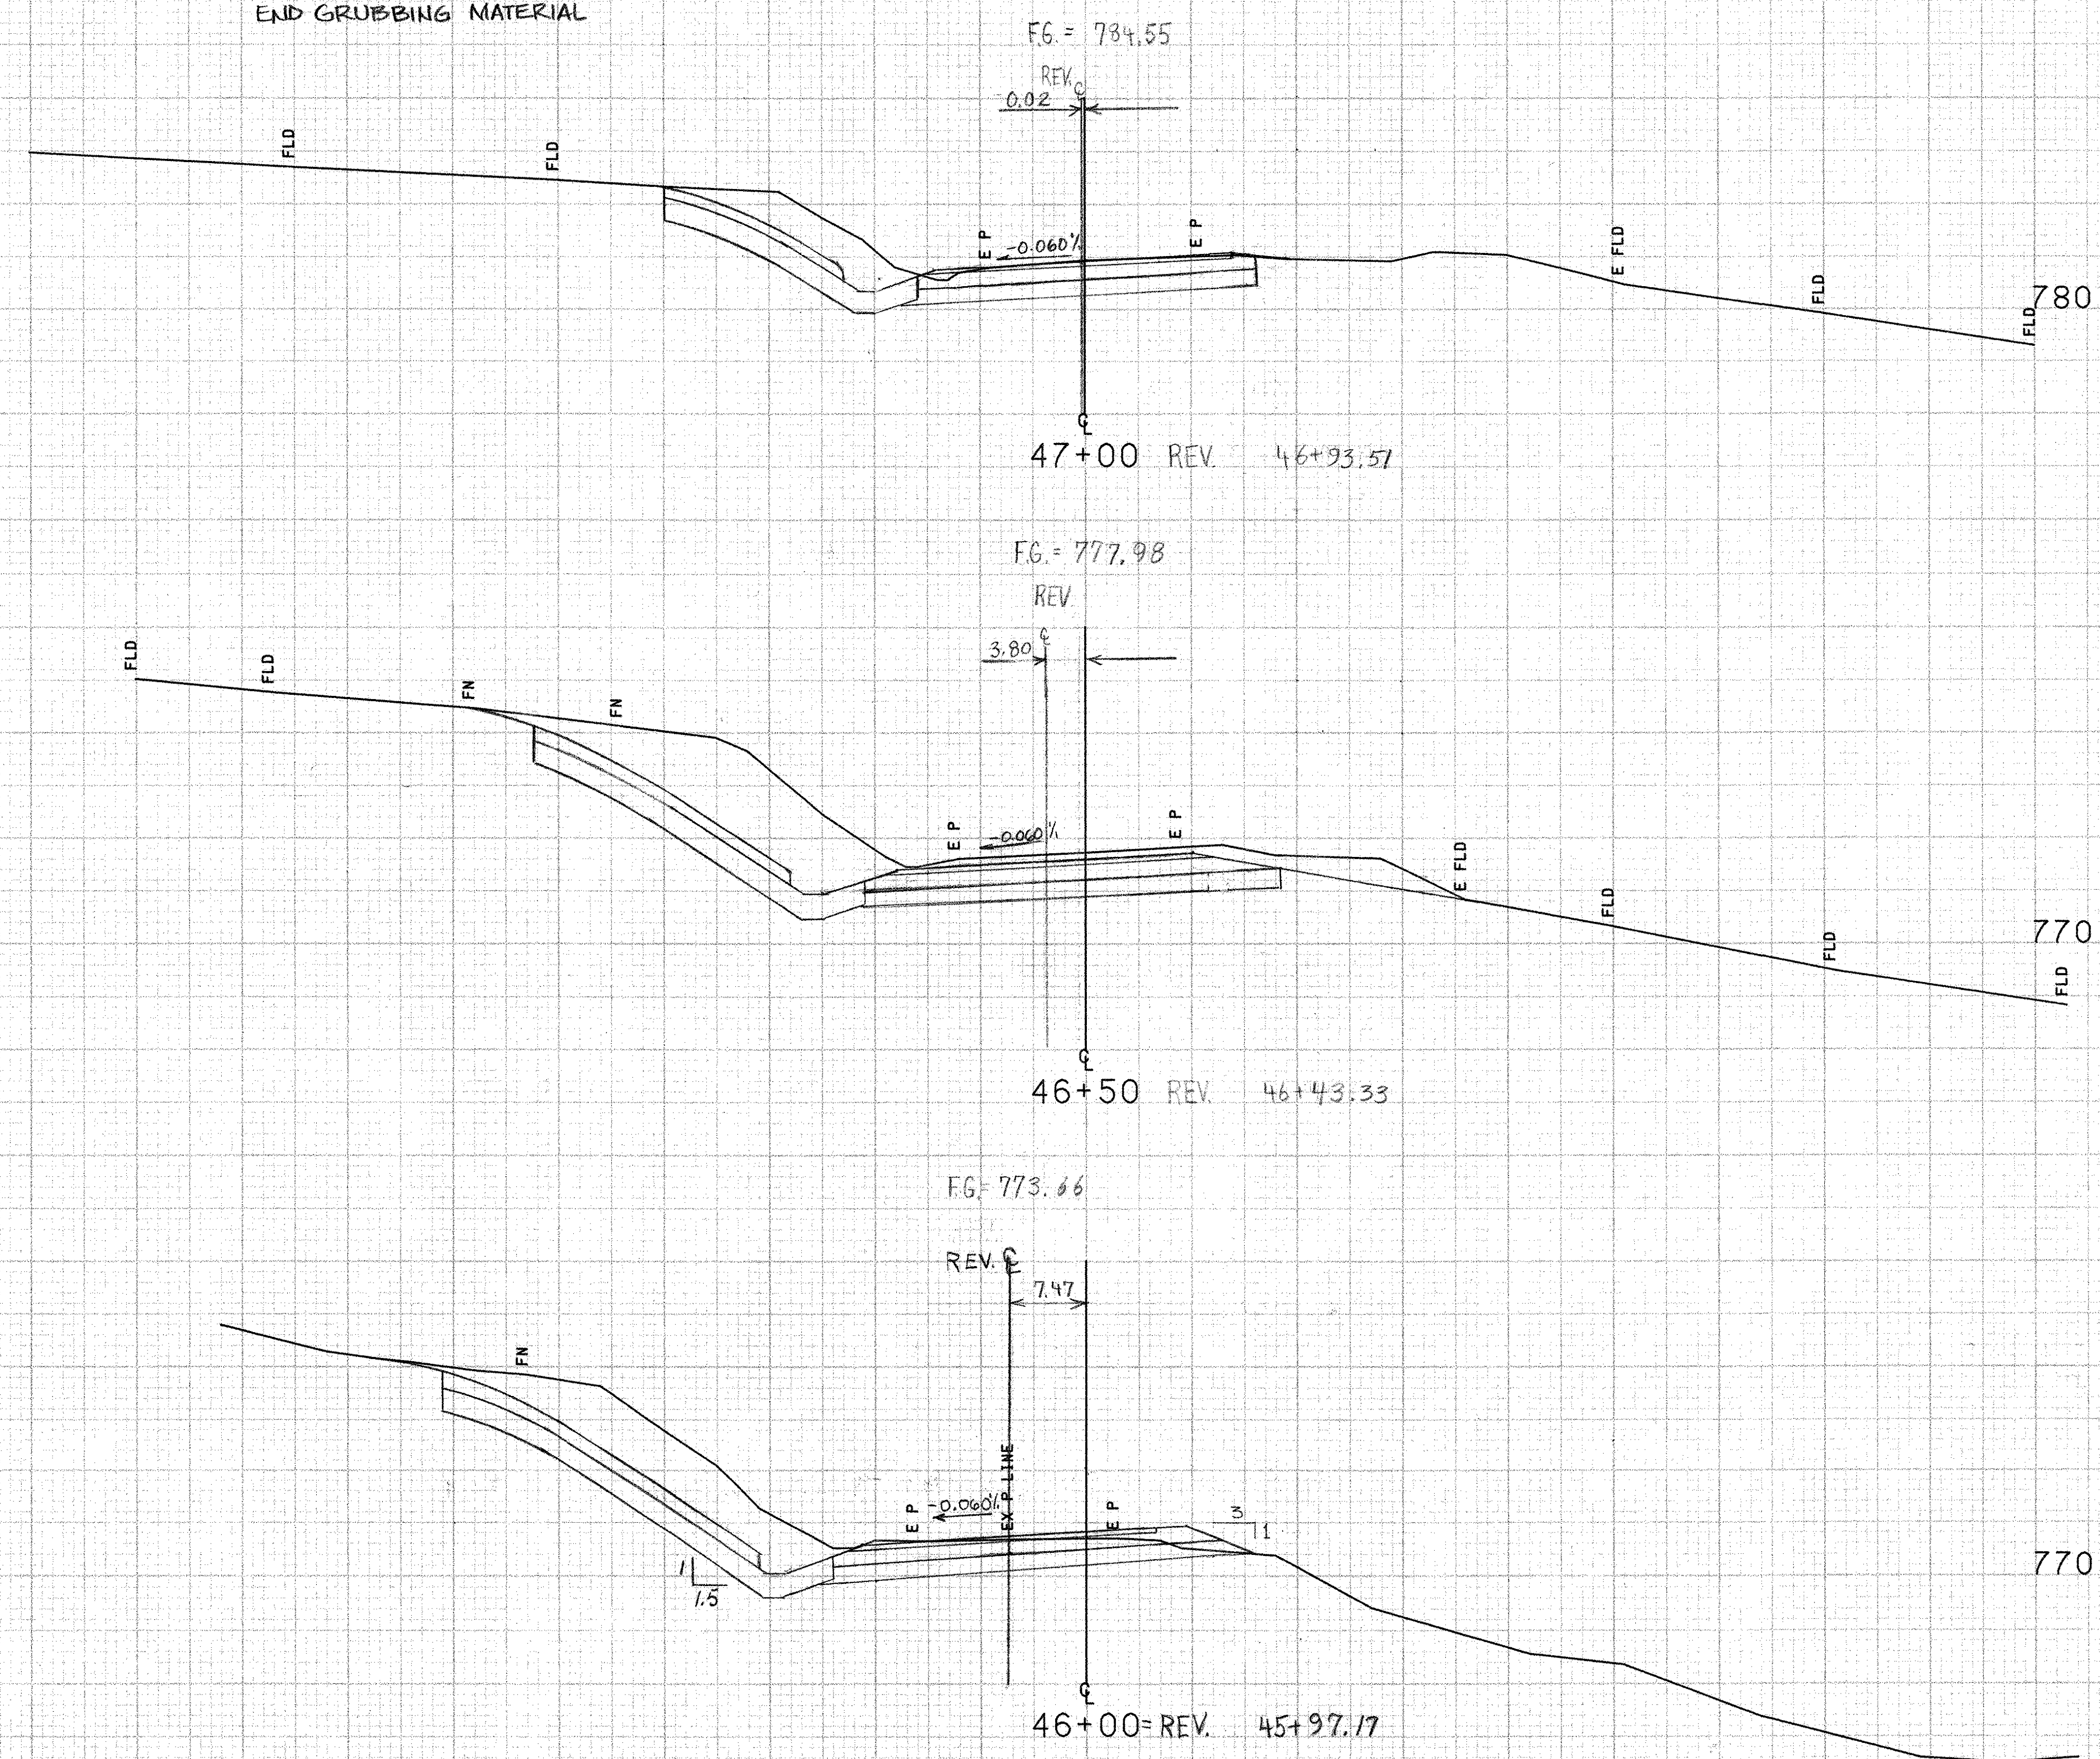

FROM STA.	46+00	TO STA.	47+00
PROJECT NAME	DERBY M1		
NO.	TH28910		PLOTTED 05/16/89
SURVEYED BY	L. NOYES		03/89 0219
SHEET	22	OF 29	SHEETS

SCALE 1" = 10 FEET