


499+50

740


STA 499+21 BEGIN STRUCTURE EXCAVATION
 BEGIN GRANULAR BORROW
 BEGIN GRANULAR BACKFILL FOR STRUCTURES

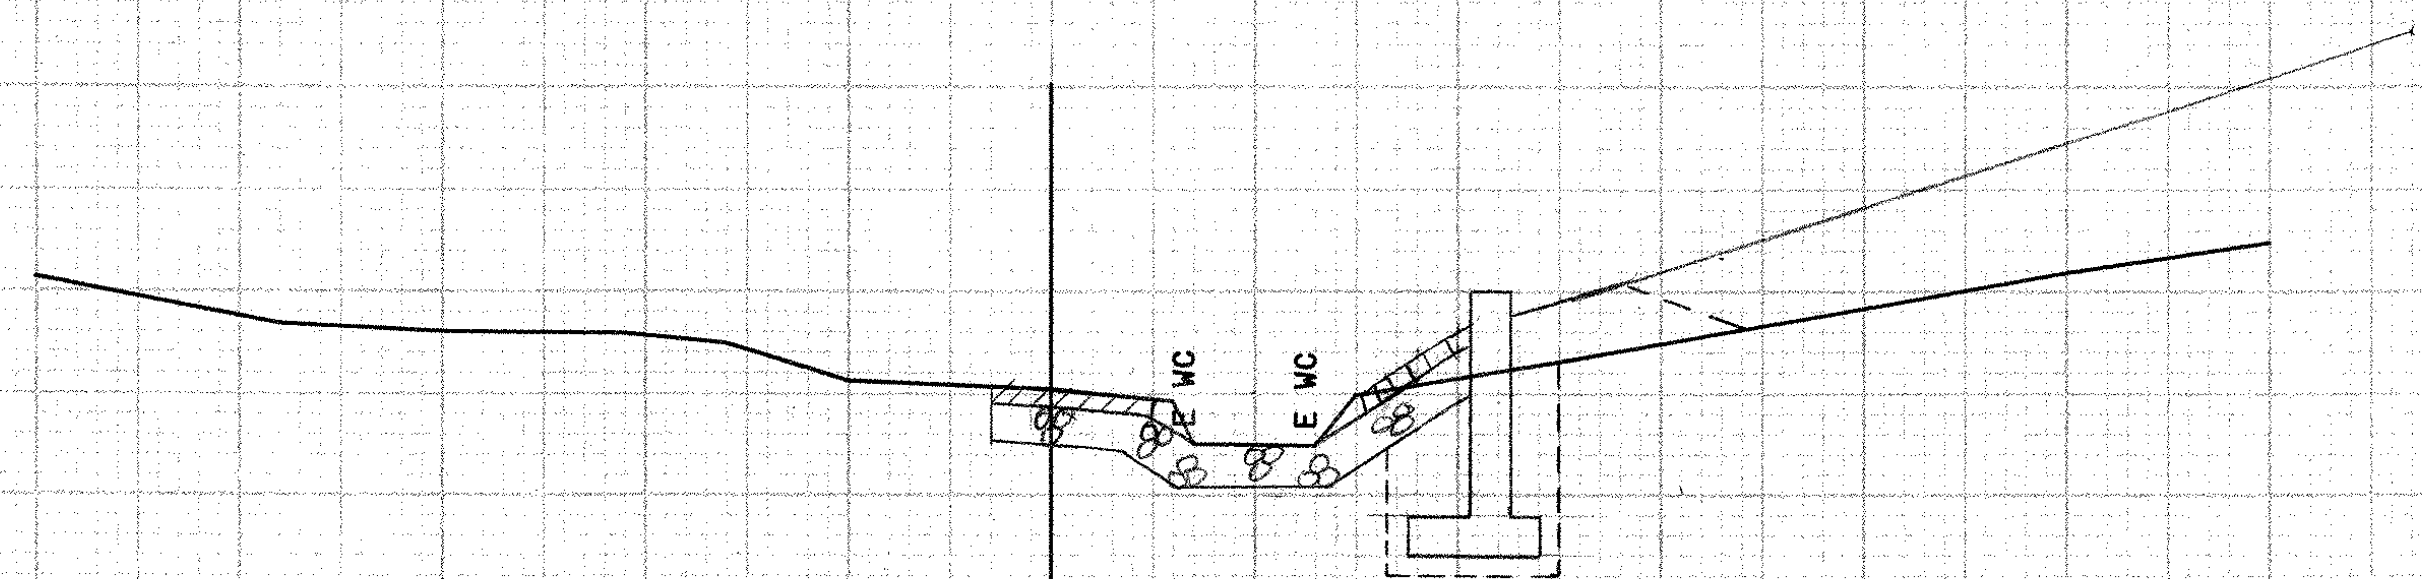

499+25


740

STA 499+14 BEGIN STONE FILL, TYPE II
 BEGIN UNCLASSIFIED CHANNEL EXCAVATION
 BEGIN GEOTEXTILE UNDER STONE FILL
 BEGIN GRUBBING MATERIAL

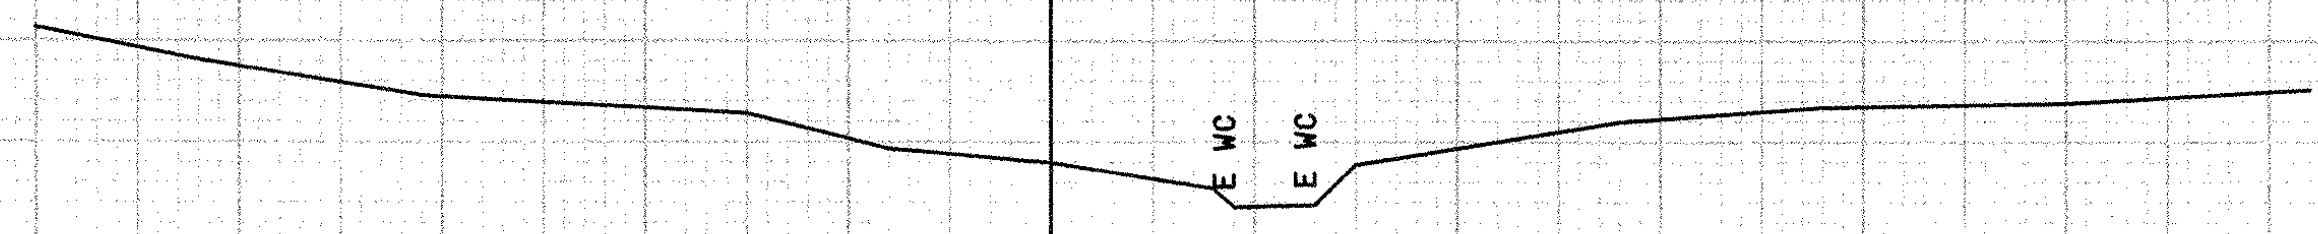

499+00

740

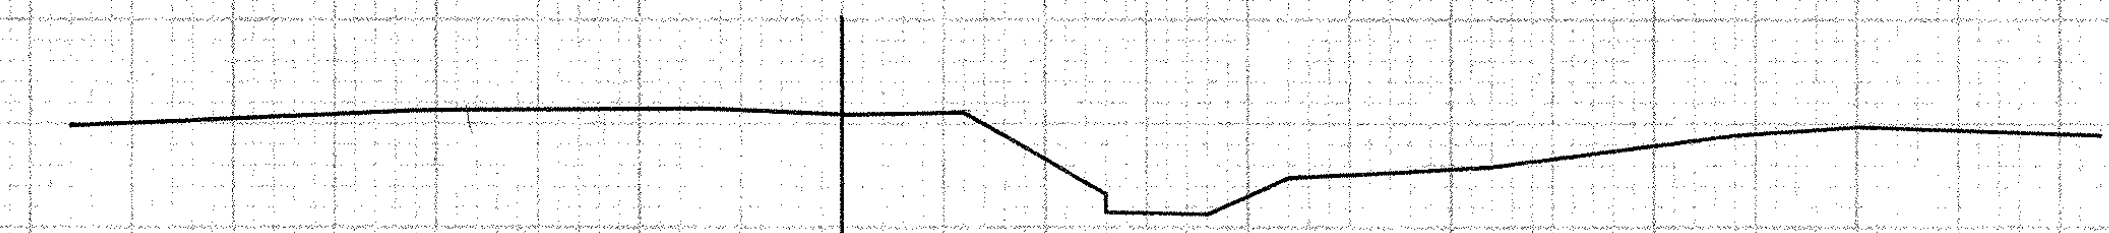

498+75

740

FROM STA.	498+75	TO STA.	499+50
PROJECT NAME	DERBY CHAN		
NO.	TH28910	PLOTTED	05/16/89
SURVEYED BY	L. NOYES		03/89 0219
SHEET	25	OF	29 SHEETS

SCALE 1" = 10 FEET