



500+30

740

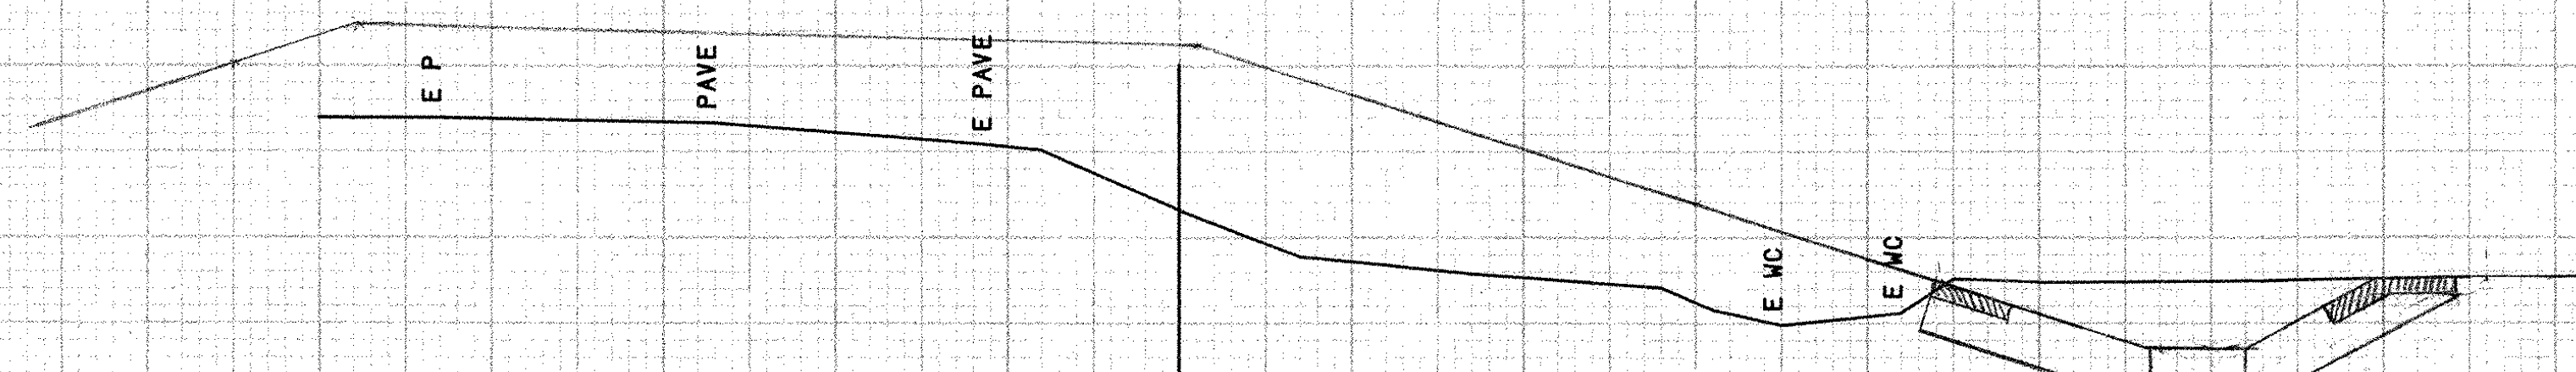


500+20

750

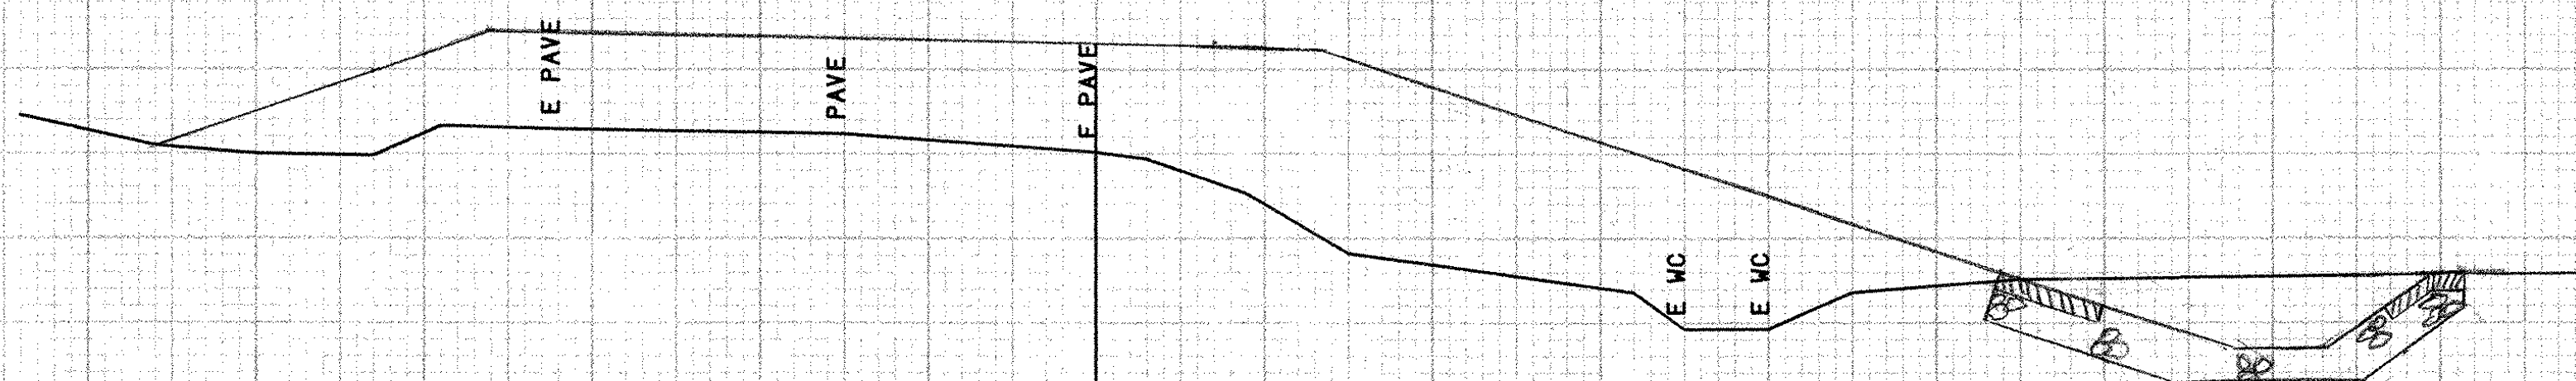

500+10

750

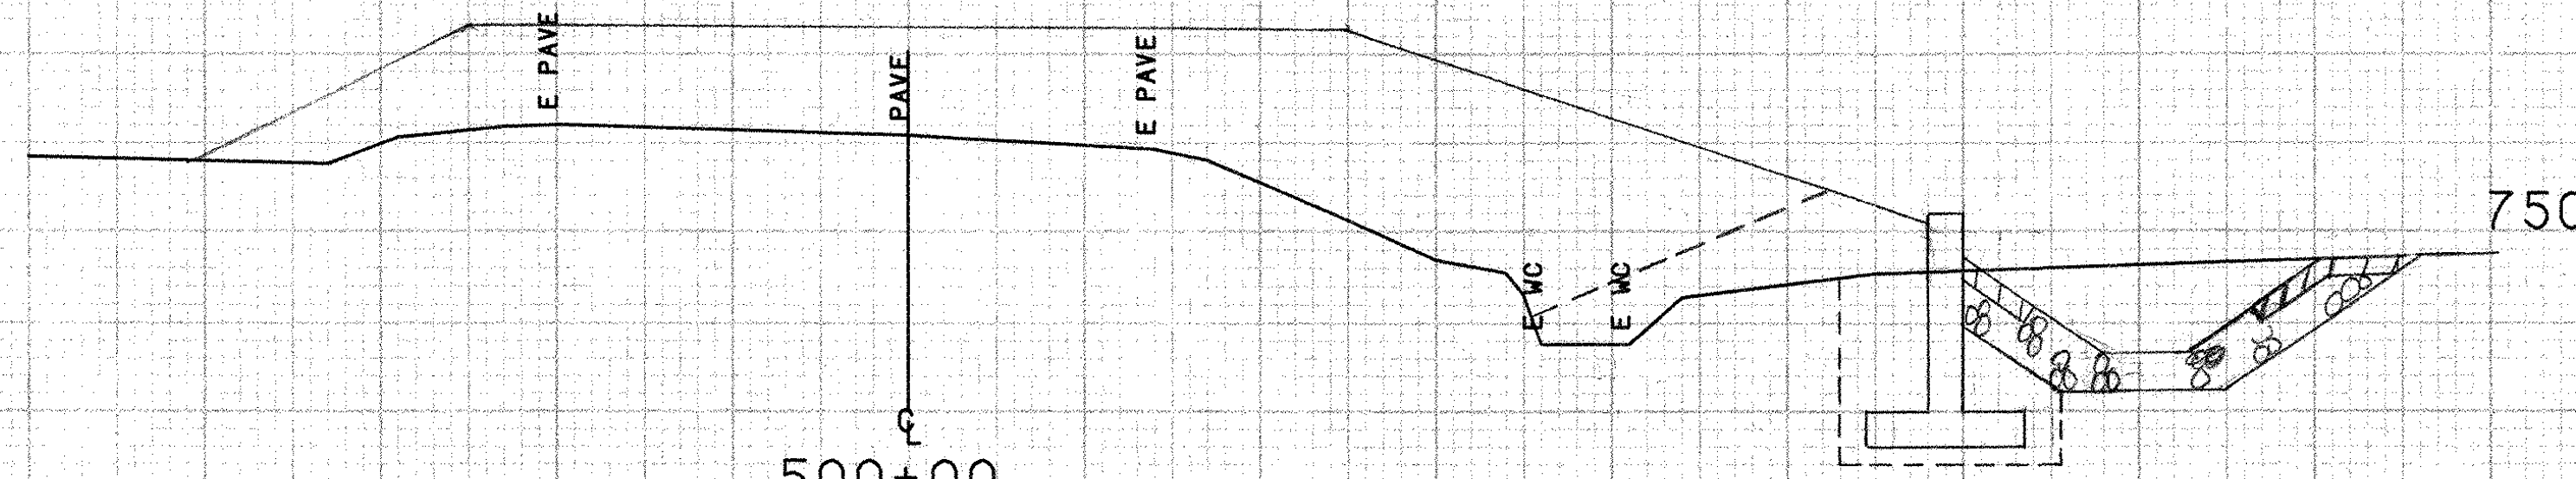

500+00

750

STA. 500+06 END STRUCTURE EXCAVATION
 END GRANULAR BACKFILL FOR STRUCTURES
 END GRANULAR BORROW

FROM STA.	500+00	TO STA.	500+30
PROJECT NAME	DERBY CHAN		
NO.	TH38910		
SURVEYED BY	L. NOYES		
SHEET	27	OF	29 SHEETS

SCALE 1" = 10 FEET

PLOTTED 05/16/89
03/89 0219