


740

501+50

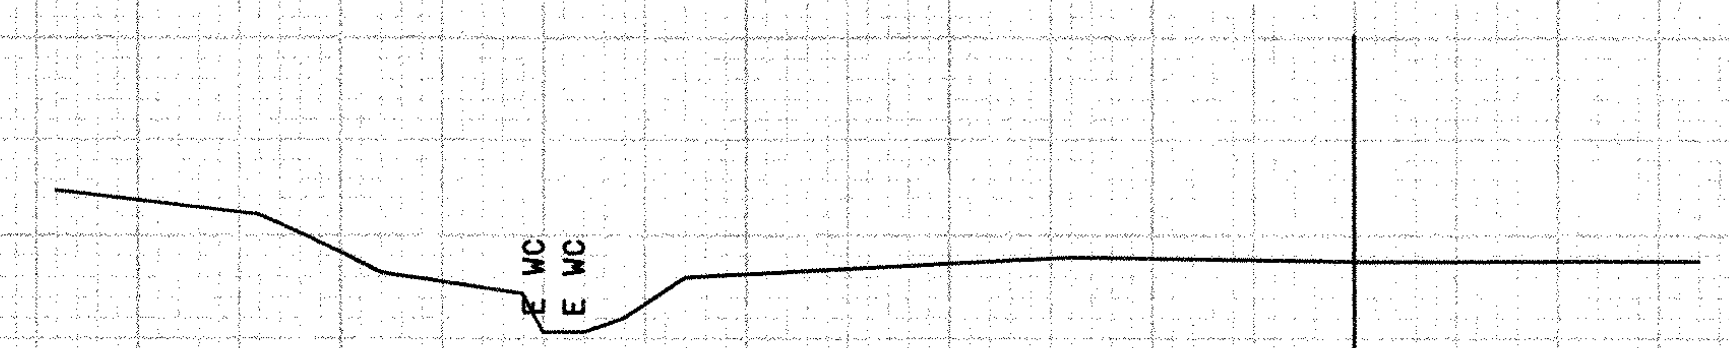

740

501+25

SCALE 10 FEET

FROM STA.	501+25	TO STA.	501+50
PROJECT NAME	DERBY CHAN		
NO.	TH28910		PLOTTED 05/16/89
SURVEYED BY	L. NOYES		03/89 0219
SHEET	29	OF 29	SHEETS