


PLAN
SCALE: 3/8" = 1'-0"

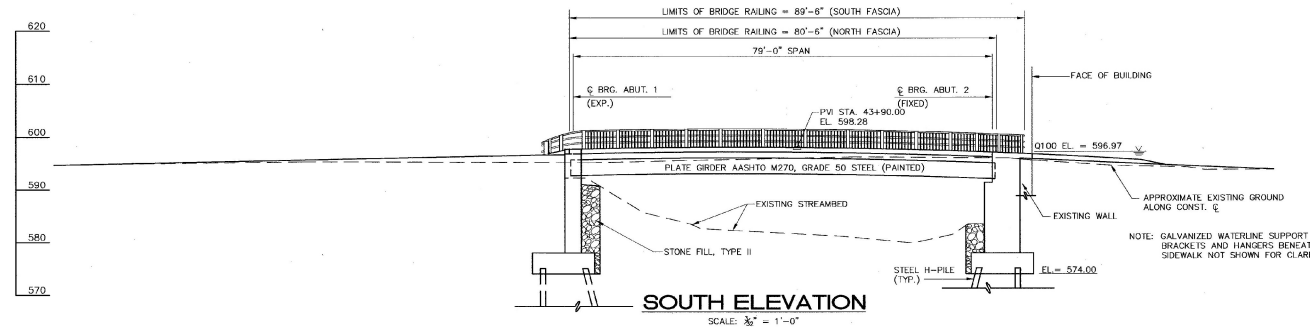

SOUTH ELEVATION
SCALE: 3/8" = 1'-0"

BRIDGE VERTICAL CURVE DATA	
PV STA.	43+90.00
EL.	596.36
PVI STA.	43+90.00
EL.	598.28
PV STA.	44+50.00
EL.	595.28
LENGTH	= 120' VC
K	= 15
E	= -1.23
GRADE IN	= 3.2000%
GRADE OUT	= -5.0000%

* DISTANCE FROM END OF BRIDGE TO
 ☉ OF END POST = 3'-0"

**STATE OF VERMONT
 AGENCY OF TRANSPORTATION**

CITY OF	BARRE	BRIDGE NO.	B-10
STREET NAME	BLACKWELL STREET	LOG STA.	
BLACKWELL STREET BRIDGE OVER STEVENS BRANCH			
PLAN and ELEVATION			
DESIGNED BY	L. Keefe	DRAWN BY	S. Belanger
CHECKED BY	J. Patusky	DATE	12/98
BRIDGE DESIGN SUPERVISOR		DATE 12/98	
PROJECT NO.		PROJECT NO.	
BARRE CITY		BRM 6000(13)	
B&C DRAWING NO.	9203B801	DATE	12/98
BRIDGE SHEET NO.	BR102	SHEET	15 OF 46

BETTIGOLE ANDREWS & CLARK, INC.
 Consulting Engineers

V:\00000000\00000000\00000000.dwg P1 FILE 12.06.02.0955 09:42:47 4.30