
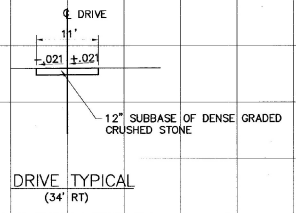
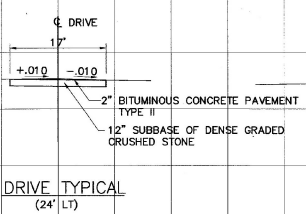


DESIGNED BY	DATE
CHECKED BY	DATE
APPROVED BY	DATE
PROJECT NO.	
SHEET NO.	
ORIGINAL DRAWING	
DATE	
BY	
FOR	
NO.	

DESIGNED BY	DATE
CHECKED BY	DATE
APPROVED BY	DATE
PROJECT NO.	
SHEET NO.	
ORIGINAL DRAWING	
DATE	
BY	
FOR	
NO.	

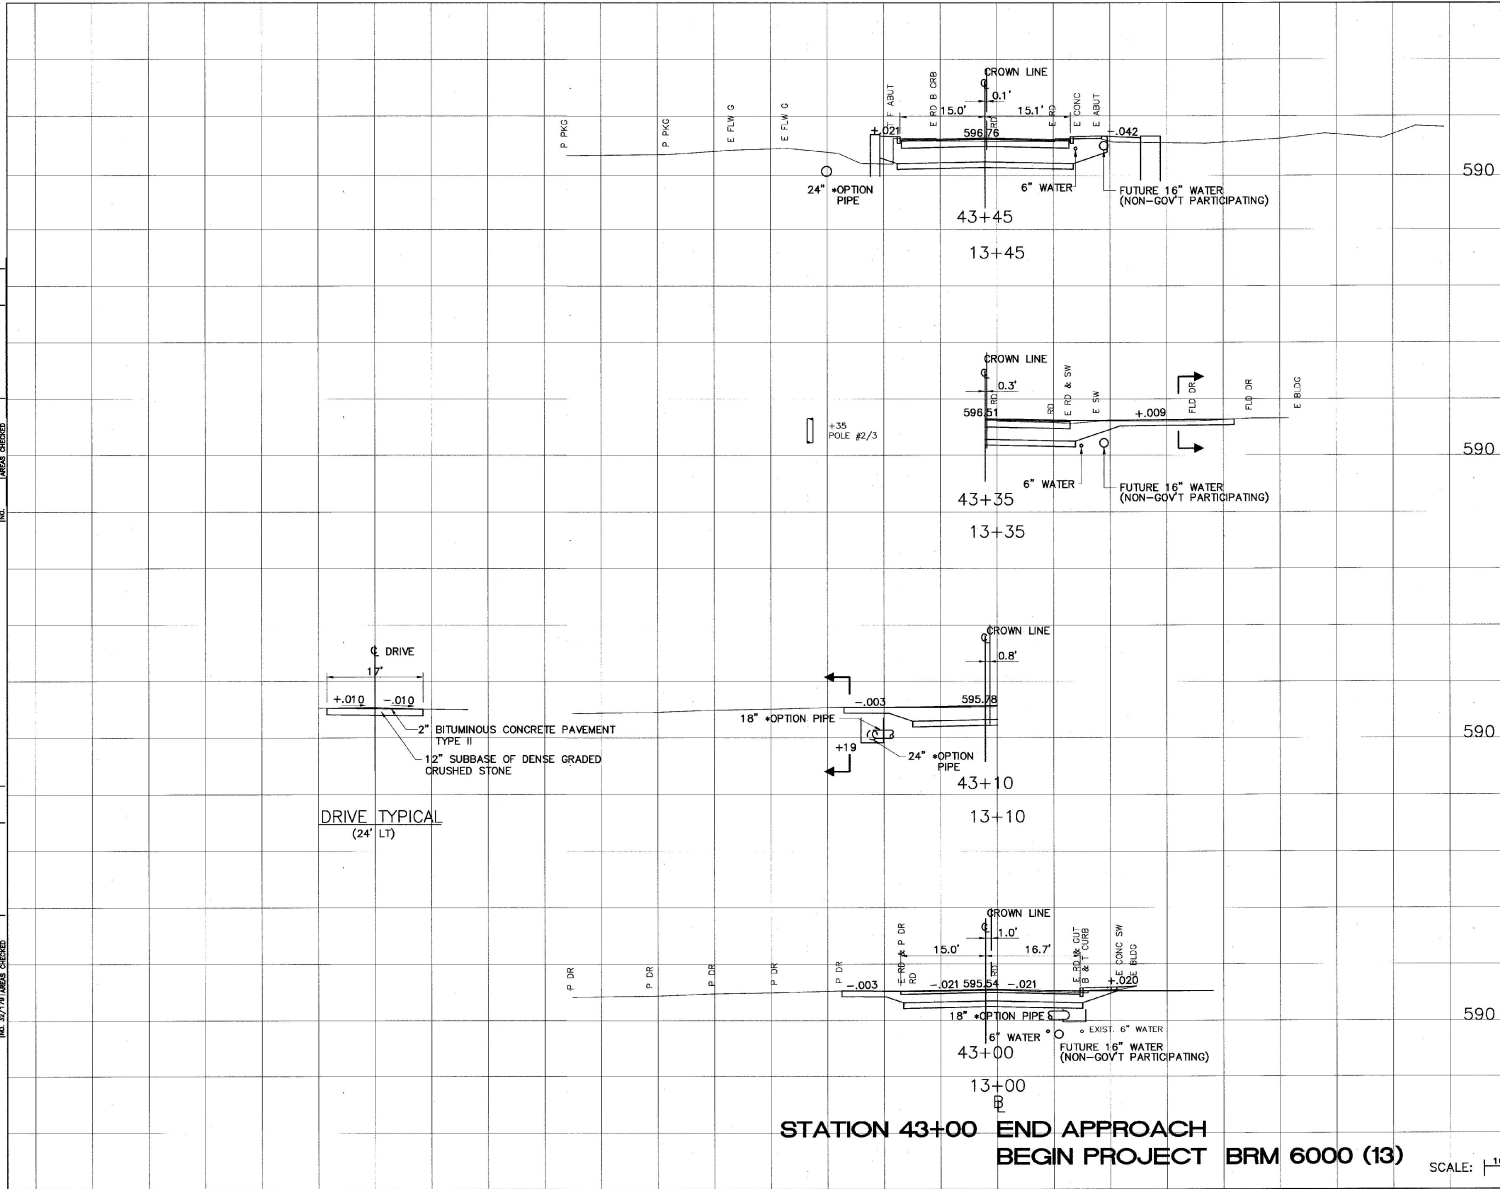

- OPTION PIPES**
- OPEP
  - OPEP (S)
  - RCP CLASS III

**STATION 43+00 END APPROACH  
BEGIN PROJECT BRM 6000 (13)**

SCALE: 10 FEET

**BETTIGOLE ANDREWS & CLARK, INC.**  
Consulting Engineers

FROM STA. 13+00	TO STA. 13+45
PROJECT NAME BARRE CITY MAIN	
NO. BRM 6000(13)	
SURVEYED BY REED	PLOTTED 12/98
SHEET 38 OF 46 SHEETS	B A & C NO. 92038684 (1-10)