


DESIGNED BY	DATE
CHECKED BY	DATE
IN CHARGE BY	DATE
NO.	

DESIGNED BY	DATE
CHECKED BY	DATE
IN CHARGE BY	DATE
NO.	

STATION 44+28 END BRIDGE
RESUME ROADWAY

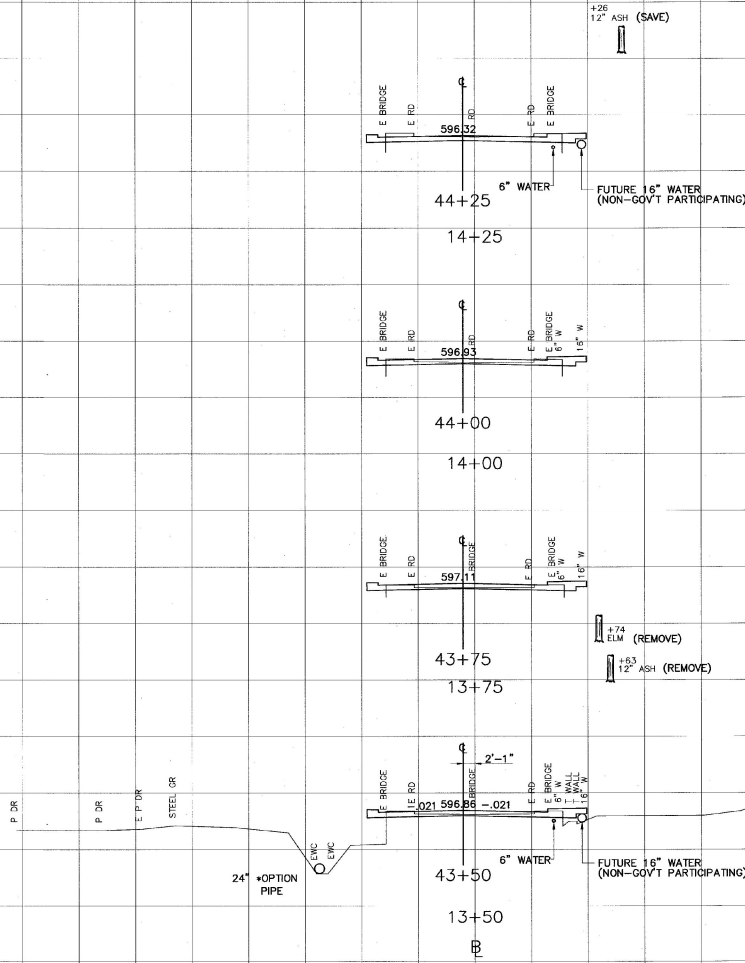

590
590
- OPTION PIPES
- CPEP
 - CPEP (SL)
 - RCP CLASS III

STATION 43+47 STOP ROADWAY
BEGIN BRIDGE

SCALE: 10 FEET

BETTIGOLE ANDREWS & CLARK, INC.
Consulting Engineers

FROM STA.	33+50	TO STA.	14+25
PROJECT NAME	BARRE CITY MAIN		
NO.	BSM 600(13)		
SURVEYED BY	REED	PLOTTED	12/98
SHEET	39 OF 46 SHEETS	B & C NO. 520388B4 (1-10)	