


FINAL	ISSUED	BY	DATE
NO.	NO.	NO.	NO.

ORIGINAL	ISSUED	BY	DATE
NO.	NO.	NO.	NO.

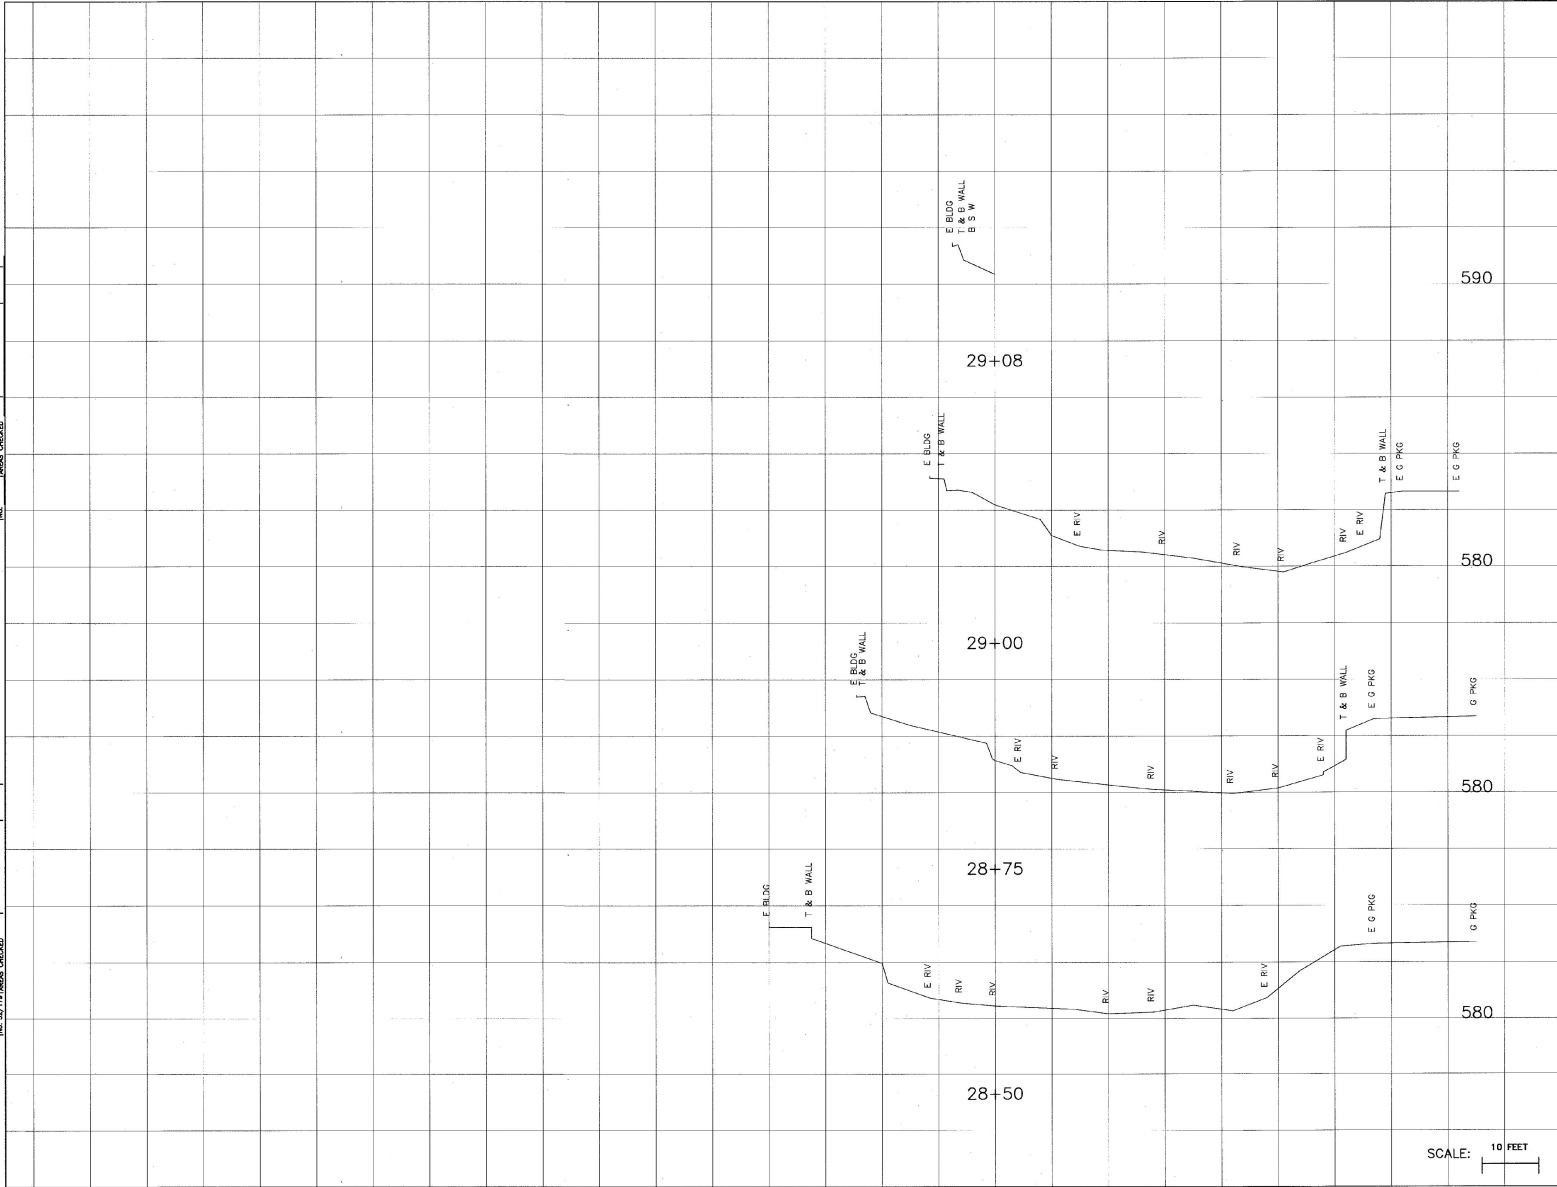

SCALE: 10 FEET

BETTIGOLE ANDREWS & CLARK, INC.
Consulting Engineers

FROM STA.	28+50	TO STA.	29+08
PROJECT NAME	BARRE CITY CHAN		
NO.	ERM 6000 (13)	PLOTTED	12/98
SURVEYED BY	REID	DATE	08/90 0325
SHEET 41	OF 46	SHEETS	B A & C NO. 92038886 (1-10)