


DESIGNED BY	DATE
CHECKED BY	DATE
IN CHARGE BY	DATE
NO.	

DESIGNED BY	DATE
CHECKED BY	DATE
IN CHARGE BY	DATE
NO.	

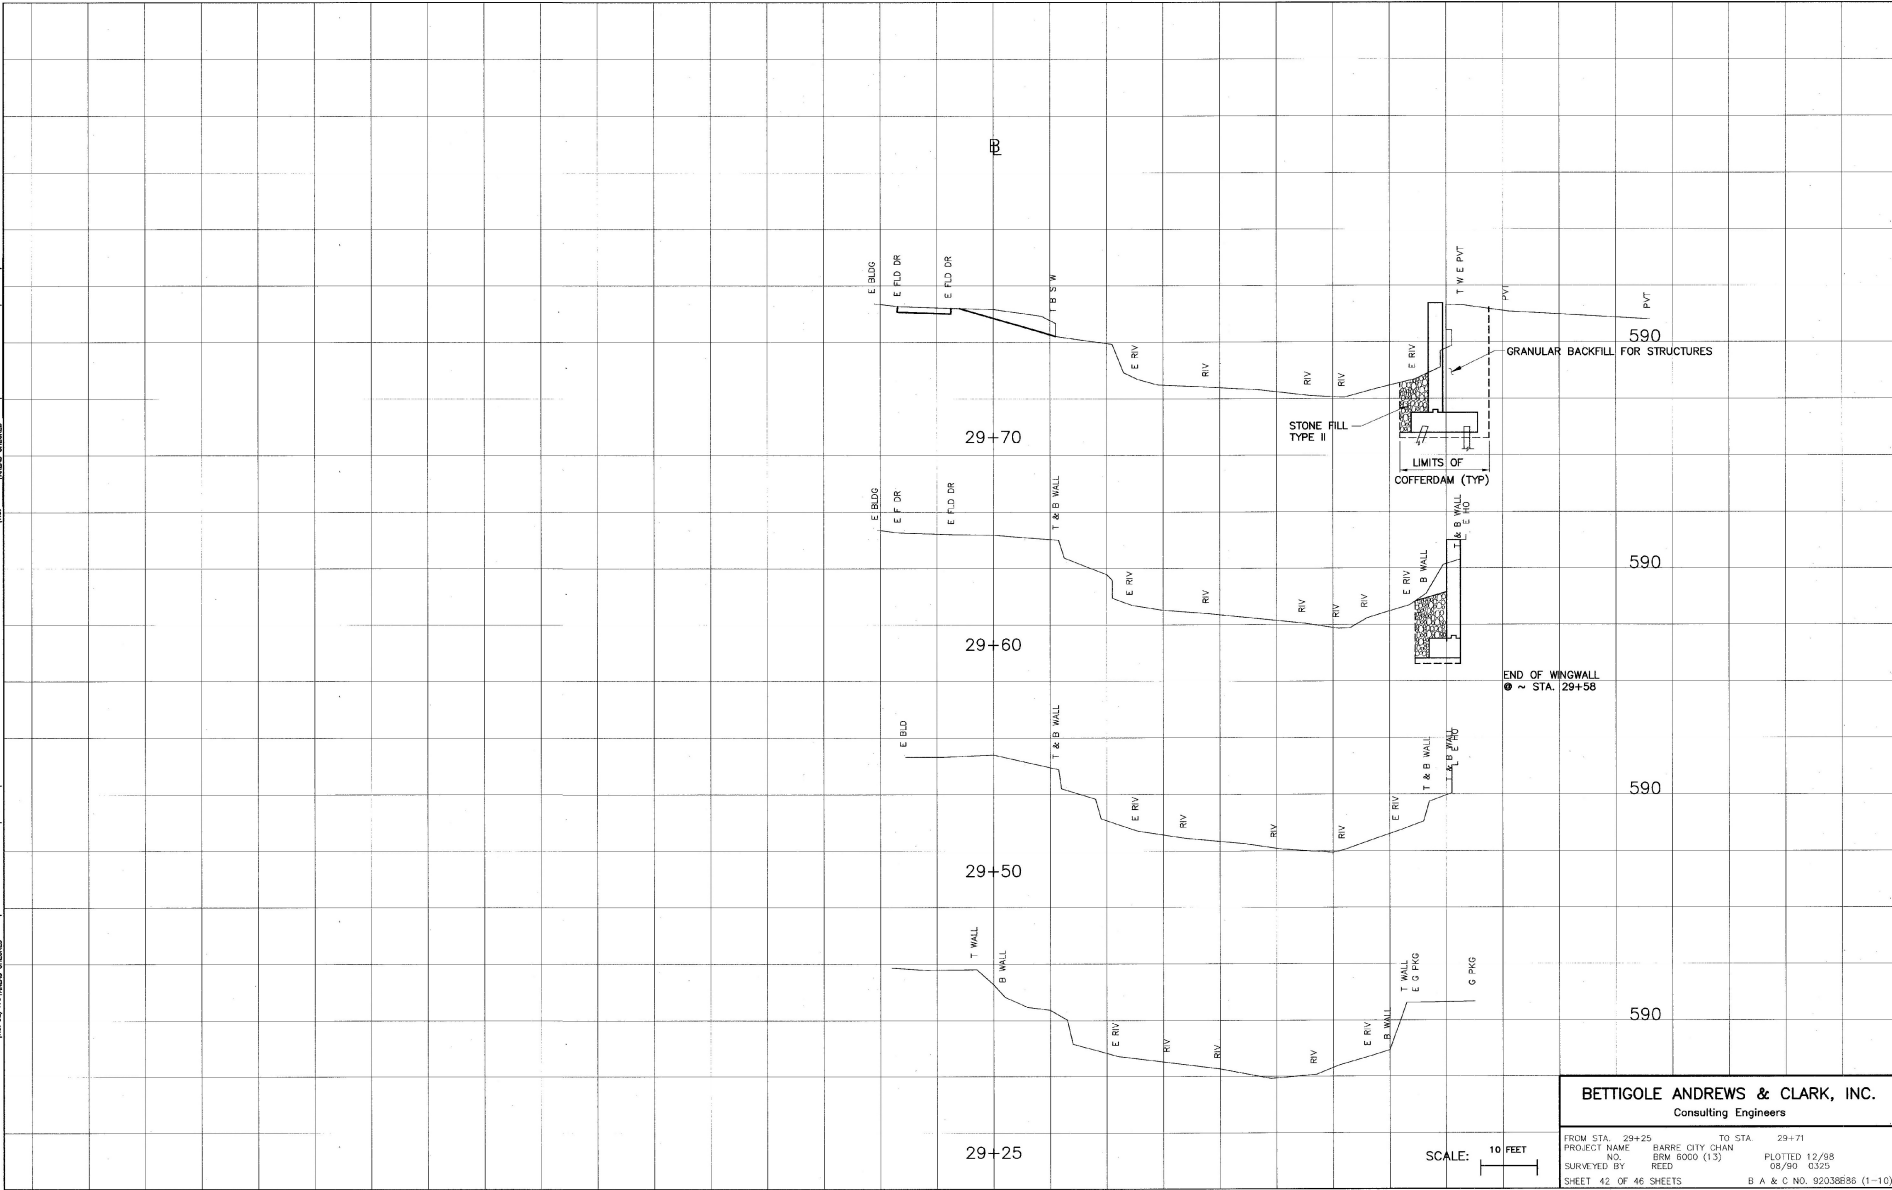

BETTIGOLE ANDREWS & CLARK, INC.
Consulting Engineers

FROM STA.	29+25	TO STA.	29+71
PROJECT NAME	BARRE CITY CHAN		
NO.	08/90	DATE	12/98
SURVEYED BY	REED	DATE	08/90
			0325
SHEET 42 OF 46 SHEETS		B A & C NO. 9203886 (1-10)	