


DESIGNED BY	CLARK
CHECKED BY	ANDREWS
DATE	08/90
SCALE	AS SHOWN
PROJECT NO.	6000 (13)
SHEET NO.	43 OF 46

DESIGNED BY	CLARK
CHECKED BY	ANDREWS
DATE	08/90
SCALE	AS SHOWN
PROJECT NO.	6000 (13)
SHEET NO.	43 OF 46

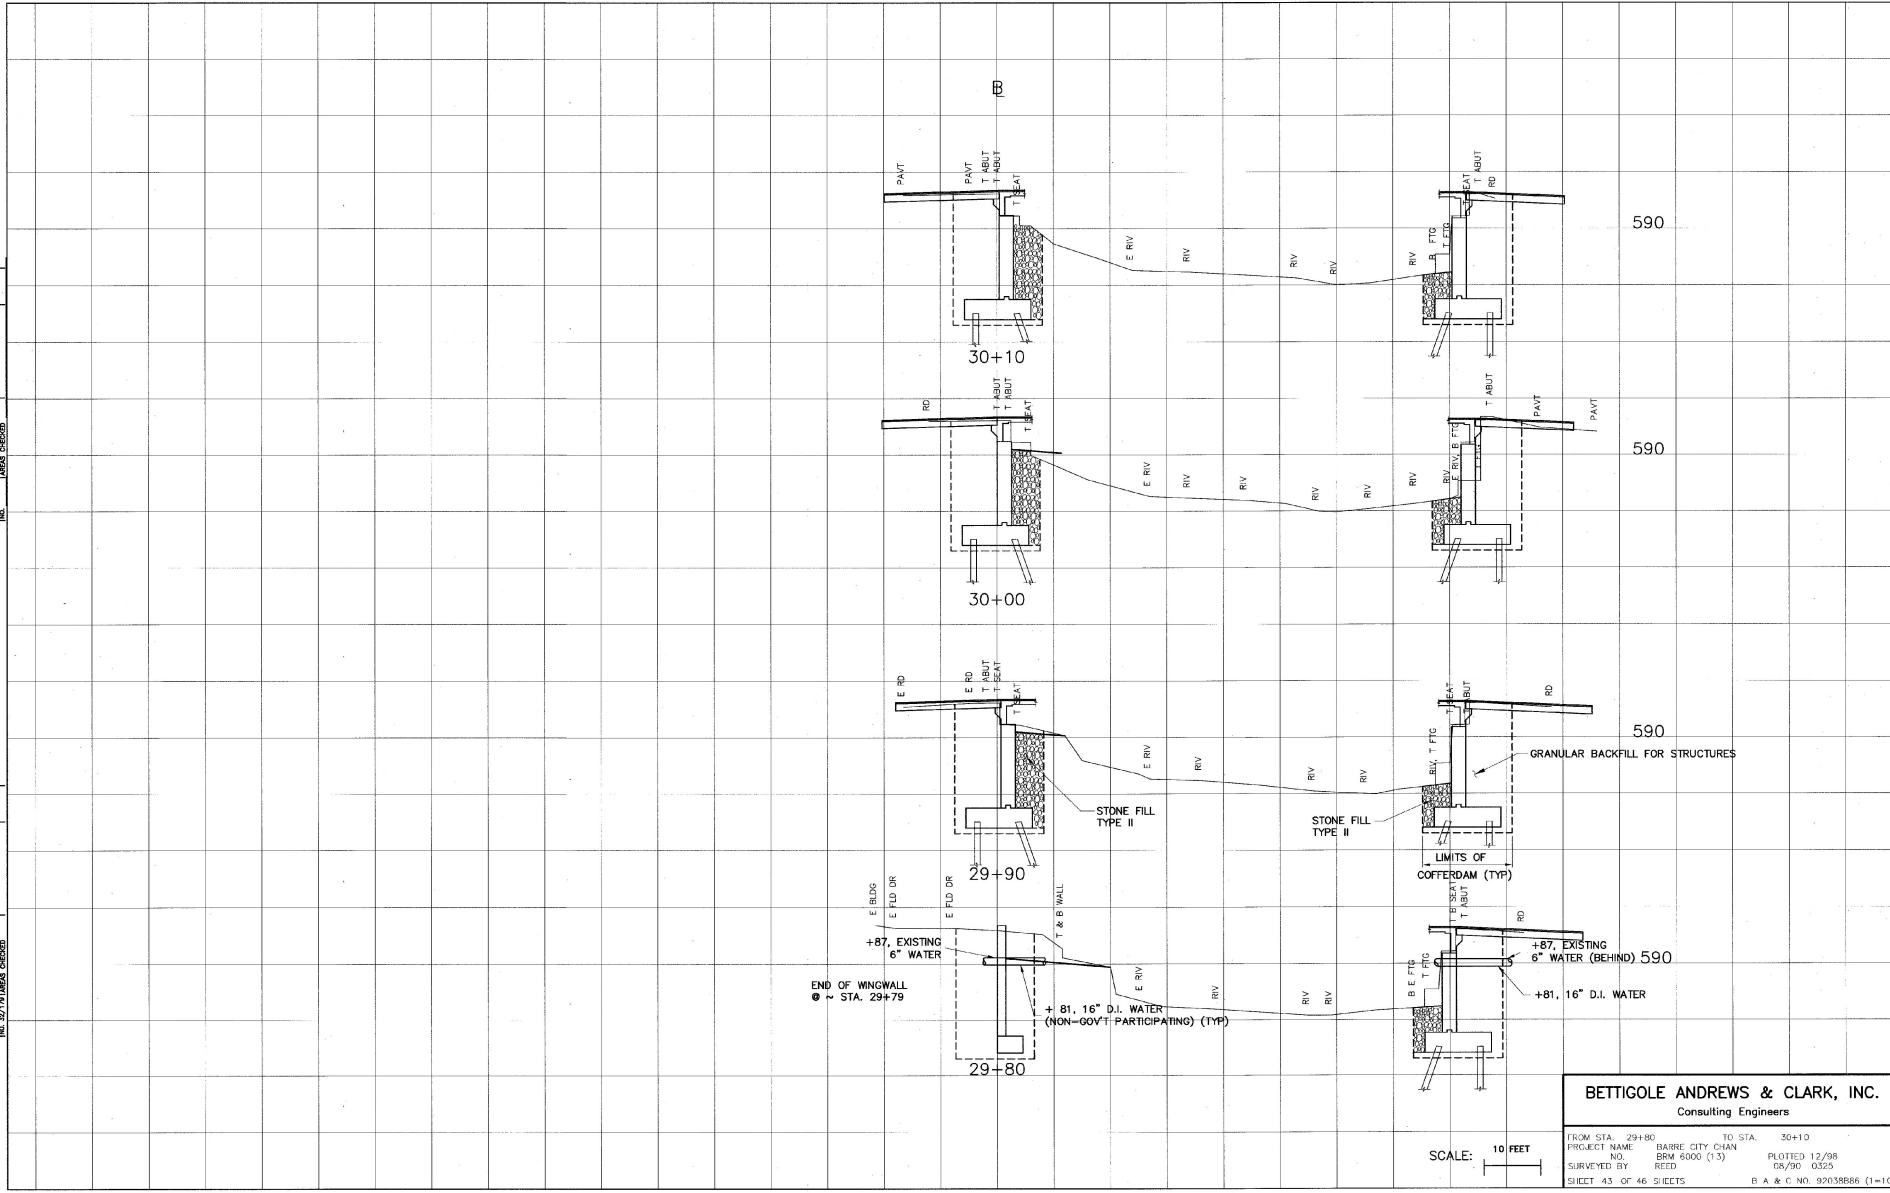

BETTIGOLE ANDREWS & CLARK, INC.
Consulting Engineers

FROM STA.	29+80	TO STA.	30+10
PROJECT NAME	BARRE CITY CHAN		
NO.	EDM 6000 (13)		
SURVEYED BY	REED		
DATE	08/90 0525		
SHEET 43 OF 46 SHEETS		B & C NO. 92038686 (1-10)	

SCALE: 10 FEET