

INDEX OF SHEETS

- 1 TITLE SHEET
- 2 PRELIMINARY INFORMATION & BRIDGE TYP. SECT.
- 3 TYPICAL ROADWAY SECTIONS
- 4 ABUTMENT & WINGWALL EARTHWORK SECTIONS
- 5 QUANTITY SHEET
- 6 RIGHT-OF-WAY SHEET 1 (BY VAOT)
- 7 RIGHT-OF-WAY SHEET 2 (BY VAOT)
- 8 SURVEY LAYOUT, BRIDGE RAIL LAYOUT & TIE SHEET
- 9 ROADWAY PLAN
- 10 ROADWAY PROFILE
- 11 PHASE 1 TRAFFIC CONTROL SHEET
- 12 PHASE 2 TRAFFIC CONTROL SHEET
- 13 BORING INFORMATION SHEET
- 14 GENERAL PLAN AND ELEVATION
- 15a-15g EROSION PREVENTION & SEDIMENT CONTROL SHEETS (BY VAOT)
- 16 GENERAL NOTES
- 17 SUPERSTRUCTURE DETAILS
- 18 FOOTING DETAILS
- 19 ABUTMENT MASONRY
- 20 ABUTMENT REINFORCING
- 21 WINGWALL DETAILS
- 22 REINFORCING STEEL SCHEDULE
- 23-25 ROADWAY CROSS SECTIONS
- 26 CHANNEL CROSS SECTIONS

STANDARD SHEETS

B-5	6-1-94
D-3	6-1-94
E-100	1-2-04
E-100A	1-2-04
E-101	5-30-03
E-102	6-30-03
E-102A	5-1-04
E-106	3-1-04
E-107	6-30-03
E-107A	6-8-09
E-108	6-8-09
E-108A	6-8-09
E-110	8-8-95
E-119	3-1-04
E-121	8-8-95
E-143	6-15-04
E-160	5-20-99
G-1	1-3-00
G-1D	1-3-00
G-18	6-1-94
SB-R6-82M	7-10-97

STATE OF VERMONT AGENCY OF TRANSPORTATION



PROPOSED IMPROVEMENT BRIDGE PROJECT

TOWN OF RIPTON
COUNTY OF ADDISON

ROUTE NO: TH 18 CLASS 3 BRIDGE NO: 17


PROJECT LOCATION: APPROXIMATELY 100 M SOUTH OF THE INTERSECTION
OF VT RTE 125 AND TH 18.

PROJECT DESCRIPTION: WORK TO BE PERFORMED UNDER THIS PROJECT INCLUDES
REHABILITATION AND WIDENING OF THE EXISTING BRIDGE
USING DETOURED TRAFFIC WITH NECESSARY ROADWAY
APPROACH WORK.

LENGTH OF ROADWAY 111.700 METERS

LENGTH OF BRIDGE 18.300 METERS

LENGTH OF PROJECT 130.000 METERS

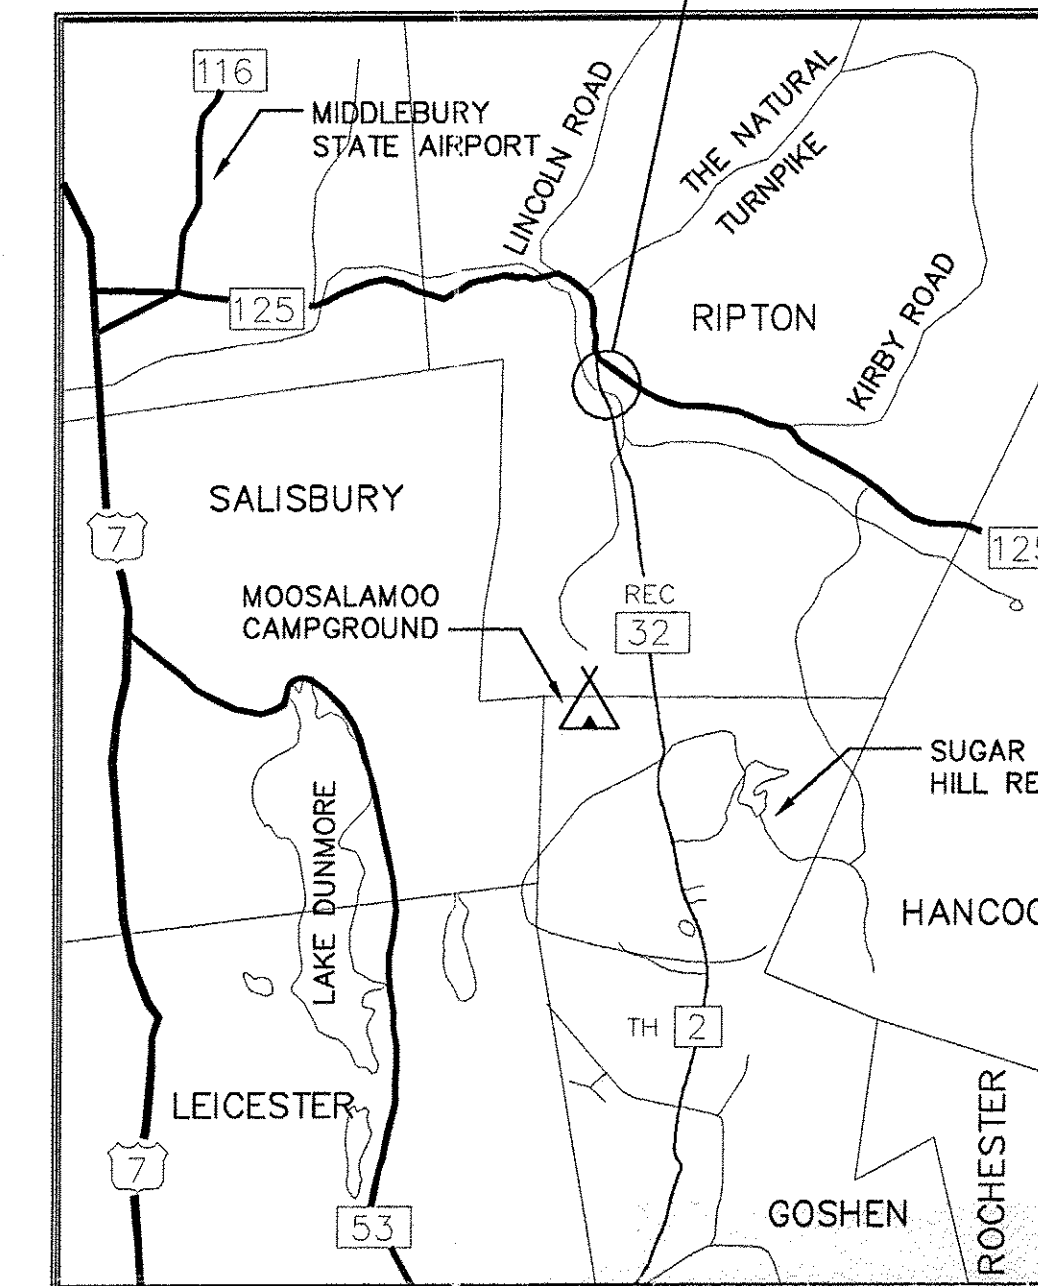

NOT TO SCALE

THESE PLANS ARE SUBJECT TO SUCH ENGINEERING CHANGES AS MAY BE REQUIRED BY THE FEDERAL HIGHWAY ADMINISTRATION OR THE DIRECTOR OF PROGRAM DEVELOPMENT.
CONSTRUCTION IS TO BE CARRIED ON IN ACCORDANCE WITH THESE PLANS AND THE STANDARD SPECIFICATIONS FOR CONSTRUCTION DATED 2006, AS APPROVED BY THE FEDERAL HIGHWAY ADMINISTRATION ON JUNE 15, 2006 FOR USE ON THIS PROJECT, INCLUDING ALL SUBSEQUENT REVISIONS AND SUCH REVISED SPECIFICATIONS AND SPECIAL PROVISIONS AS ARE INCORPORATED IN THESE PLANS.

RECORD PLANS

CONTRACTOR: CCS CONSTRUCTORS LLC- MORRISVILLE, VT

RESIDENT ENGINEER: JOSH HULETT

CONSTRUCTION BEGAN: JULY 7, 2010

CONSTRUCTION COMPLETE: JUNE 6, 2011

RECORD PLANS BY: JOSH HULETT & AMOS KEMPTON

I HEREBY CERTIFY THAT ALL THE CONSTRUCTION REQUIRED BY THIS SET OF DRAWINGS HAS BEEN ACCOMPLISHED AS INDICATED HEREIN.

BY *Josh Hulett* RESIDENT ENGINEER



DATE *12/21/2011*

NOTE: Any further information concerning final quantities, amounts or other details relative to this project may be found at Central Files in the electronic archives.


CONVENTIONAL SYMBOLS

COUNTY LINE	---
TOWN LINE	---
LIMITS OF ACCESS	○-○-○
POINT OF ACCESS	X
FENCE LINE	-x-x-
STONE WALL	○-○-○-○
TRAVELED WAY	
GUARD RAIL	○-○-○
RAILROAD	
SURVEY LINE	---
CULVERT	---
POWER POLE	□
TELEPHONE POLE	○
TREES	⊗
CONTROL OF ACCESS	///
PROPERTY LINE	---
R.O.W. TAKING LINE	SR
SLOPE RIGHTS	○-○-○
TOP OF CUT	△
TOE OF SLOPE	○

DATUM
VERTICAL NGVD 29 (1929)
HORIZONTAL ASSUMED

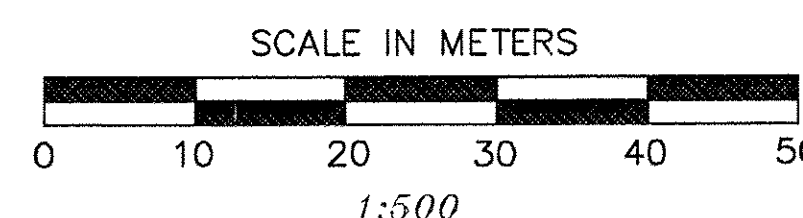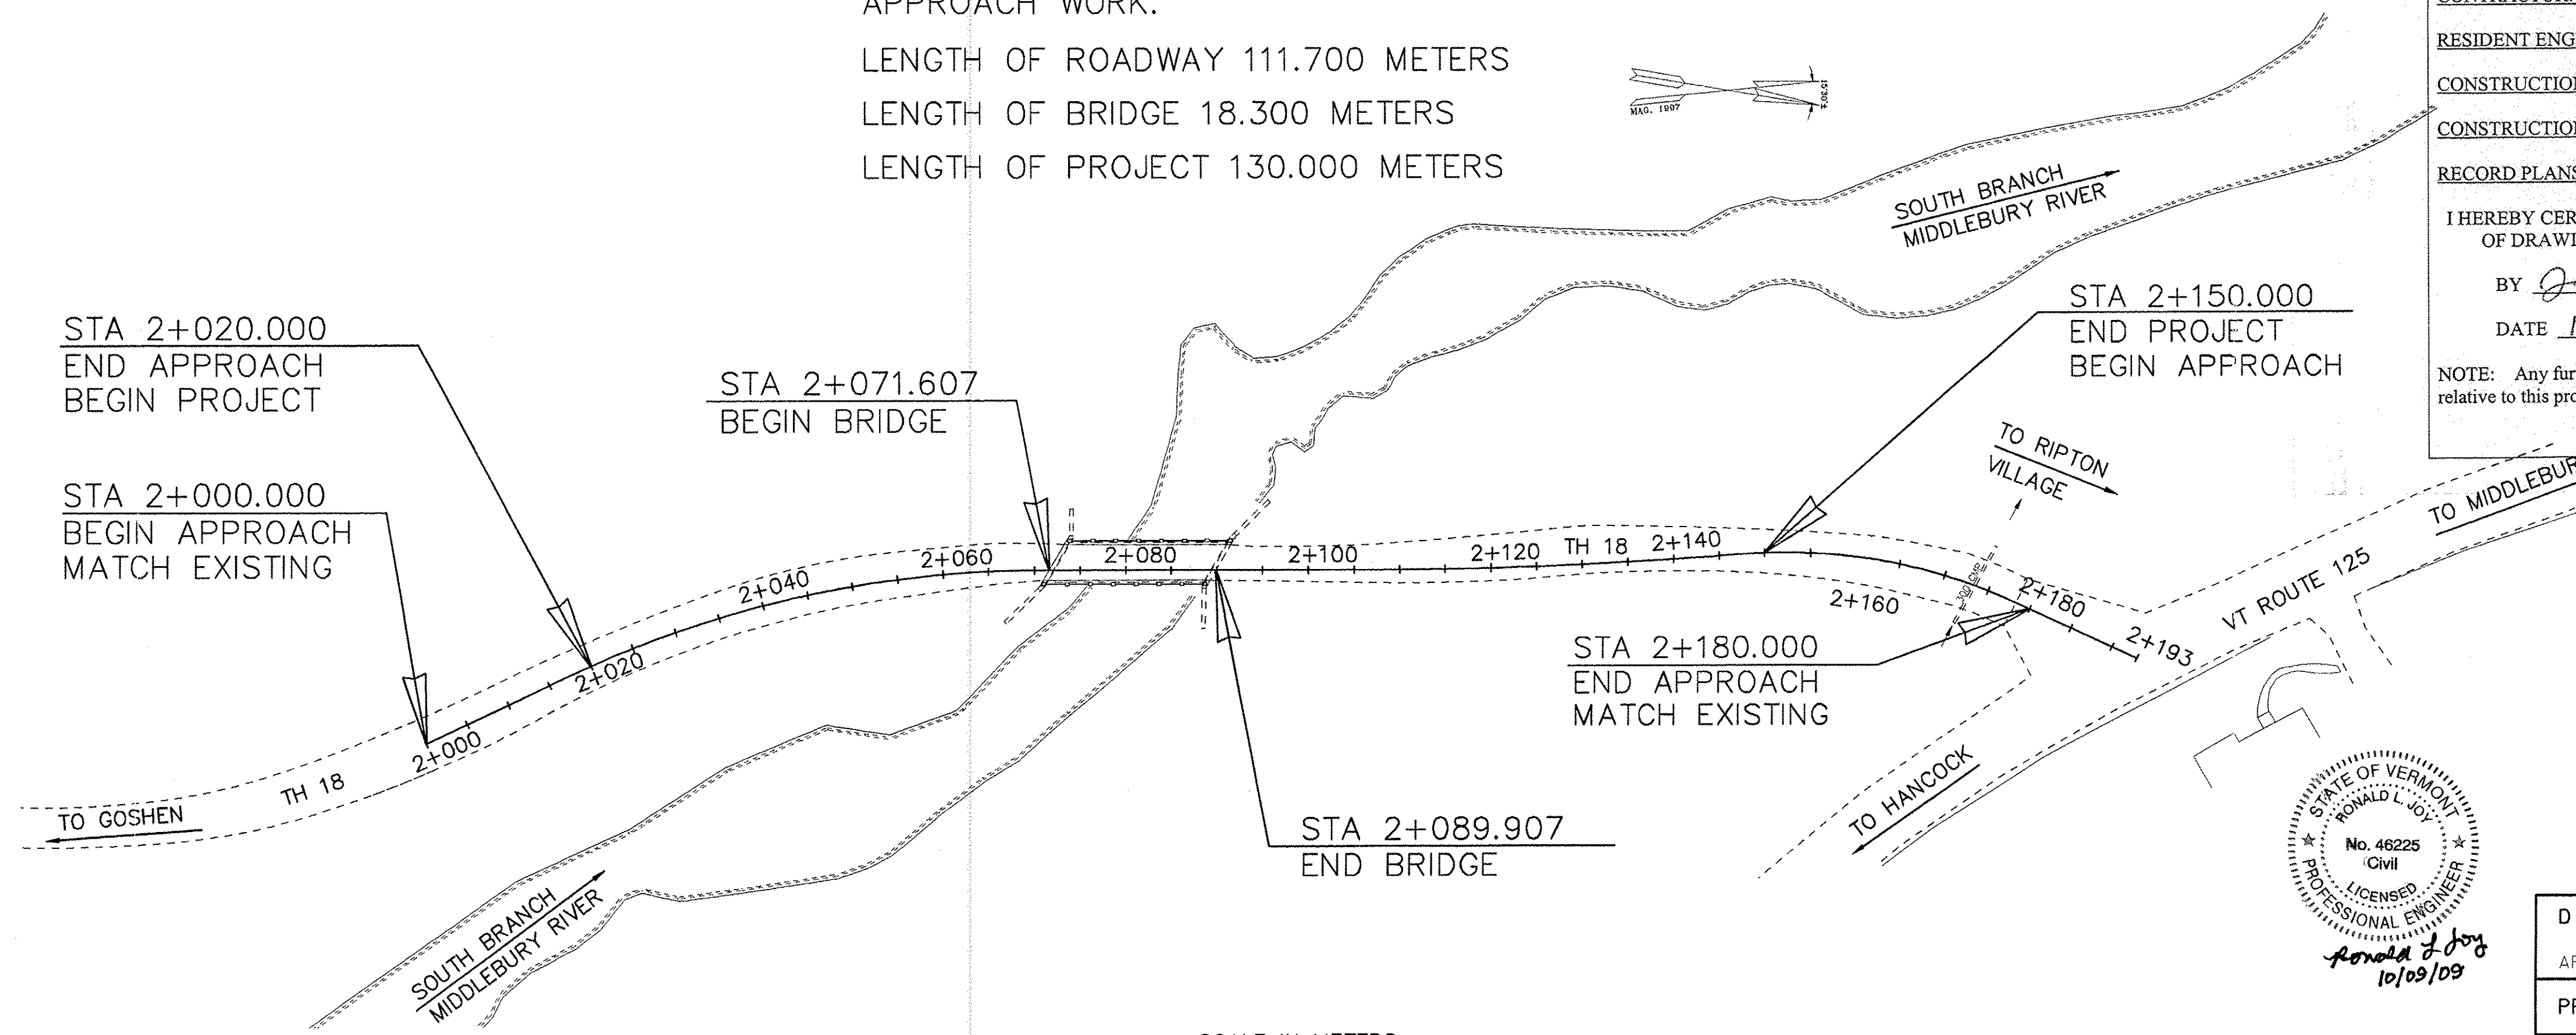

UNLESS NOTED OTHERWISE
STATIONS ARE IN KILOMETERS
ELEVATIONS ARE IN METERS
DIMENSIONS ARE IN MILLIMETERS

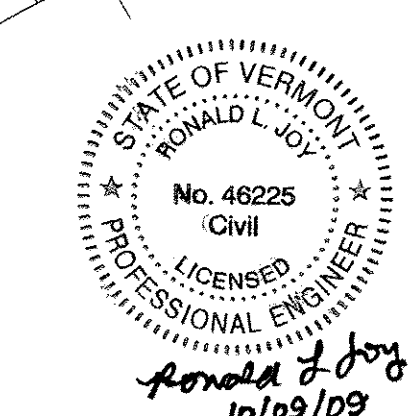

DIRECTOR OF PROGRAM DEVELOPMENT	
APPROVED <i>Ronald L. Landry</i>	DATE <i>10-13-09</i>
PROJECT MANAGER : DANNY R. LANDRY	
PROJECT NAME : RIPTON	
PROJECT NUMBER : FH 010-1(42)	
SHEET 1 OF 26 SHEETS	

