

FILL SECTION

ROADWAY SECTION (PAVED SURFACE)


CUT SECTION

* 750 BEHIND ABUTMENTS, SEE SUBBASE DETAIL AT ABUTMENTS ON SHEET 24 OF 26.

STA 2+056.500 TO STA 2+071.607
STA 2+089.907 TO STA 2+180.000
SCALE 1:50




MATERIAL ITEM	THICKNESS TOLERANCE
AGGREGATE SURFACE COURSE	±10
SUBBASE GRAVEL	±30
SAND BORROW	±30
PAVEMENT	±5

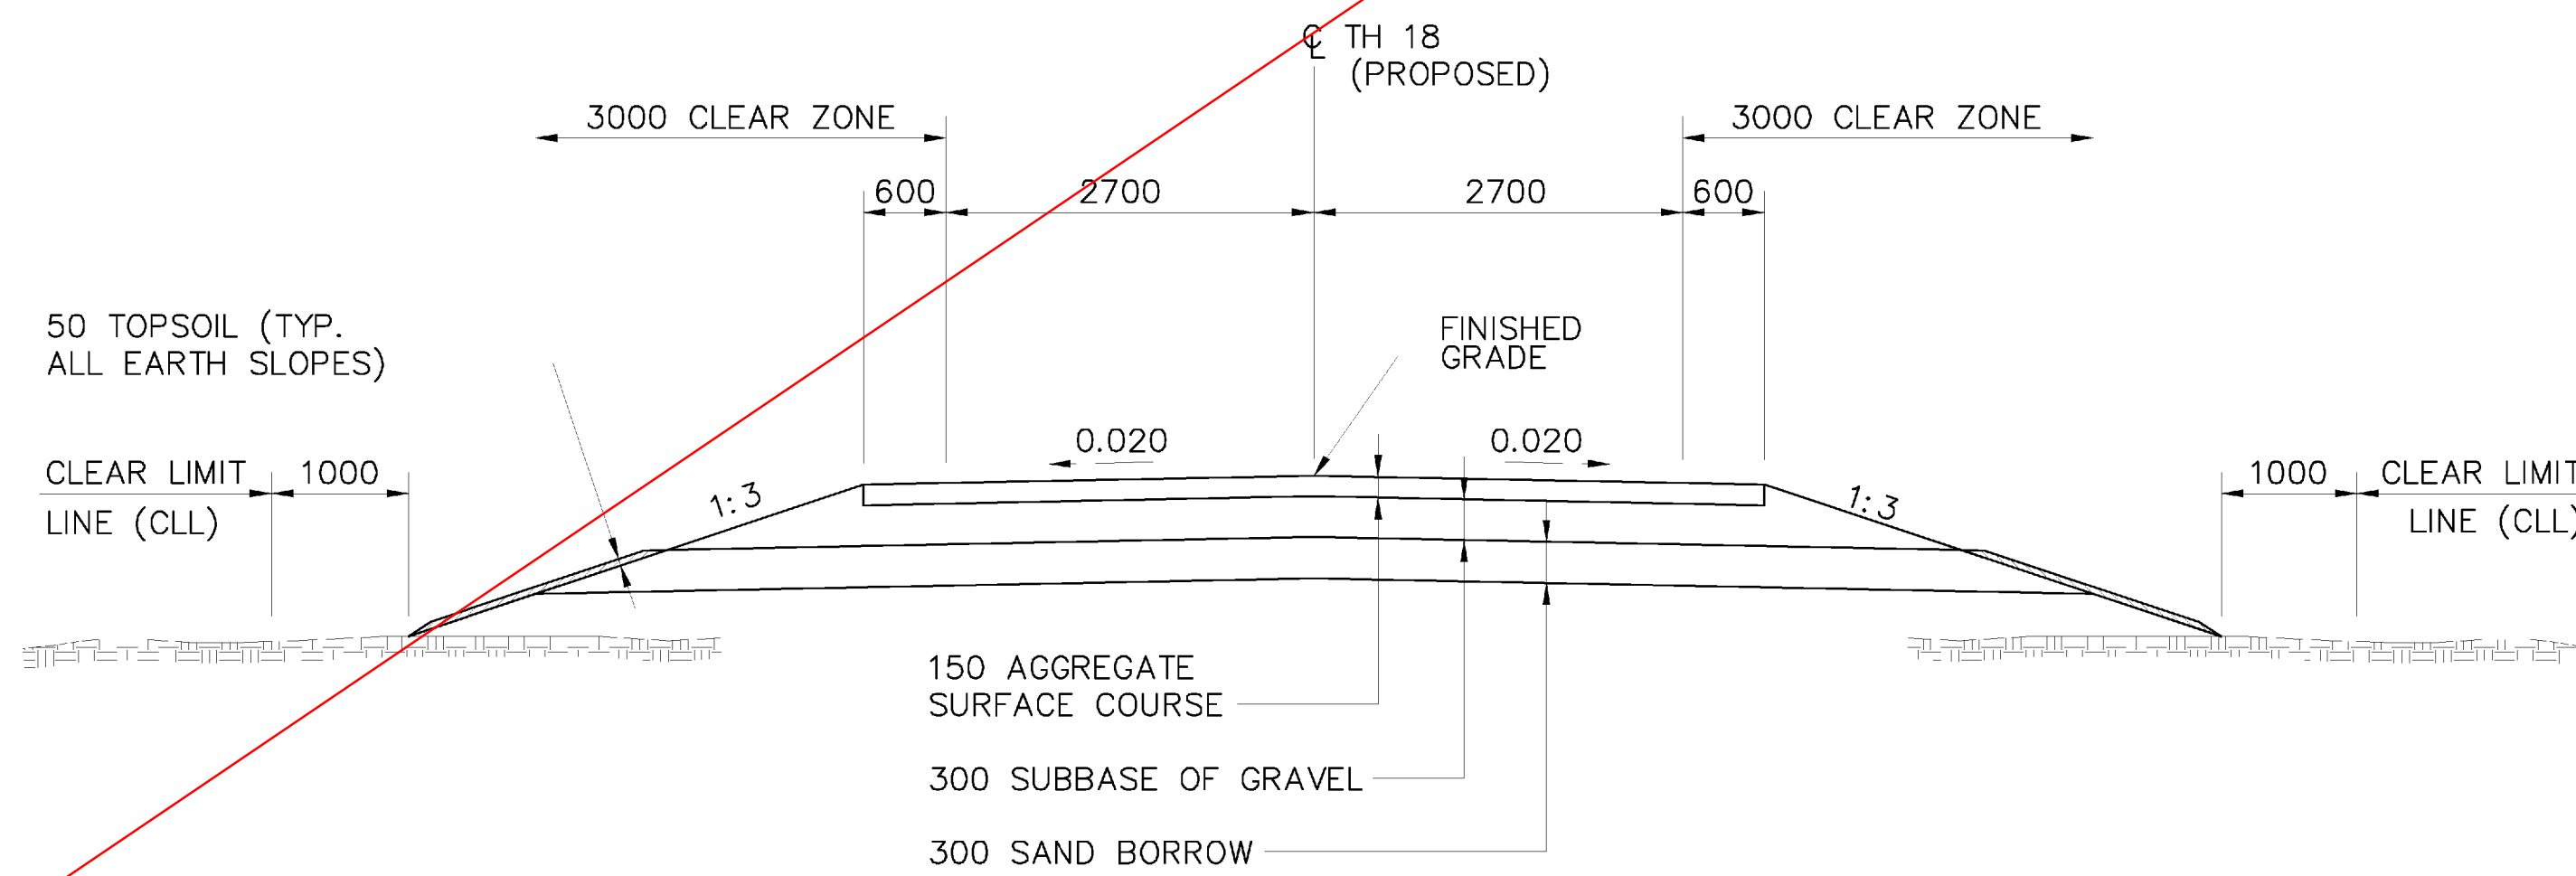

ROADWAY SECTION (AGGREGATE SURFACE)

STA 2+020.000 TO STA 2+056.500
SCALE 1:50

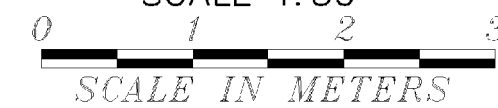

SEE REVISED SHEET

**STATE OF VERMONT
AGENCY OF TRANSPORTATION**

Town Of	RIPTON	Bridge No.	BRIDGE #17
Highway No.	TH 18	Log Sta.	
		Surv. Sta.	
TH 18 OVER SOUTH BRANCH MIDDLEBURY RIVER			
TYPICAL ROADWAY SECTIONS			
Designed By	B P GUZAS	Drawn By	W J GAYNOR
Checked By	Y I LIU	Bridge Design Supervisor	R L JOY
	Date 8/09		Date 10/09
PROJECT	RIPTON	PROJECT NO.	FH 010-1(2)
I.G.C. Info.			
Bridge Sheet No.		Sheet	3 of 26



M:\1734-300 Ripton 17\BRDG\Z89E039RSEC_01.DGN