


MATERIAL ITEM	THICKNESS TOLERANCE
AGGREGATE SURFACE COURSE	±10
SUBBASE GRAVEL	±30
SAND BORROW	±30
PAVEMENT	±5

REVISIONS

ADDED ADDITIONAL TYPICAL SECTIONS, REVISED ROADWAY SLOPES FOR GUARDRAIL AND STONE FILL.

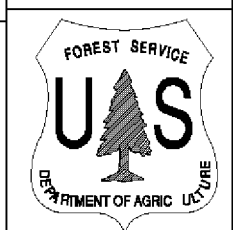

STATE OF VERMONT AGENCY OF TRANSPORTATION

Town Of **RIPTON** Bridge No. **BRIDGE #17**

Highway No. **TH 18** Log Sta. **Surv. Sta.**

TH 18 OVER SOUTH BRANCH MIDDLEBURY RIVER

TYPICAL ROADWAY SECTIONS

Designed By **B P GUZAS** Drawn By **W J GAYNOR**

Checked By **Y I LIU** Date **8/09** Bridge Design Supervisor **R L JOY** Date **10/09**

PROJECT **RIPTON** PROJECT NO. **FH 010-1(2)**

I.G.C. Info. **Bridge Sheet No.** Sheet **3 R of 26**