

ALIGNMENT DATA


CONSTRUCTION CENTERLINE	SURVEY BASELINE		NORTHING	EASTING
	STATION	OFFSET		
BEGIN PROJECT STA 2+020.000	1+042.887	6116 LT	4829.0966	9993.6156
PI CURVE 1 STA 2+043.636 BK. = STA 2+042.676 AH.	1+066.399	8537 LT	4851.1937	9985.2230
PI CURVE 2 STA 2+126.878 BK. = STA 2+126.856 AH.	1+148.680	1487 LT	4935.0177	9993.2034
PI CURVE 3 STA 2+163.053 BK. = STA 2+162.343 AH.	1+184.783	3941 LT	4971.2112	9993.6961
END PROJECT STA 2+150.000	1+171.764	2990 LT	4958.1589	9993.5841
CURVE 1	CURVE 2	CURVE 3		
Δ = 26°03'45"	Δ = 04°39'30"	Δ = 29°36'45"		
R = 120.000	R = 500.000	R = 60.000		
T = 27.773	T = 20.337	T = 15.860		
L = 54.586	L = 40.652	L = 31.010		
E = 3.172	E = 0.413	E = 2.061		

COORDINATES

POINT	STATION	NORTHING	EASTING
BEGIN APPROACH	2+000.000	4810.3540	10000.5934
PC	2+015.863	4825.2004	9995.0058
PT	2+070.449	4878.8420	9987.8552
BEGIN BRIDGE	2+071.607	4879.9953	9987.9650
END BRIDGE	2+089.907	4898.2130	9989.6934
PC	2+106.541	4914.7720	9991.2759
PRC	2+147.193	4955.3530	9993.4802
PT	2+178.203	4984.8914	10001.7198
END APPROACH	2+180.000	4986.4414	10002.6290

LEGEND


— CLL — = CLEAR LINE LIMIT
 — CZ — = CLEAR ZONE

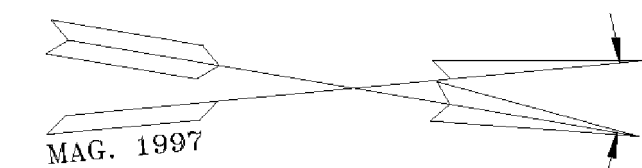

NOTE:
HORIZONTAL DATUM BASE IS ASSUMED

STA 2+020.000
END APPROACH
BEGIN PROJECT

STA 2+000.000
BEGIN APPROACH
MATCH EXISTING

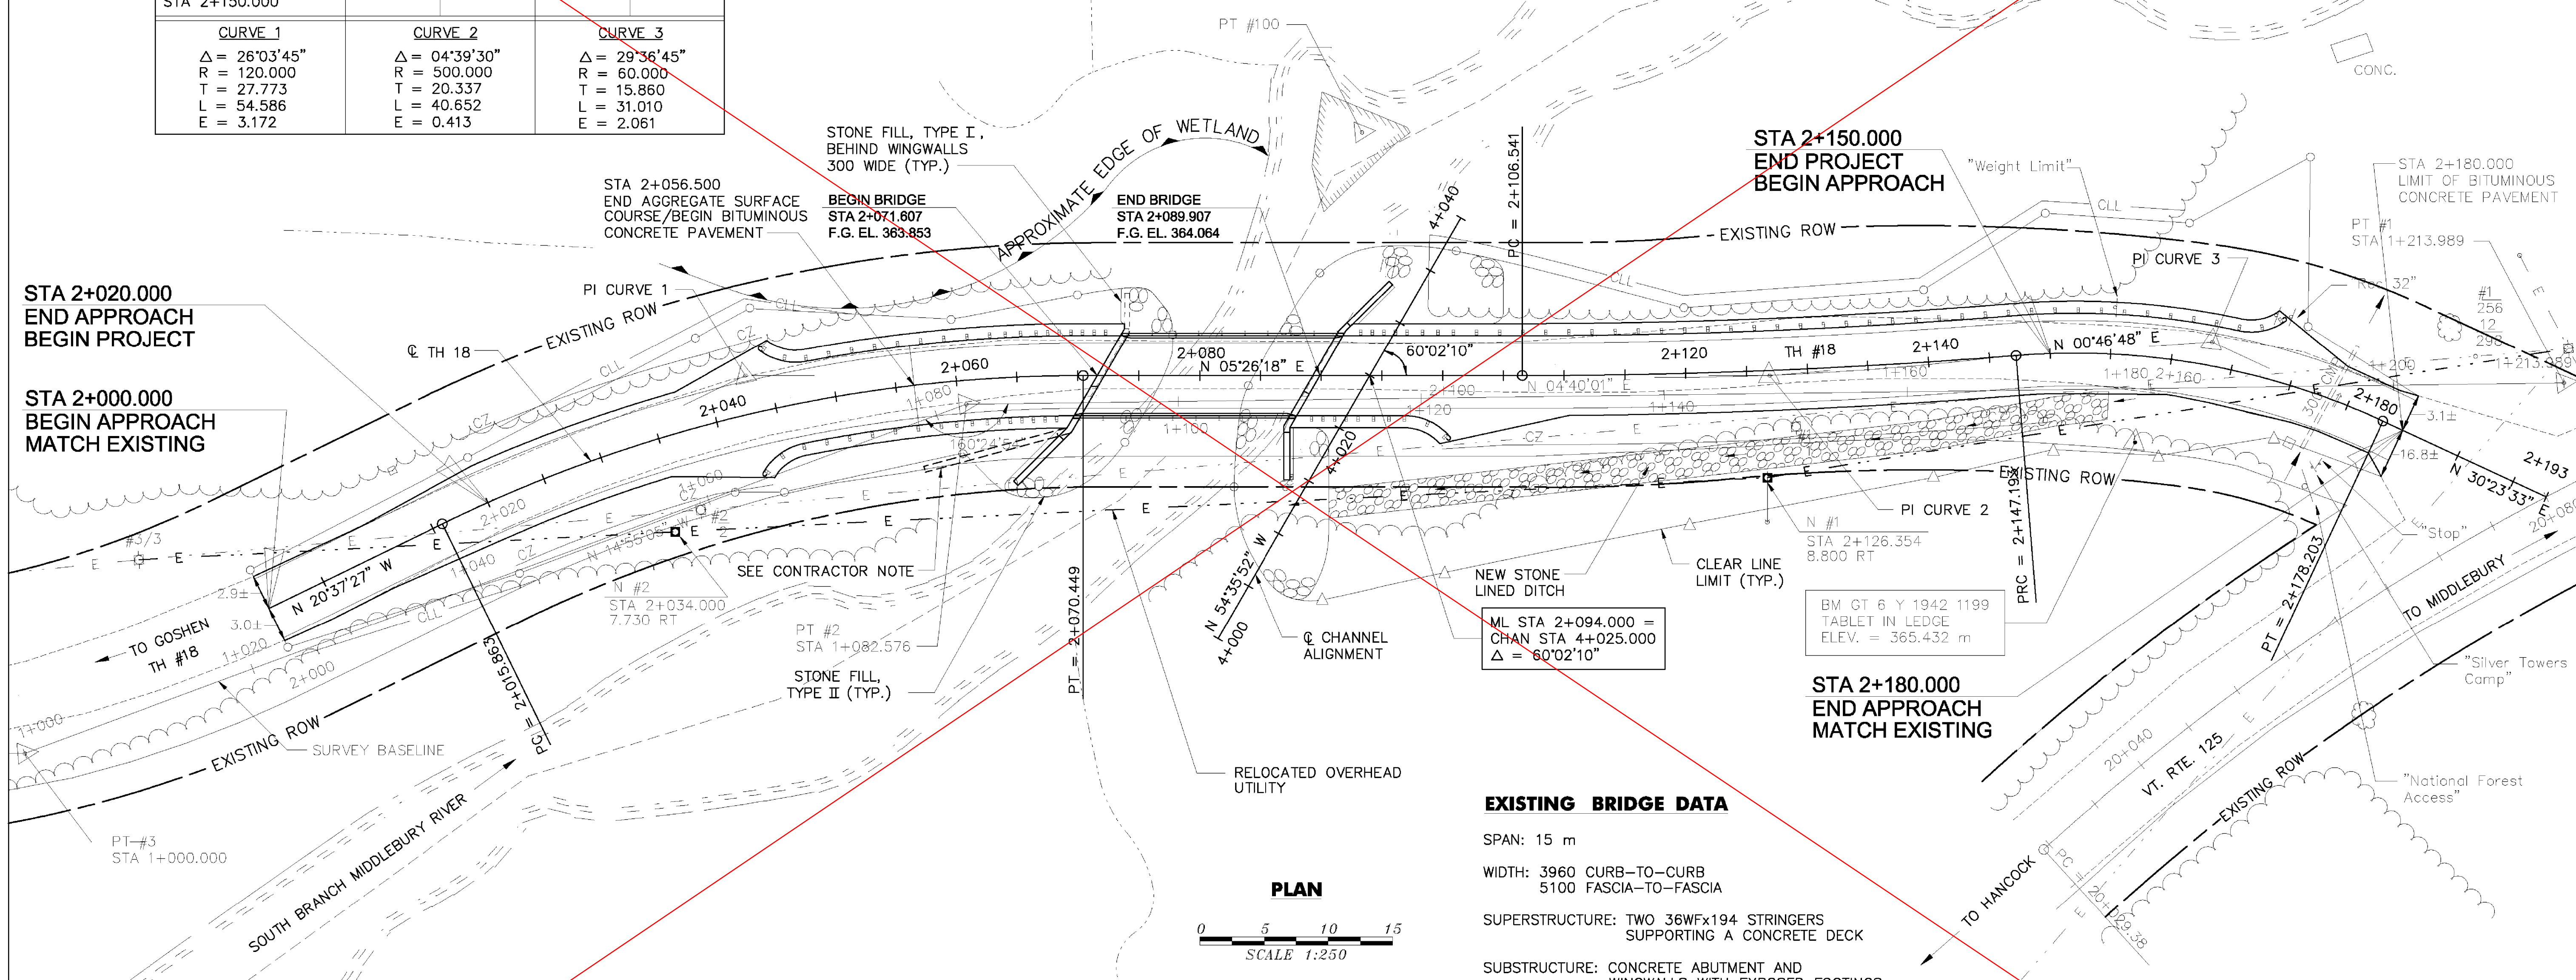

PLAN



EXISTING BRIDGE DATA

SPAN: 15 m
 WIDTH: 3960 CURB-TO-CURB
 5100 FASCIA-TO-FASCIA
 SUPERSTRUCTURE: TWO 36WFx194 STRINGERS
 SUPPORTING A CONCRETE DECK
 SUBSTRUCTURE: CONCRETE ABUTMENT AND
 WINGWALLS WITH EXPOSED FOOTINGS

CONSTRUCTION NOTES

**REMOVING SIGNS
 SETTING SALVAGED POSTS
 ERECTING SALVAGED SIGN**
 STA 2+167.4, 5.3 LT REMOVE AND RESET
 STA 2+168.5, 5.5 LT REMOVE AND RESET
 STA 2+155.0, 3.9 LT REMOVE AND RESET
 REMOVING SIGNS PAID UNDER ITEM 675.50
 SETTING SALVAGED POSTS PAID UNDER ITEM 675.61
 ERECTING SALVAGED SIGNS PAID UNDER ITEM 675.60

**SPECIAL PROVISION (BRIDGE RAILING, WEATHERING
 HD STEEL BEAM/FASCIA MOUNTED)**
 STA 2+072.299, 3.300 LT - STA 2+093.252, 3.300 LT
 STA 2+068.200, 3.300 RT - STA 2+089.217, 3.300 RT
 (PAID UNDER 900.640)

**SPECIAL PROVISION (HD STEEL GUARDRAIL,
 WEATHERING) (WOOD POSTS)**
 STA 2+044.098, 4.800 LT - STA 2+072.299, 3.300 LT
 STA 2+093.252, 3.300 LT - STA 2+168.075, 4.800 LT
 STA 2+042.943, 4.800 RT - STA 2+068.200, 3.300 RT
 STA 2+089.217, 3.300 RT - STA 2+100.393, 4.800 RT
 (PAID UNDER ITEM 900.640)

ANCHOR FOR STEEL BEAM RAIL
 STA 2+046.400, 3.400 LT
 STA 2+166.700, 3.400 LT
 STA 2+044.800, 3.400 RT
 STA 2+098.600, 3.400 RT
 (PAID UNDER ITEM 621.60)

NOTE: CONSTRUCTION NOTE OFFSETS ARE IN METERS.

NOTE TO CONTRACTORS:
 THE INFORMATION INSIDE THIS BOX SUPERSEDES OTHER
 INFORMATION WITHIN THIS CONTRACT PLAN SET.

1. WINGWALL #2, STAT. 2+065 RT. (UPSTREAM RIGHT SIDE) IS GOING TO BE LENGTHENED (APPROX. 6m) ONCE ADDITIONAL SURVEY IS TAKEN. YOU SHALL ASSUME THAT THE BOTTOM OF FOOTING ELEVATION WILL STAY THE SAME. SEE ESTIMATED LOCATION ON THIS SHEET. ESTIMATED QUANTITIES HAVE ALREADY BEEN ADDED TO THE QUANTITY SHEET AND ESTIMATE TO REFLECT THIS.
2. WE ANTICIPATE ADDITIONAL STONE FILL TYPE II FOR 30m ALONG THE SLOPE WILL BE USED. ADDITIONAL QUANTITIES OF UNCLASSIFIED CHANNEL, STONE FILL, TYPE II AND GEOTEXTILE UNDER STONE FILL HAVE ALREADY BENN ADDED TO THE QUANTITY SHEET AND ESTIMATE.
3. THE TEMPORARY PEDESTRIAN BRIDGE WILL NOW BE LOCATED ON THE DOWN STREAM SIDE, INSIDE THE EXISTING ROW, AND SPANNING BEHIND THE EXISTING WINGWALLS WITHOUT IMPACTING WETLANDS NEAR WINGWALL #1.

SEE REVISED SHEET

**STATE OF VERMONT
 AGENCY OF TRANSPORTATION**

Town Of	RIPTON	Bridge No.	BRIDGE #17
Highway No.	TH 18	Log Sta.	
		Surv. Sta.	
TH 18 OVER SOUTH BRANCH MIDDLEBURY RIVER ROADWAY PLAN			
Designed By	B P GUZAS	Drawn By	W J GAYNOR
Checked By	W R MERWARTH	Date	8/09
		Bridge Design Supervisor	R L JOY
		Date	10/09
PROJECT	RIPTON	PROJECT NO.	FH 010-1(2)
I.G.C. Info.			
Bridge Sheet No.		Sheet	9 of 26

