


PROFILE

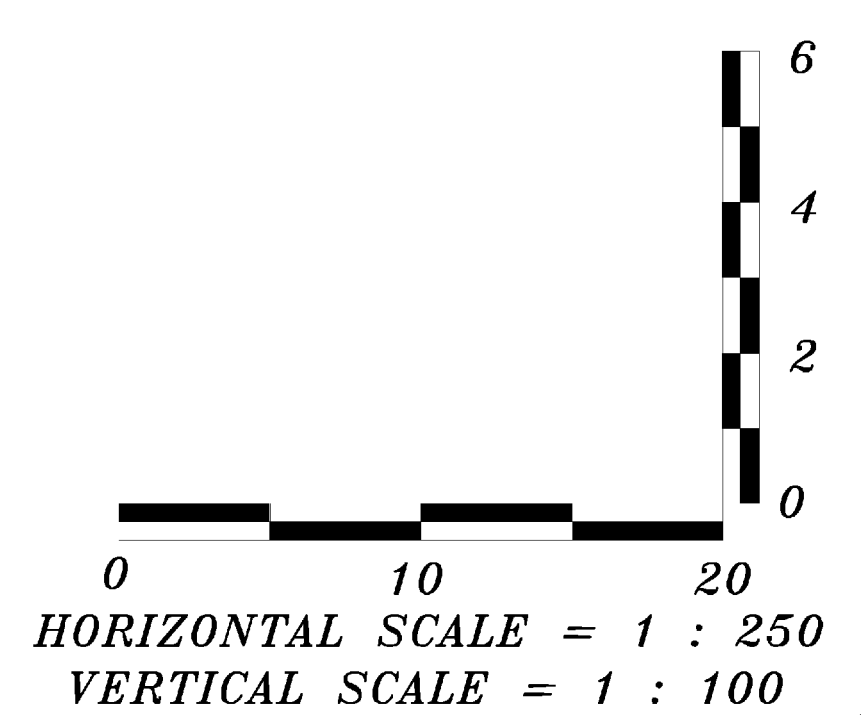


NOTE:
 GRADES SHOWN TO THE NEAREST HUNDREDTH ARE THE ORIGINAL
 GROUND ELEVATIONS ALONG THE PROPOSED ALIGNMENT.
 GRADES SHOWN TO THE NEAREST THOUSANDTH ARE THE FINISHED
 GRADES ALONG THE PROPOSED ALIGNMENT.

SEE REVISED SHEET

STATE OF VERMONT
AGENCY OF TRANSPORTATION

Town Of	RIPTON	Bridge No.	BRIDGE #17
Highway No.	TH 18	Log Sta.	
		Surv. Sta.	
TH 18 OVER SOUTH BRANCH MIDDLEBURY RIVER			
ROADWAY PROFILE			
Designed By	B P GUZAS	Drawn By	W J GAYNOR
Checked By	Date	Bridge Design Supervisor	
W R MERWARTH	8/09	R L JOY	Date 10/09
PROJECT	RIPTON	PROJECT NO.	FH 010-1(2)
I.G.C. Info.		Bridge Sheet No.	Sheet 10 of 26

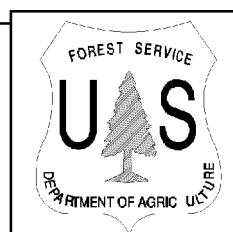

M:\1734300 Rip\17\18-WA\Z88E039PRO_01.DGN