



**PROFILE**

NOTE:  
 GRADES SHOWN TO THE NEAREST HUNDREDTH ARE THE ORIGINAL GROUND ELEVATIONS ALONG THE PROPOSED ALIGNMENT.  
 GRADES SHOWN TO THE NEAREST THOUSANDTH ARE THE FINISHED GRADES ALONG THE PROPOSED ALIGNMENT.

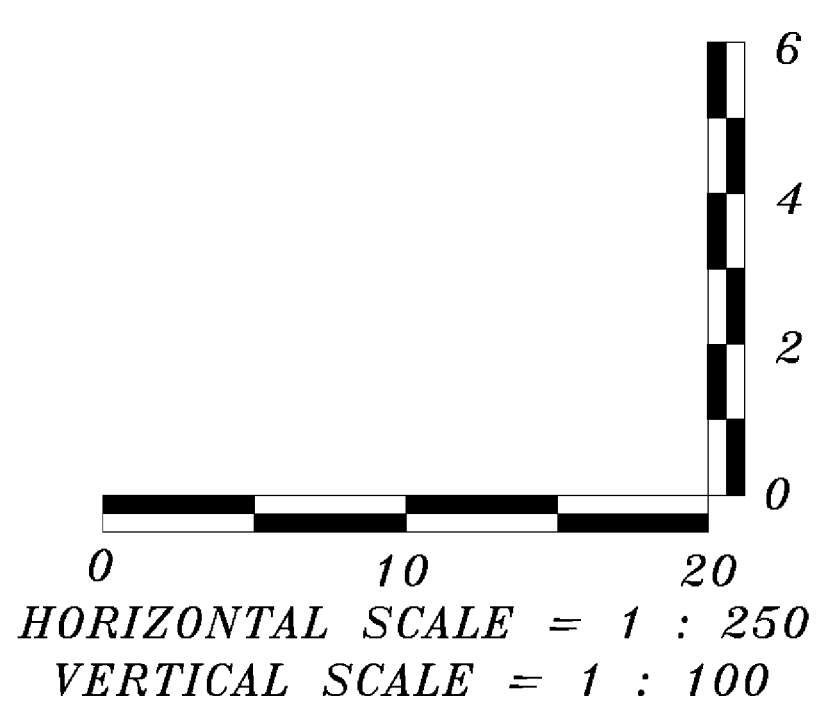

**REVISIONS**  
 REVISED BEGIN APPROACH GRADE AND EXISTING ELEVATIONS.

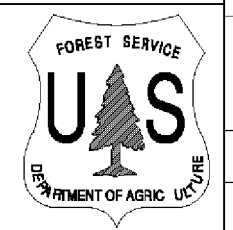

STATE OF VERMONT AGENCY OF TRANSPORTATION		
Town Of	RIPTON	Bridge No. BRIDGE #17
Highway No.	TH 18	Log Sta. Surv. Sta.
TH 18 OVER SOUTH BRANCH MIDDLEBURY RIVER ROADWAY PROFILE		
Designed By	B P GUZAS	Drawn By W J GAYNOR
Checked By	W R MERWARTH	Bridge Design Supervisor
Date	8/09	R L JOY Date 10/09
PROJECT	RIPTON	PROJECT NO. FH 010-1(2)
I.G.C. Info.		
Bridge Sheet No.		Sheet 10R of 26