


NOTE:  
THE TOWN OF RIPTON SHALL BE RESPONSIBLE FOR SIGNING THE ALTERNATE/DETOUR ROUTE.

**SUGGESTED PHASE 2 CONSTRUCTION SEQUENCE**

1. CLOSE TOWN HWY. #18.
2. RECONSTRUCT BRIDGE SEATS AND CAP EXISTING DOWNSTREAM WINGWALL #3.
3. RECONSTRUCT ROADWAY APPROACHES.
4. SET PREFABRICATED SUPERSTRUCTURE.
5. REMOVE TEMPORARY PEDESTRIAN BRIDGE.
6. OPEN TOWN HWY. #18 TO TRAFFIC.
7. COMPLETE GRADING AND PAVING.
8. THE CONTRACTOR SHALL LIMIT THE ROAD CLOSURE TO THREE WEEKS.

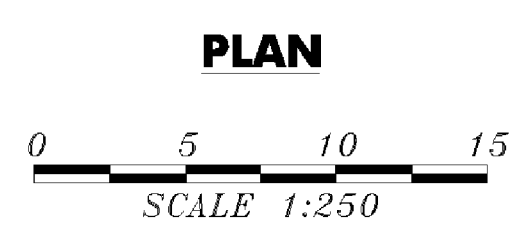

**LEGEND**  
 = TEMPORARY TRAFFIC BARRIER

SEE REVISED SHEET

**STATE OF VERMONT AGENCY OF TRANSPORTATION**

Town Of	RIPTON	Bridge No.	BRIDGE #17
Highway No.	TH 18	Log Sta.	
		Surv. Sta.	
TH 18 OVER SOUTH BRANCH MIDDLEBURY RIVER			
PHASE 2 TRAFFIC CONTROL SHEET			
Designed By	B P GUZAS	Drawn By	W J GAYNOR
Checked By	Y I LIU	Bridge Design Supervisor	R L JOY
Date	8/09	Date	10/09
PROJECT	RIPTON	PROJECT NO.	FH 010-1(2)
I.G.C. Info.		Bridge Sheet No.	Sheet 12 of 26

