


BM GT 6 Y
1942 1199
TABLET IN LEDGE
EL 365.432m

SEE REVISED SHEET

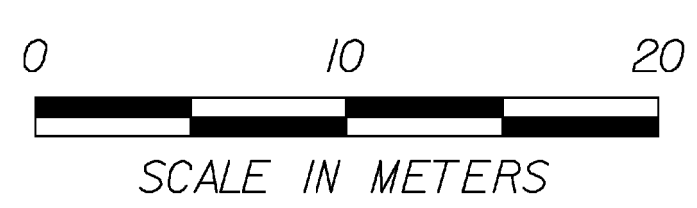

EPSC - EXISTING CONDITIONS

PROJECT NAME: RIPTON	PLOT DATE: ####DATE###
PROJECT NUMBER: FH 010-1(2)	DRAWN BY: Weeber
FILE NAME: z89e039border.dgn	CHECKED BY: Farnsworth
PROJECT LEADER: Farnsworth	SHEET 15b OF 26
DESIGNED BY: Farnsworth	
z89e039excond.i	