

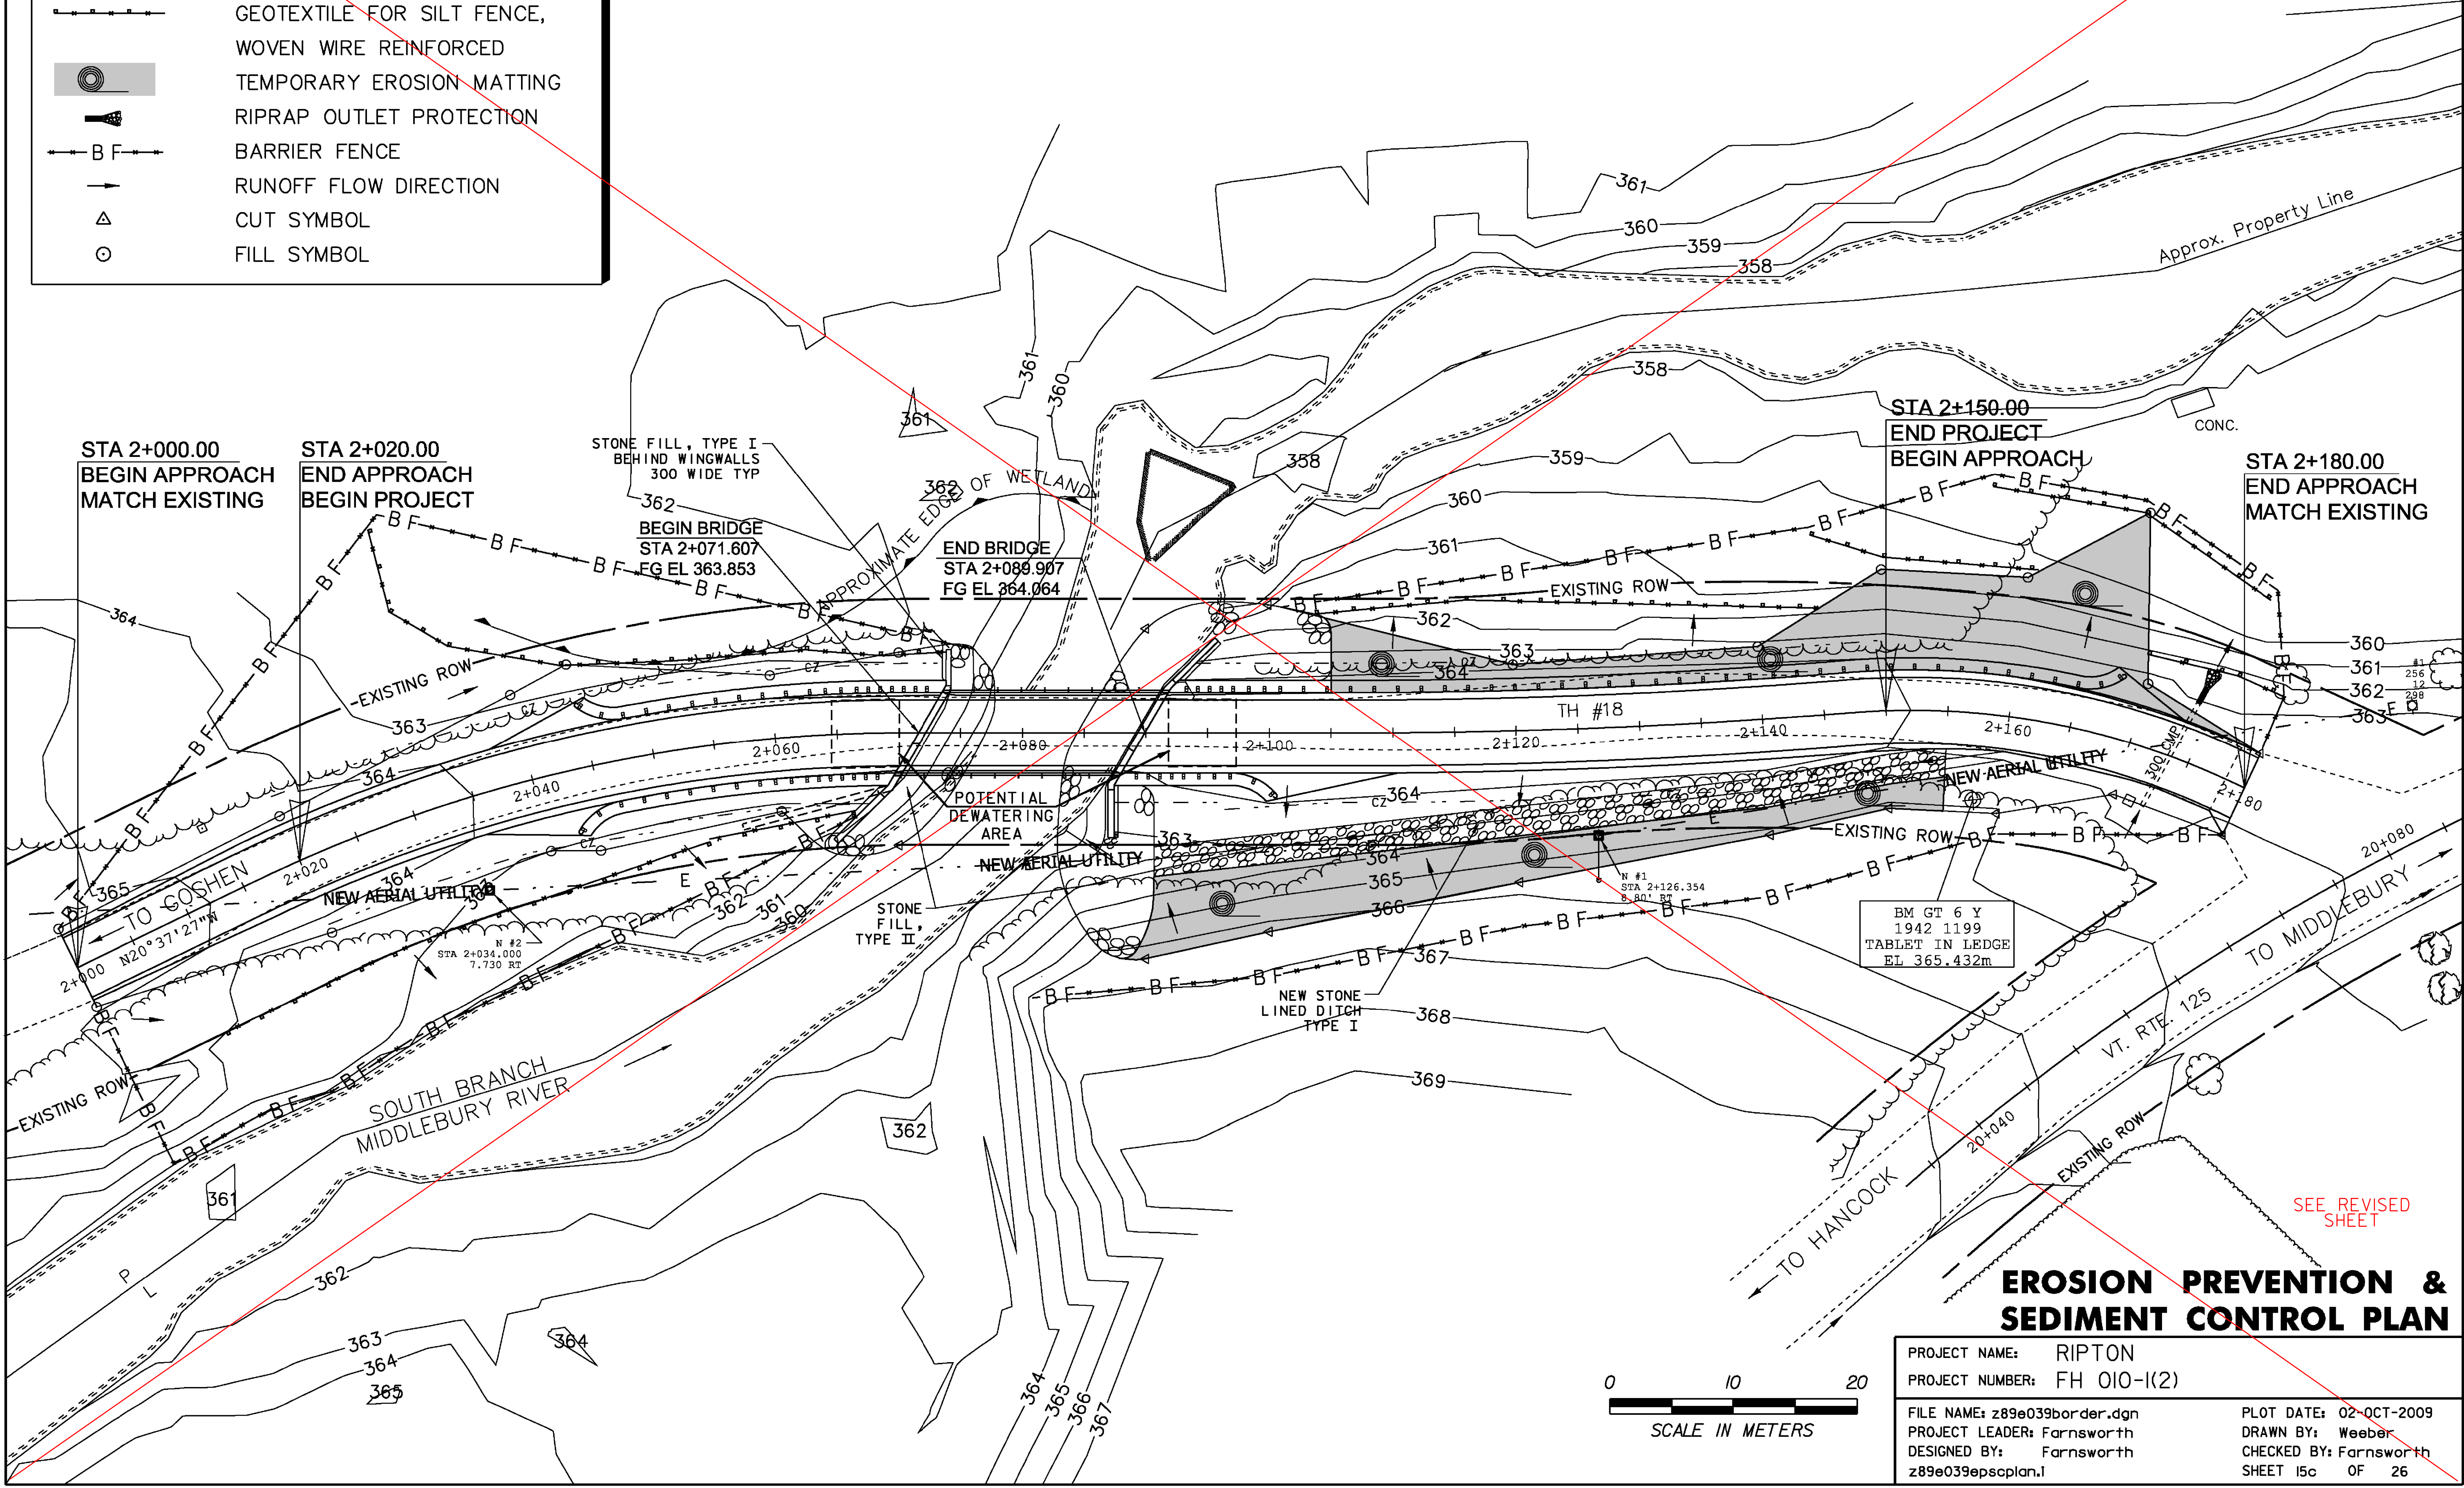


**EROSION PREVENTION & SEDIMENT CONTROL LEGEND**

|         |   |
|---------|---|
| BsE     | SOIL TYPE   |
| ---     | SOIL BOUNDARY                                       |
| —+—+—+— | GEOTEXTILE FOR SILT FENCE,<br>WOVEN WIRE REINFORCED |
| ⊙       | TEMPORARY EROSION MATTING                           |
| ⊠       | RIPRAP OUTLET PROTECTION                            |
| —BF—    | BARRIER FENCE                                       |
| →       | RUNOFF FLOW DIRECTION                               |
| △       | CUT SYMBOL  |
| ○       | FILL SYMBOL   |

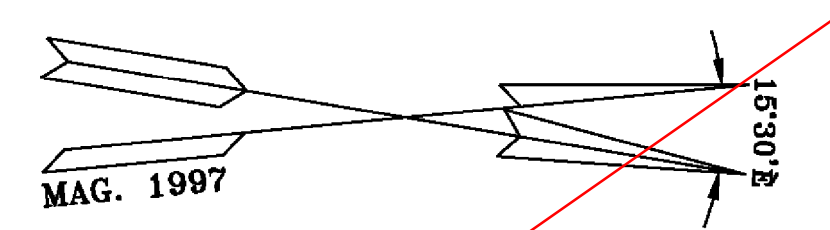

BM GT 6 Y  
1942 1199  
TABLET IN LEDGE  
EL 365.432m

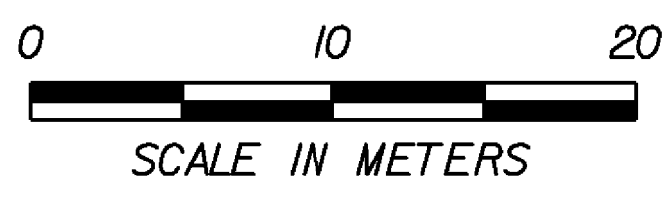

**EROSION PREVENTION & SEDIMENT CONTROL PLAN**

|                              |                             |
|------------------------------|-----------------------------|
| PROJECT NAME: RIPTON         | PROJECT NUMBER: FH 010-I(2) |
| FILE NAME: z89e039border.dgn | PLOT DATE: 02-OCT-2009      |
| PROJECT LEADER: Farnsworth   | DRAWN BY: Weeber            |
| DESIGNED BY: Farnsworth      | CHECKED BY: Farnsworth      |
| z89e039epsplan.l             | SHEET 15c OF 26             |

SEE REVISED SHEET